



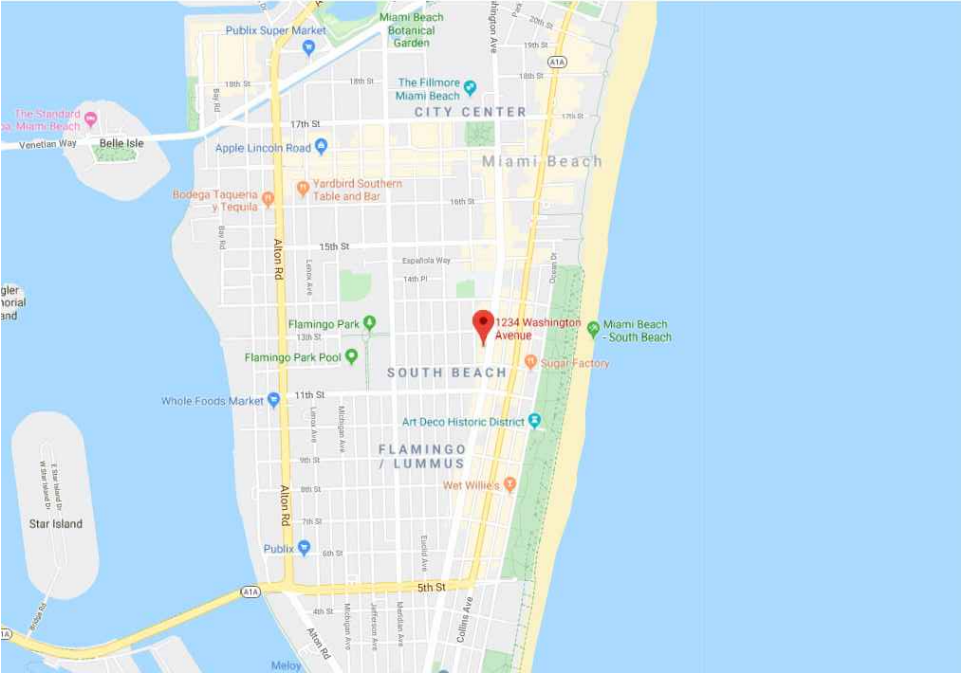

Area Map

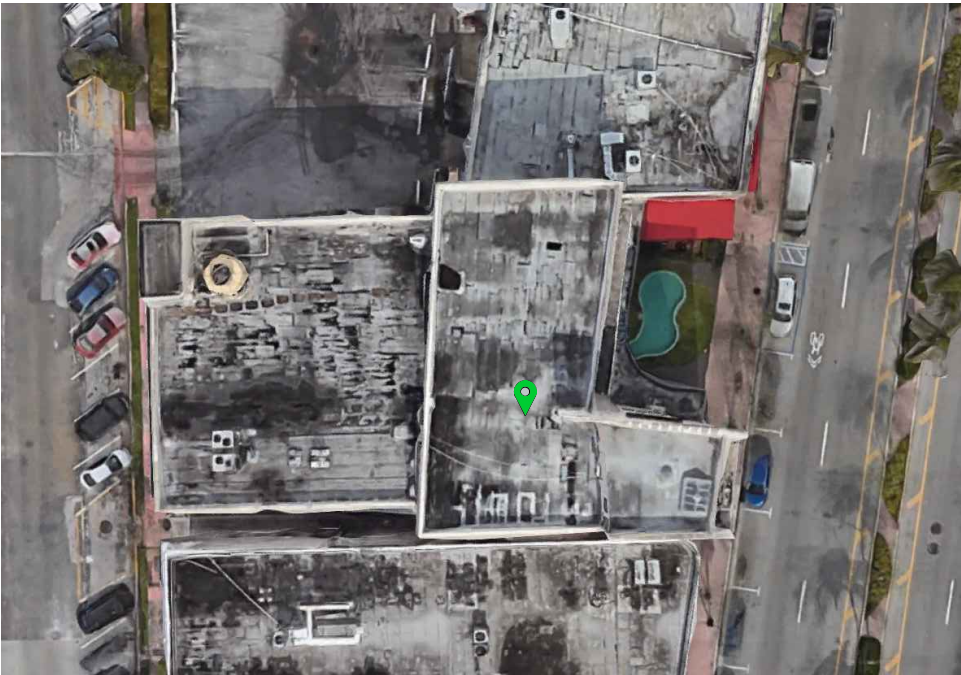

Aerial Photograph



Existing Site Photograph



360 Photo / As-Built Survey


Project Name

Address

Project Total S.F.

19,232

Arktech Solutions LLC
10804 Inside Loop
Orlando, FL 32825
P 214 606 5281
www.arktech.org

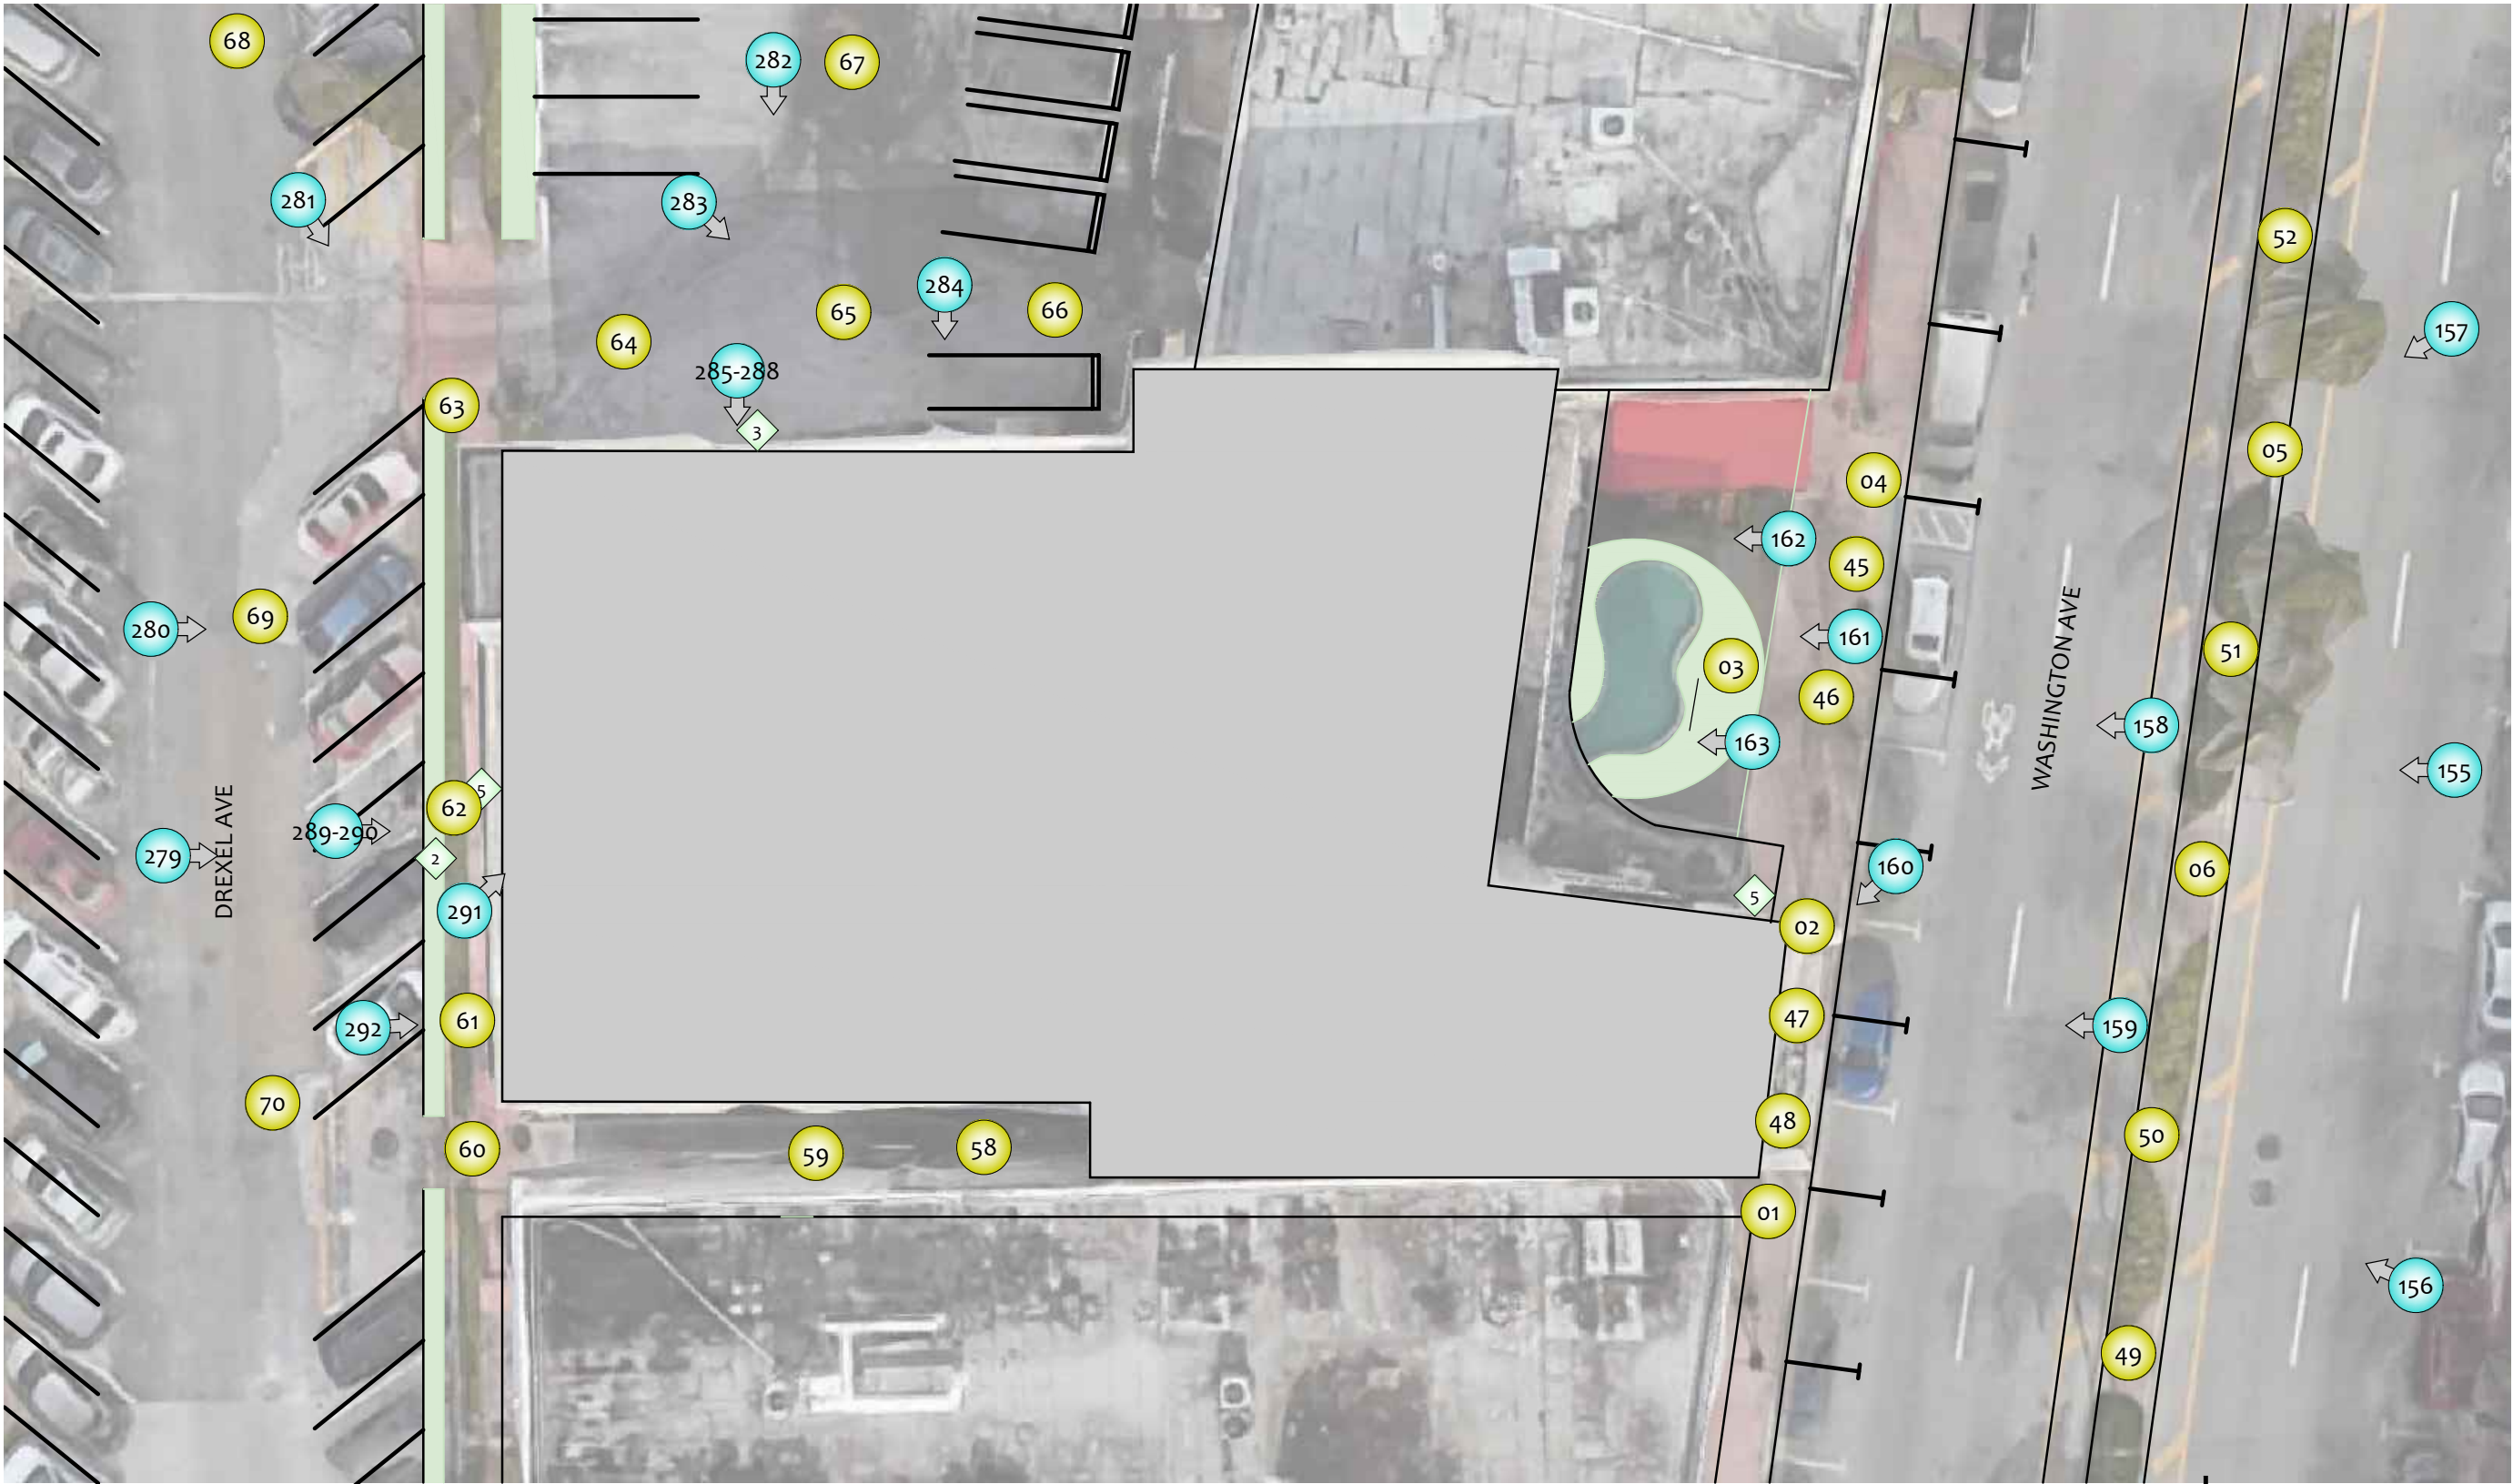

- 1 GAS MAIN & METER
 - 2 WATER MAIN & METER
 - 3 ELECTRIC MAIN & METER
 - 4 ELEC. TRANSFORMER
 - 5 FIRE DEPT. CONNECTION (RISER)
- *NOTE: NOT ALL KEYNOTES MAY BE USED. SEE DRAWING FOR APPLICABLE ITEMS.



ACCESSIBLE
PARKING STALL



ACCESSIBLE
PATH OF TRAVEL



SCALE: NTS

01 360 Vantage Point (Web Link)

01 Still Photo

01 Red Flag Notification

OWNER:

CLIENT:



Arktech Solutions LLC.
10804 Inside Loop
Orlando, FL 32825
tel: (407) 205-7787
www.ArktechSolution.com

FC NAME:	----
FCID:	N/A
FC ADDRESS:	----- ----- -----

FIELD SURVEYOR:	----
PROJECT DIRECTOR:	M.Vanegas
CHECKED BY:	----
DATE COMPLETED:	12-23-2019

PROJECT NUMBER:	----
SHEET:	SP01
DRAWING NUMBER:	02
OF:	41

DRAWING NAME:	SITE PLAN
---------------	-----------



ADJACENT
TENANT

OWNER:

CLIENT:




Arktech Solutions LLC.
10804 Inside Loop
Orlando, FL 32825
tel: (407) 205-7787
www.ArktechSolution.com

FC NAME:	----
FCID:	N/A
FC ADDRESS:	----- ----- -----

FIELD SURVEYOR:	----
PROJECT DIRECTOR:	M.Vanegas
CHECKED BY:	----
DATE COMPLETED:	12-23-2019

PROJECT NUMBER:	----
SHEET:	A001.1
DRAWING NUMBER:	03
OF:	41

DRAWING NAME:
360 PHOTO PLAN 1st FL


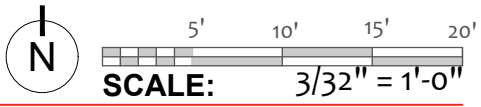


SCALE: 3/32" = 1'-0"

01 360 Vantage
Point (Web Link)

01 Still Photo

01 Red Flag
Notification

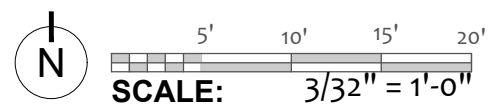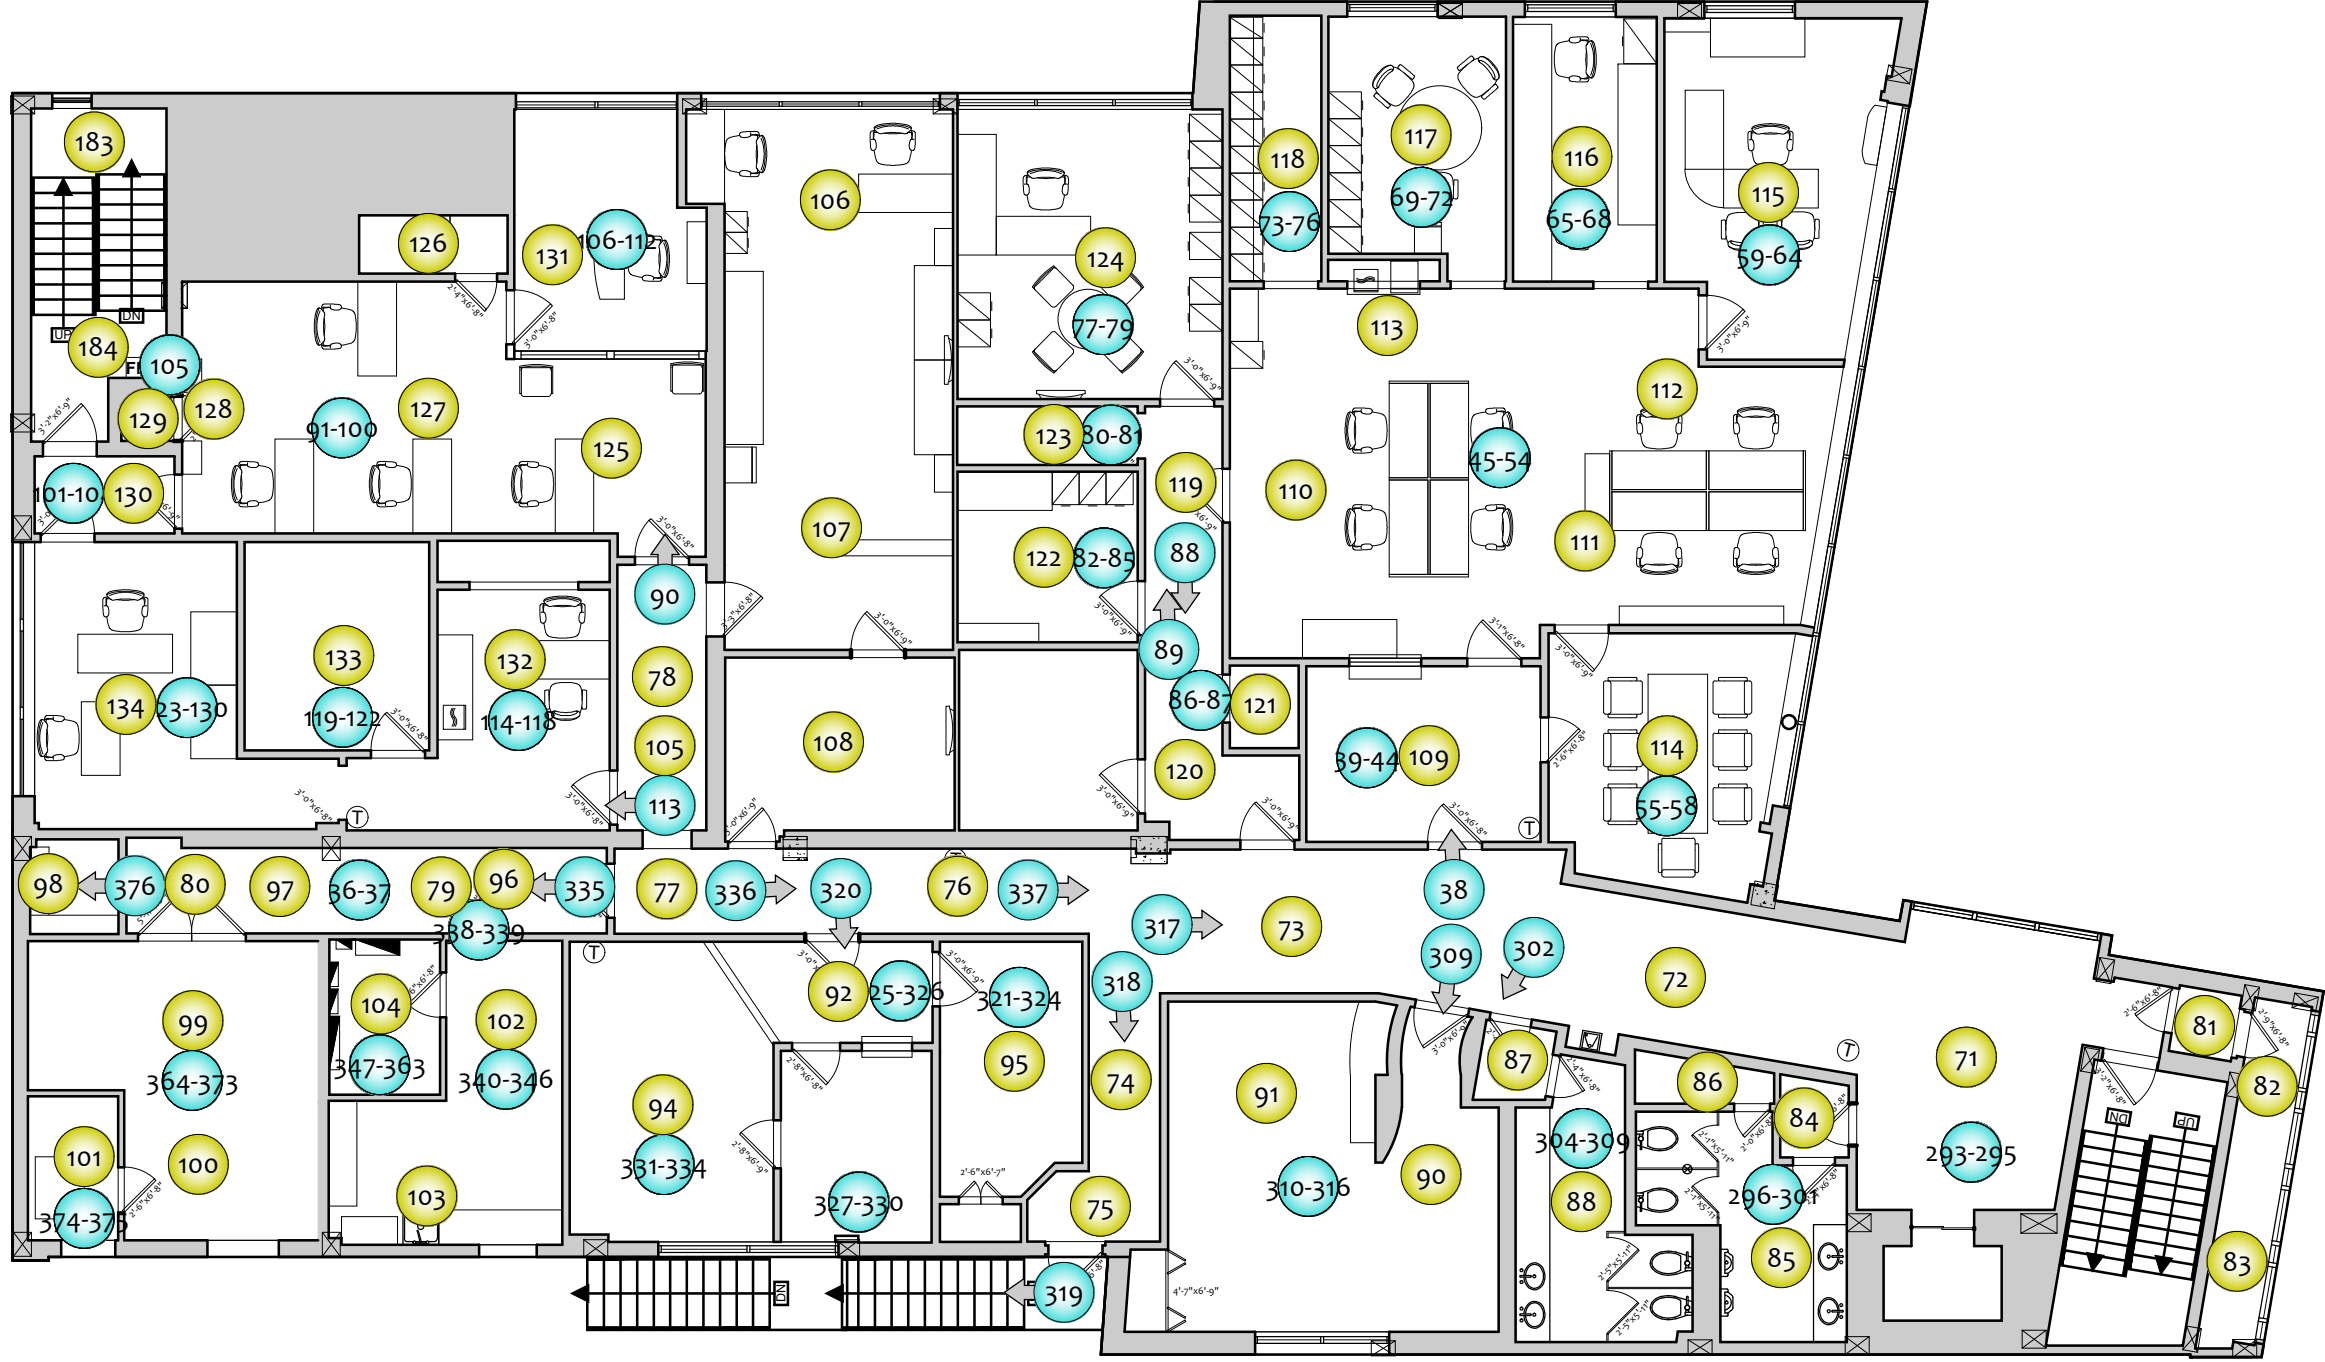

- 01 360 Vantage Point (Web Link)
- 01 Still Photo
- 01 Red Flag Notification

OWNER:

CLIENT:



Arktech Solutions LLC.
10804 Inside Loop
Orlando, FL 32825
tel: (407) 205-7787
www.ArktechSolution.com

FC NAME:	----
FCID:	N/A
FC ADDRESS:	----- ----- -----

FIELD SURVEYOR:	----
PROJECT DIRECTOR:	M.Vanegas
CHECKED BY:	----
DATE COMPLETED:	12-23-2019

PROJECT NUMBER:	----
SHEET:	A001.2
DRAWING NUMBER:	04
OF:	41

DRAWING NAME:
360 PHOTO PLAN 2nd FL

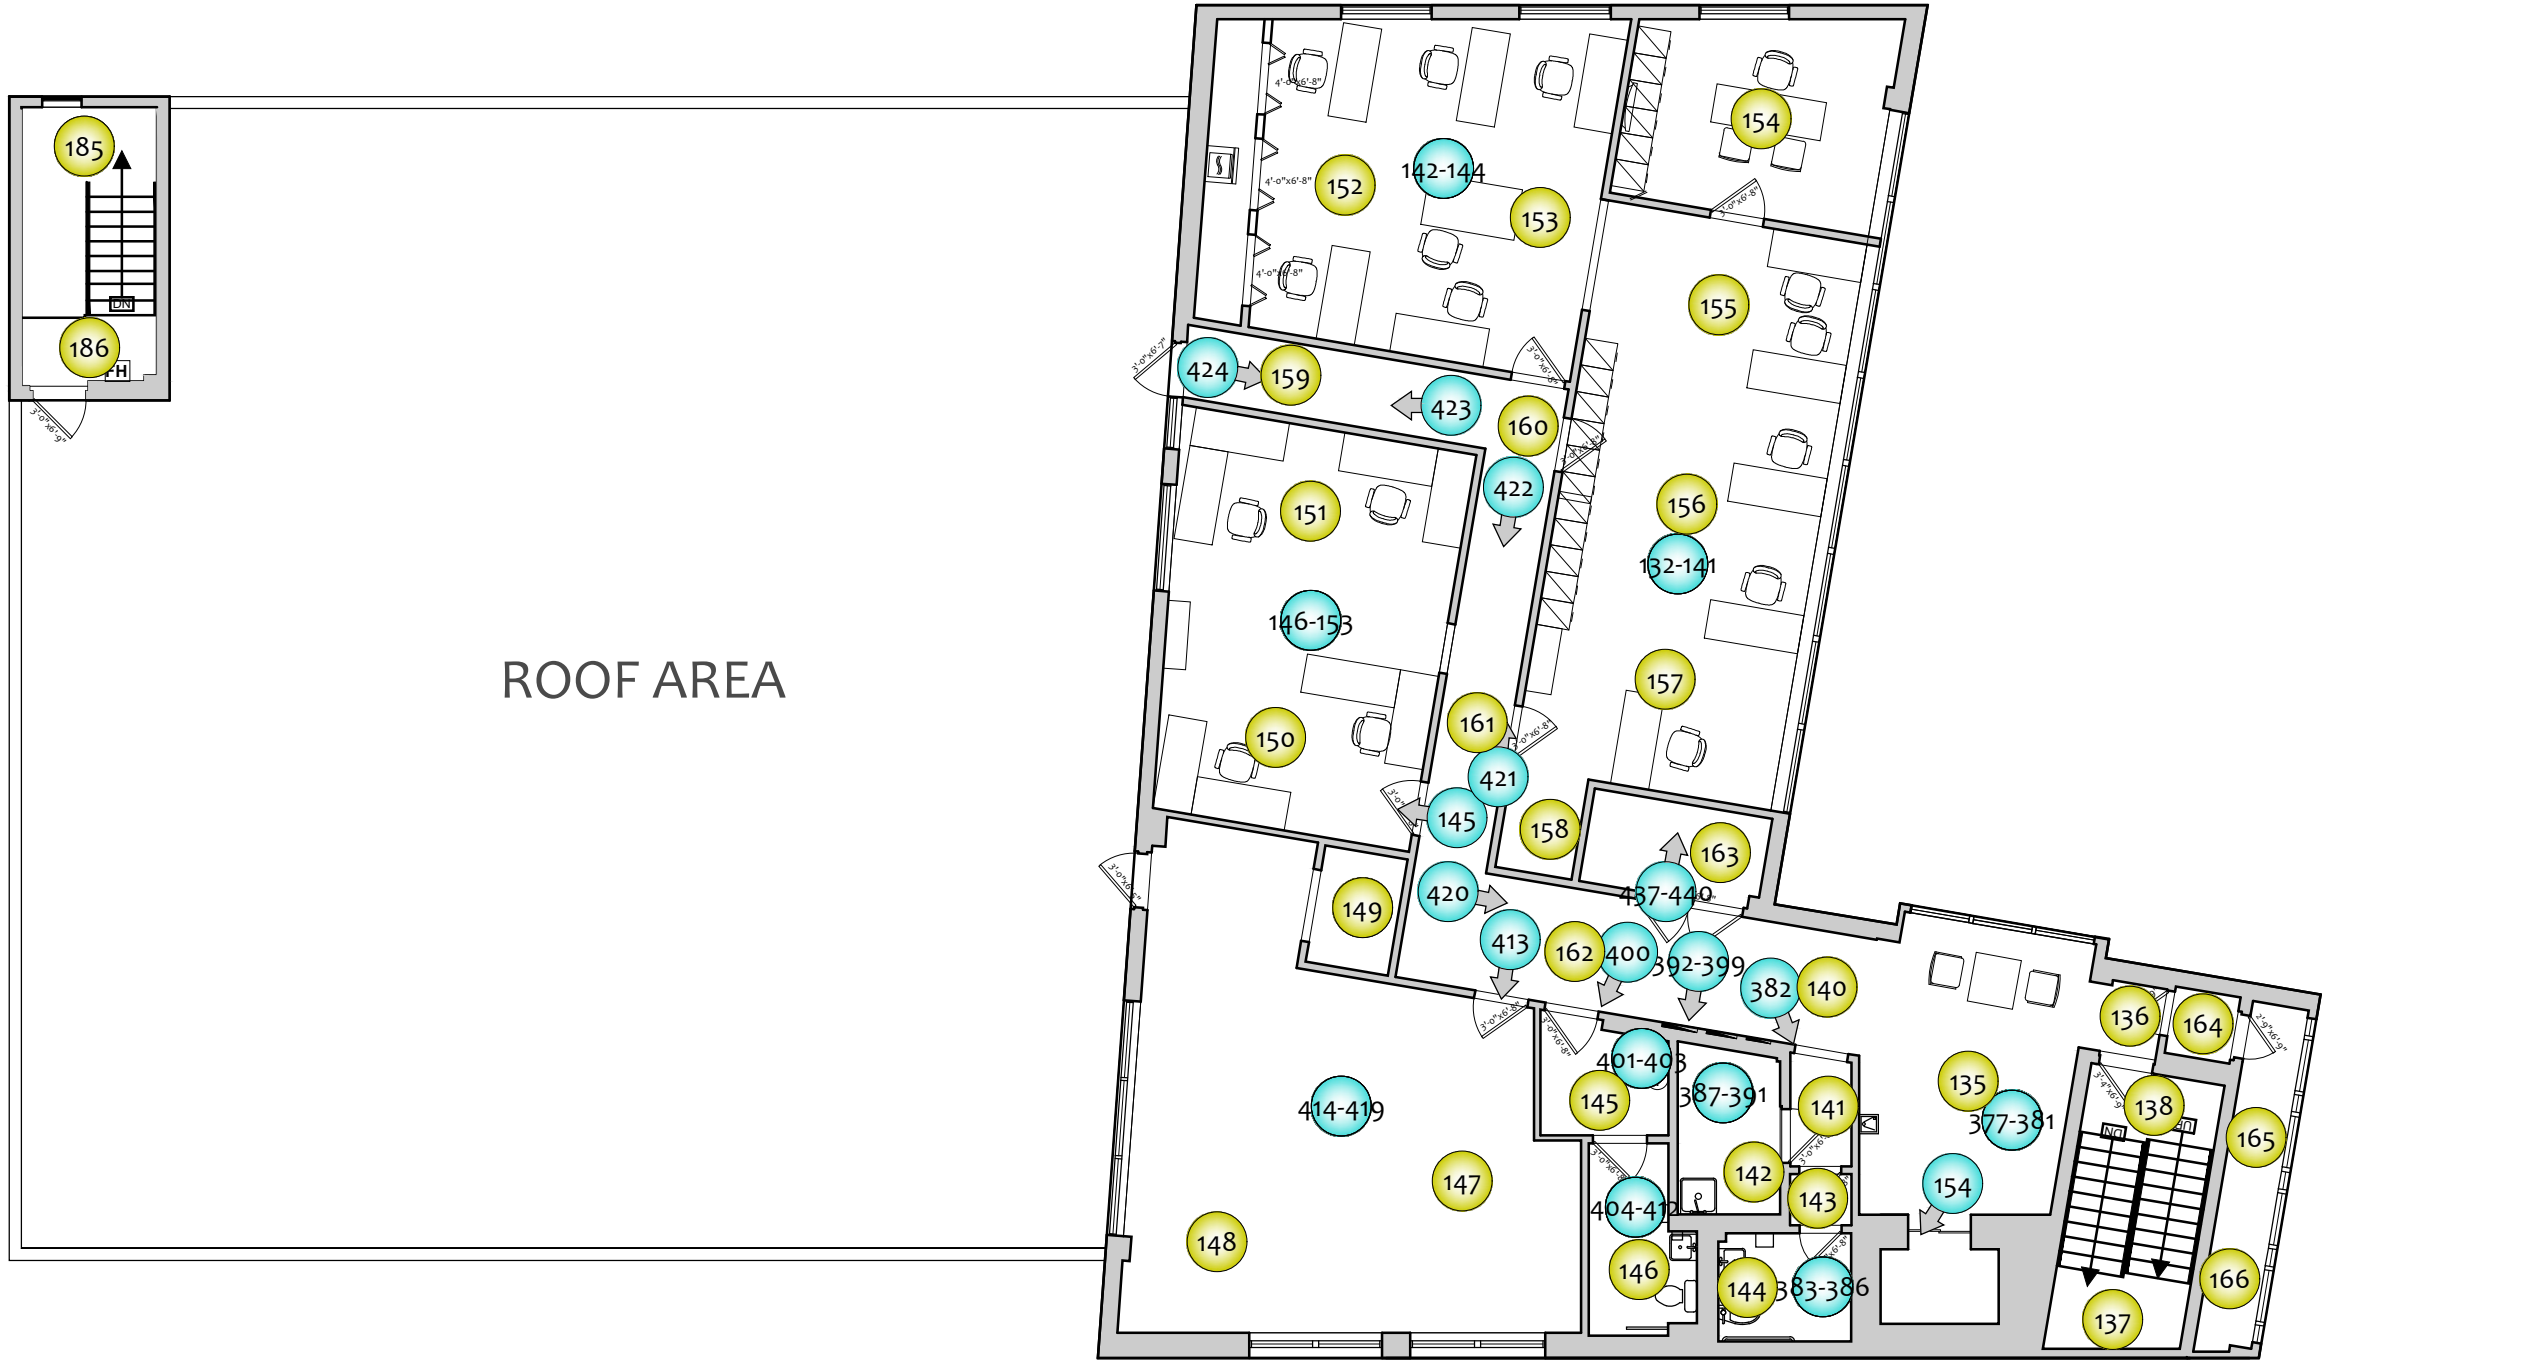

- 360 Vantage Point (Web Link)
- Still Photo
- Red Flag Notification


OWNER:

CLIENT:



Arktech Solutions LLC.
10804 Inside Loop
Orlando, FL 32825
tel: (407) 205-7787
www.ArktechSolution.com

FC NAME:		----
FCID:		N/A
FC ADDRESS:		----- ----- -----
FIELD SURVEYOR:		----
PROJECT DIRECTOR:		M.Vanegas
CHECKED BY:		----
DATE COMPLETED:		12-23-2019
PROJECT NUMBER:		----
SHEET:		A001.3
DRAWING NUMBER:	OF:	0541
DRAWING NAME: 360 PHOTO PLAN 3rd FL		

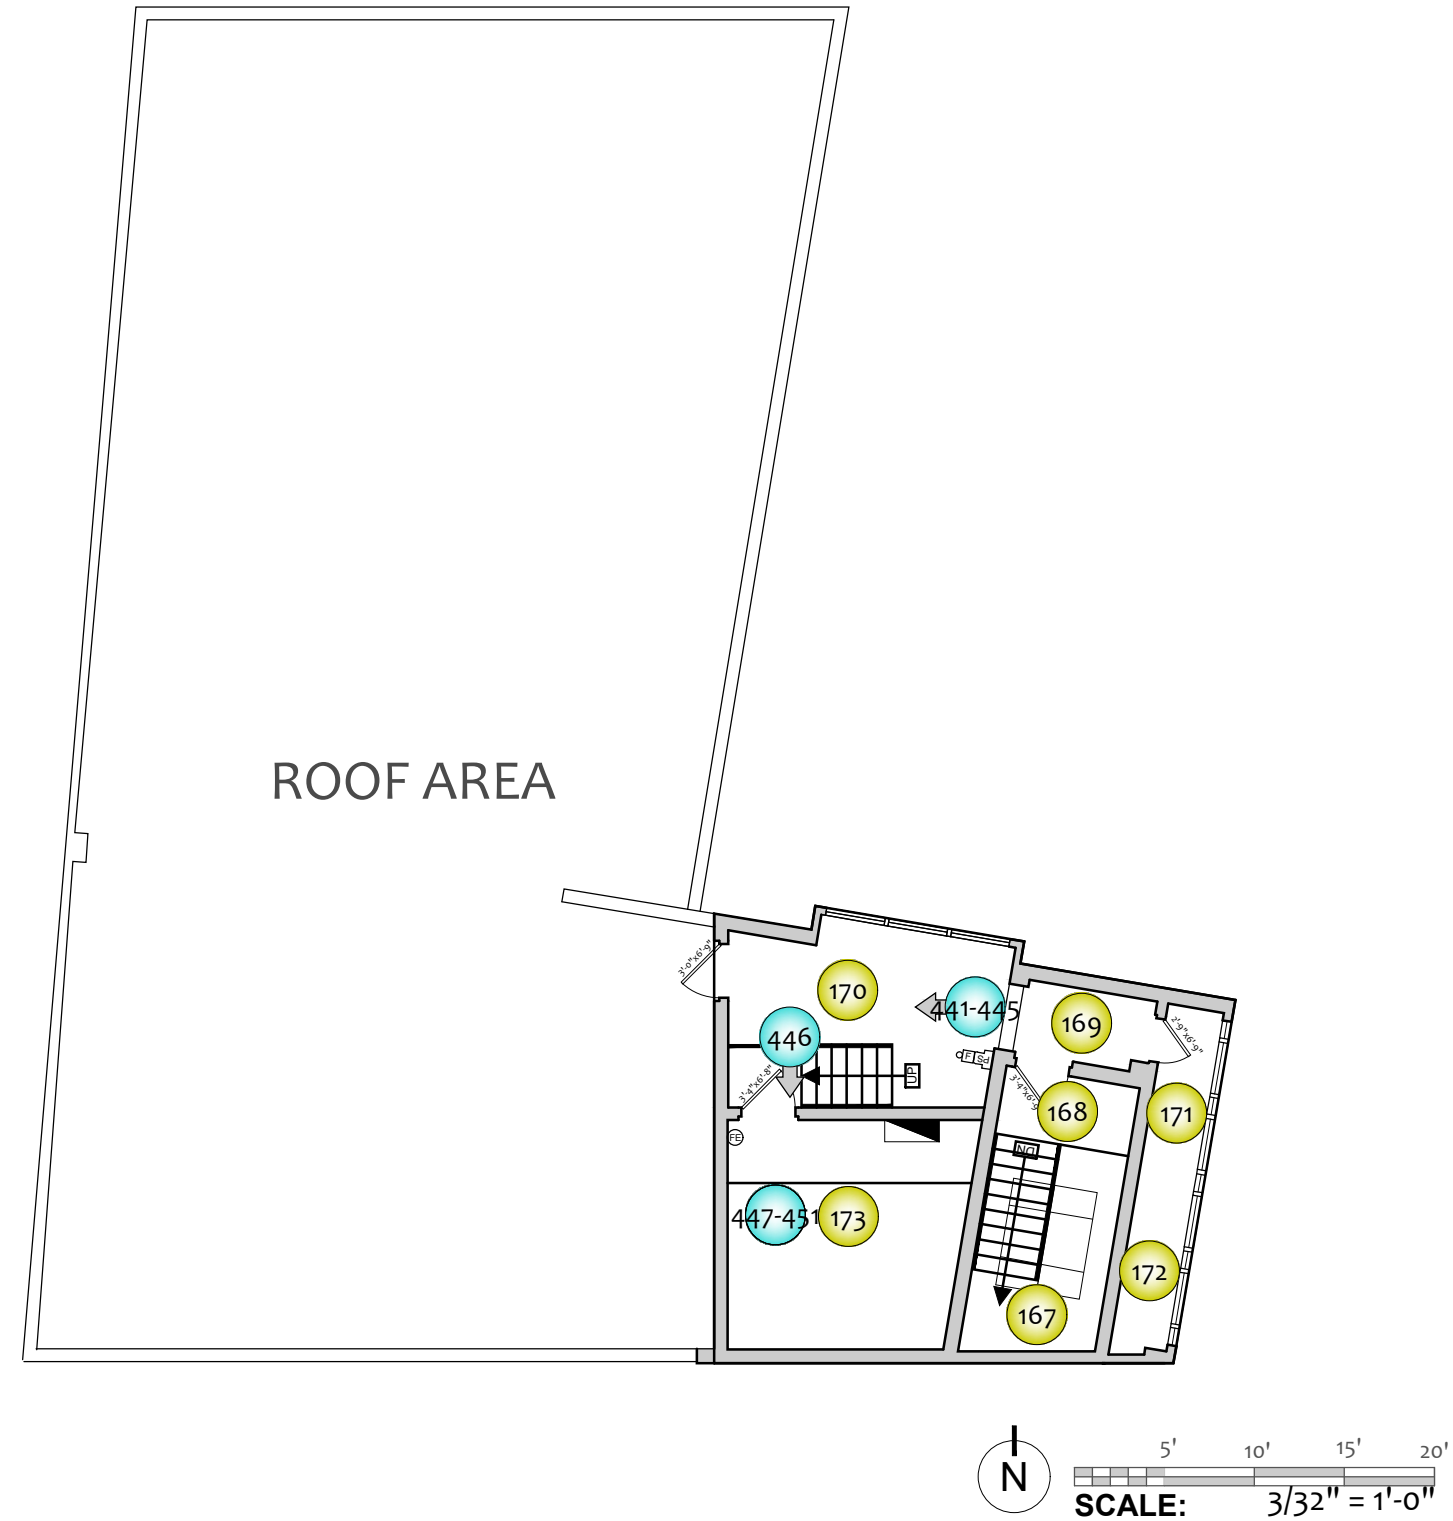

- 01 360 Vantage Point (Web Link)
- 01 Still Photo
- 01 Red Flag Notification

OWNER:

CLIENT:



Arktech Solutions LLC.
10804 Inside Loop
Orlando, FL 32825
tel: (407) 205-7787
www.ArktechSolution.com

FC NAME:	


FCID:	
N/A	
FC ADDRESS:	

FIELD SURVEYOR:	

PROJECT DIRECTOR:	
M.Vanegas	
CHECKED BY:	

DATE COMPLETED:	
12-23-2019	
PROJECT NUMBER:	

SHEET:	
A001.4	
DRAWING NUMBER:	OF:
06	41
DRAWING NAME:	
360 PHOTO PLAN P.H.	

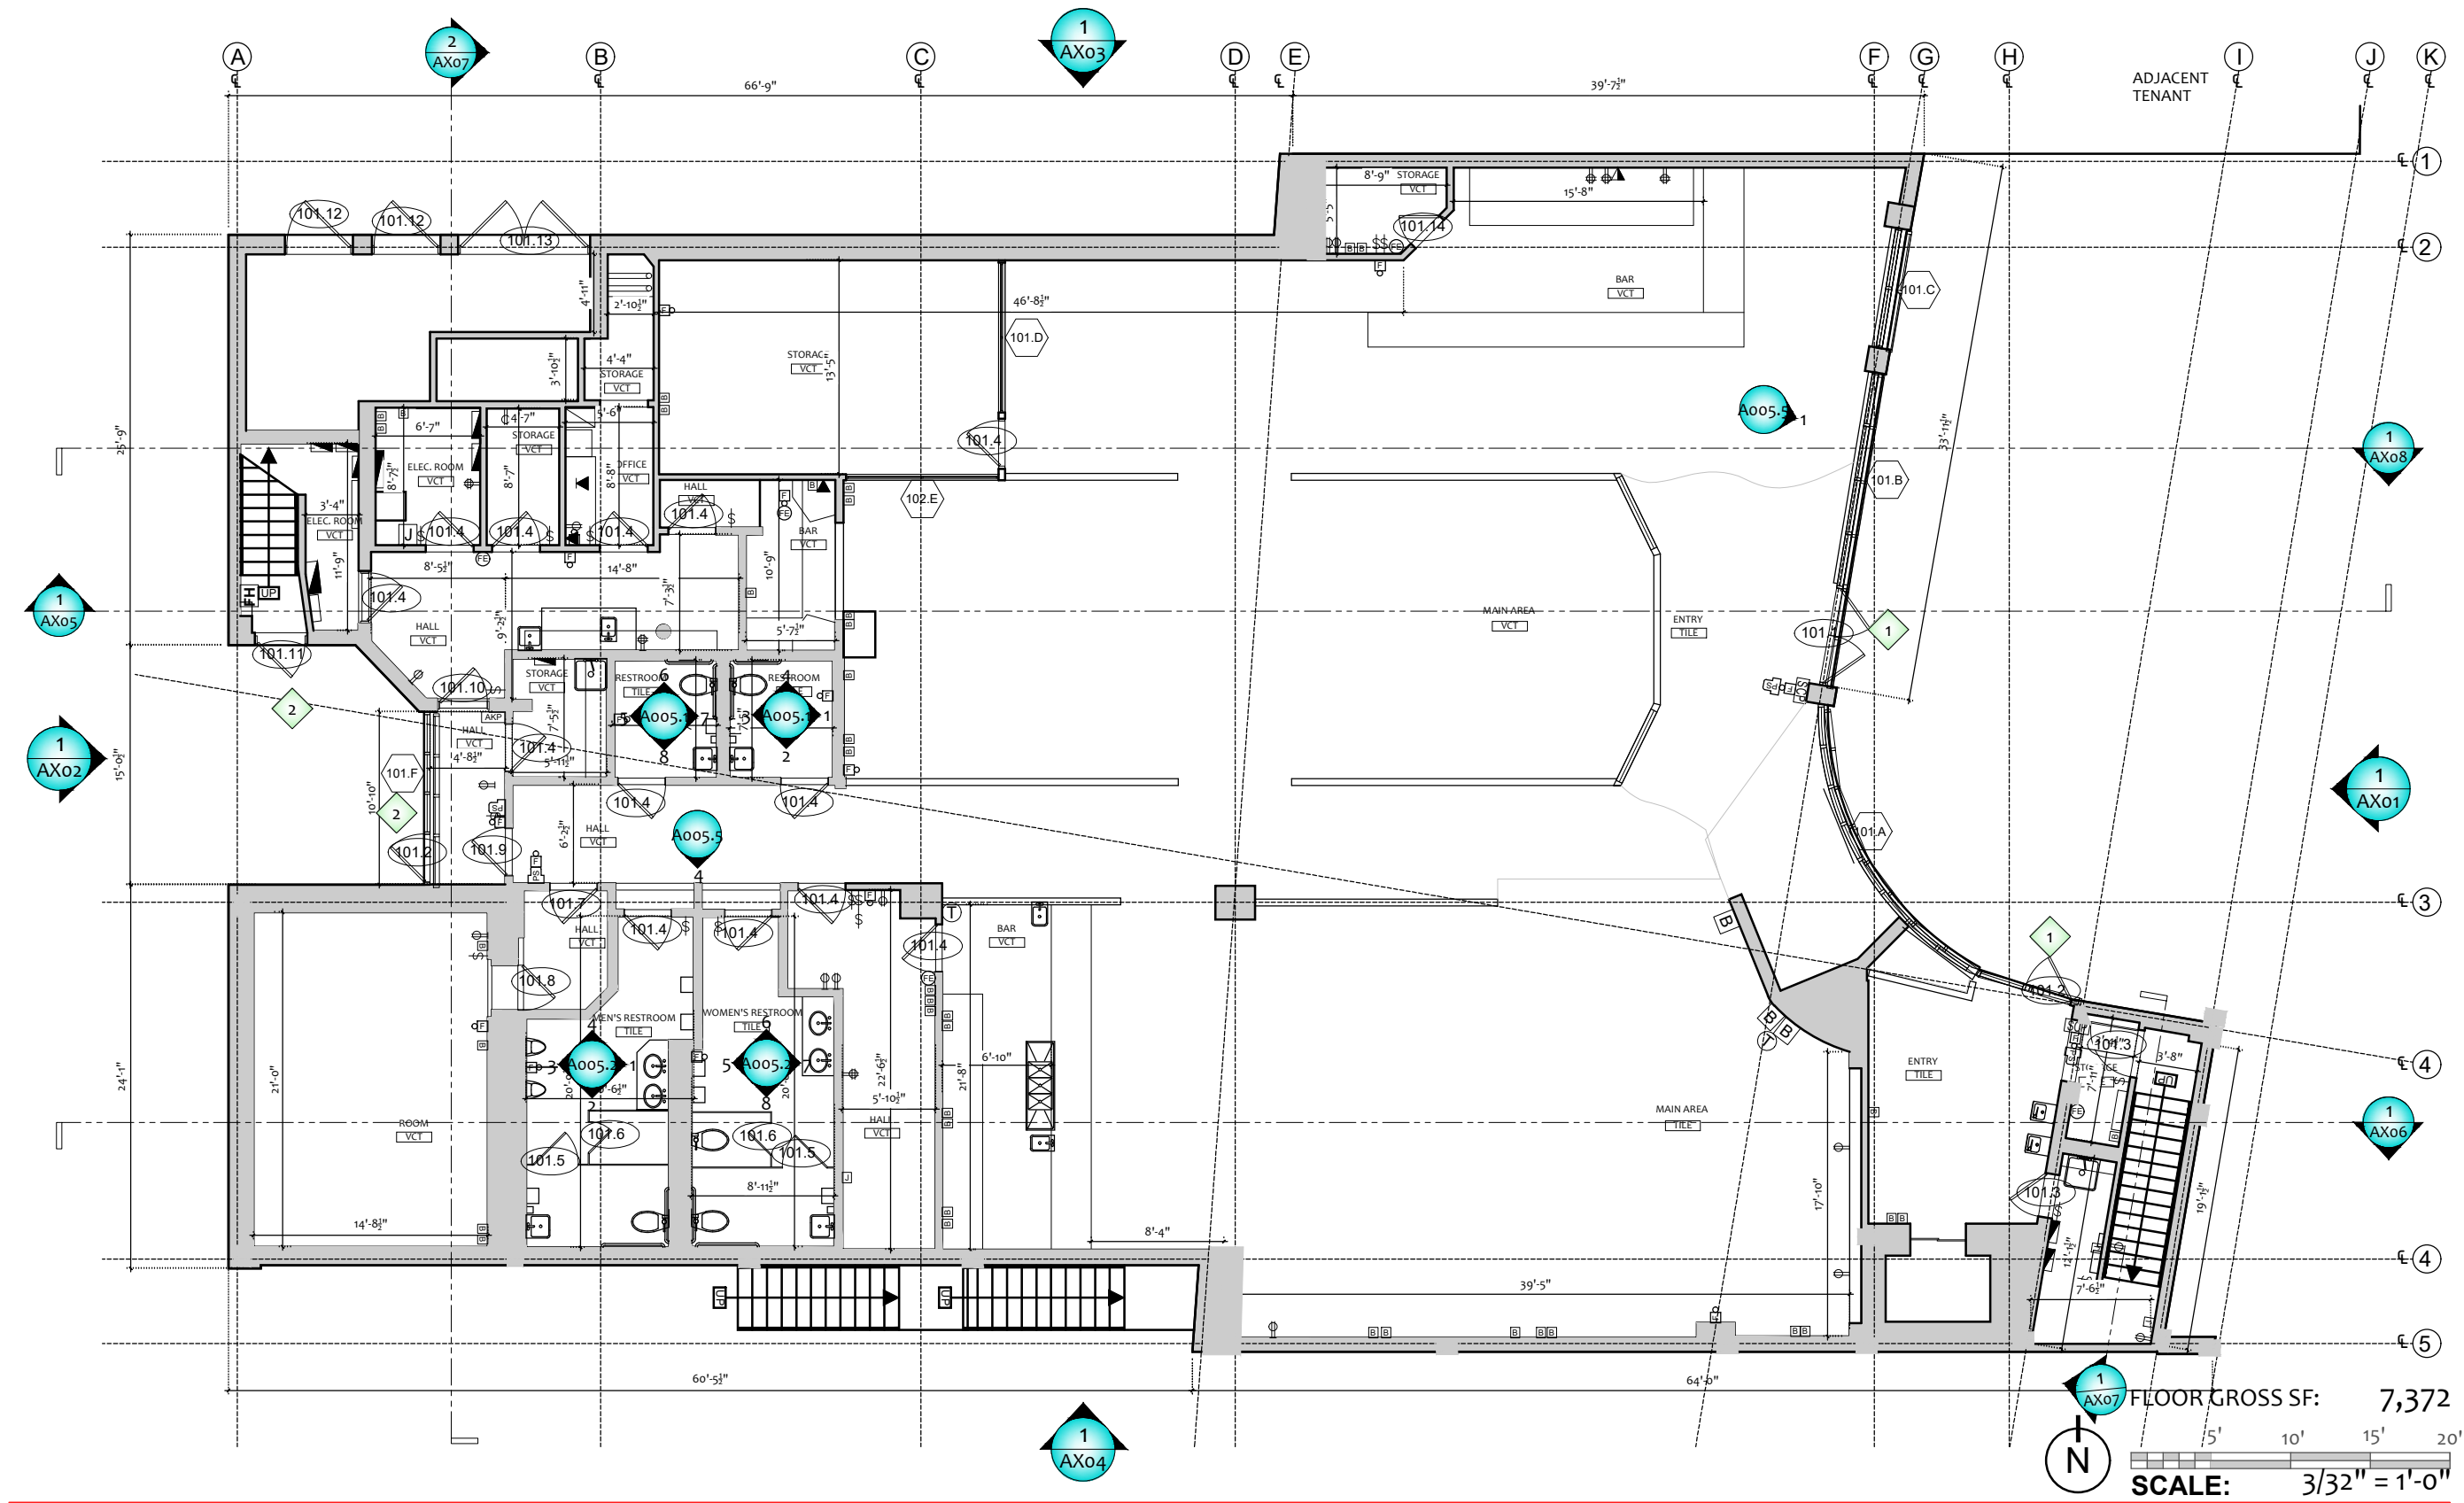

- 1 BUILDING ENTRANCE
- 2 EMERGENCY/ ALARMED EXIT DOOR
- 101.1 DOOR TAG - SEE DOOR SCHEDULE ON 1/A8.1
- 101.A WINDOW TAG - SEE WINDOW SCHEDULE ON 2/A8.1

- CPT CARPET
- TILE TILE
- WOOD WOOD
- S-LIN LINOLEUM SHEET
- MAT FLOOR MAT
- VCT VINYL COMP. TILE
- CONC CONCRETE

- ⊕ DUPLEX OUTLET
- ⊕ QUAD PLEX OUTLET
- ▼ DATA OUTLET
- ▼ DATA/ TELEPHONE
- ⊕ TELEPHONE
- ⊕ DUPLEX - FLOOR
- ⊕ QUADPLEX - FLOOR
- ▼ DATA - FLOOR
- ▼ DATA / TELE - FLOOR
- ⊕ THERMOSTAT
- ⊕ FIRE EXTINGUISHER
- ⊕ FIRE HOSE
- ⊕ LIGHT SWITCH

- SCP SEC. CONT'L. PANEL
- MONITOR
- AV AV OUTLET
- ELEC PANEL - RECESSED
- ELEC PANEL - SURFACE
- GENERATOR ELEC GENERATOR

- C CARD READER
- K KEYPAD LOCK
- P PULL STATION
- V FIRE CUT-OFF VALVE
- DRINKING FOUNTAIN

- VAULT ROOM NAME & FLOORING MATERIAL
- VCT
- COLUMN SIZE 6.5" X 6.5" @ 32'-0" O.C.
- COLUMN SIZE & FREQUENCY

- A005 INTERIOR ELEVATIONS
- 1 AX01 EXTERIOR ELEVATIONS
- 1 AX05 SECTIONS

OWNER:

CLIENT:




Arktech Solutions LLC.
10804 Inside Loop
Orlando, FL 32825
tel: (407) 205-7787
www.ArktechSolution.com

FC NAME:	----
FCID:	N/A
FC ADDRESS:	----

FIELD SURVEYOR:	----
PROJECT DIRECTOR:	M.Vanegas
CHECKED BY:	----
DATE COMPLETED:	12-23-2019

PROJECT NUMBER:	----
SHEET:	A002.1
DRAWING NUMBER:	07
OF:	41

DRAWING NAME:
1st FLOOR PLAN

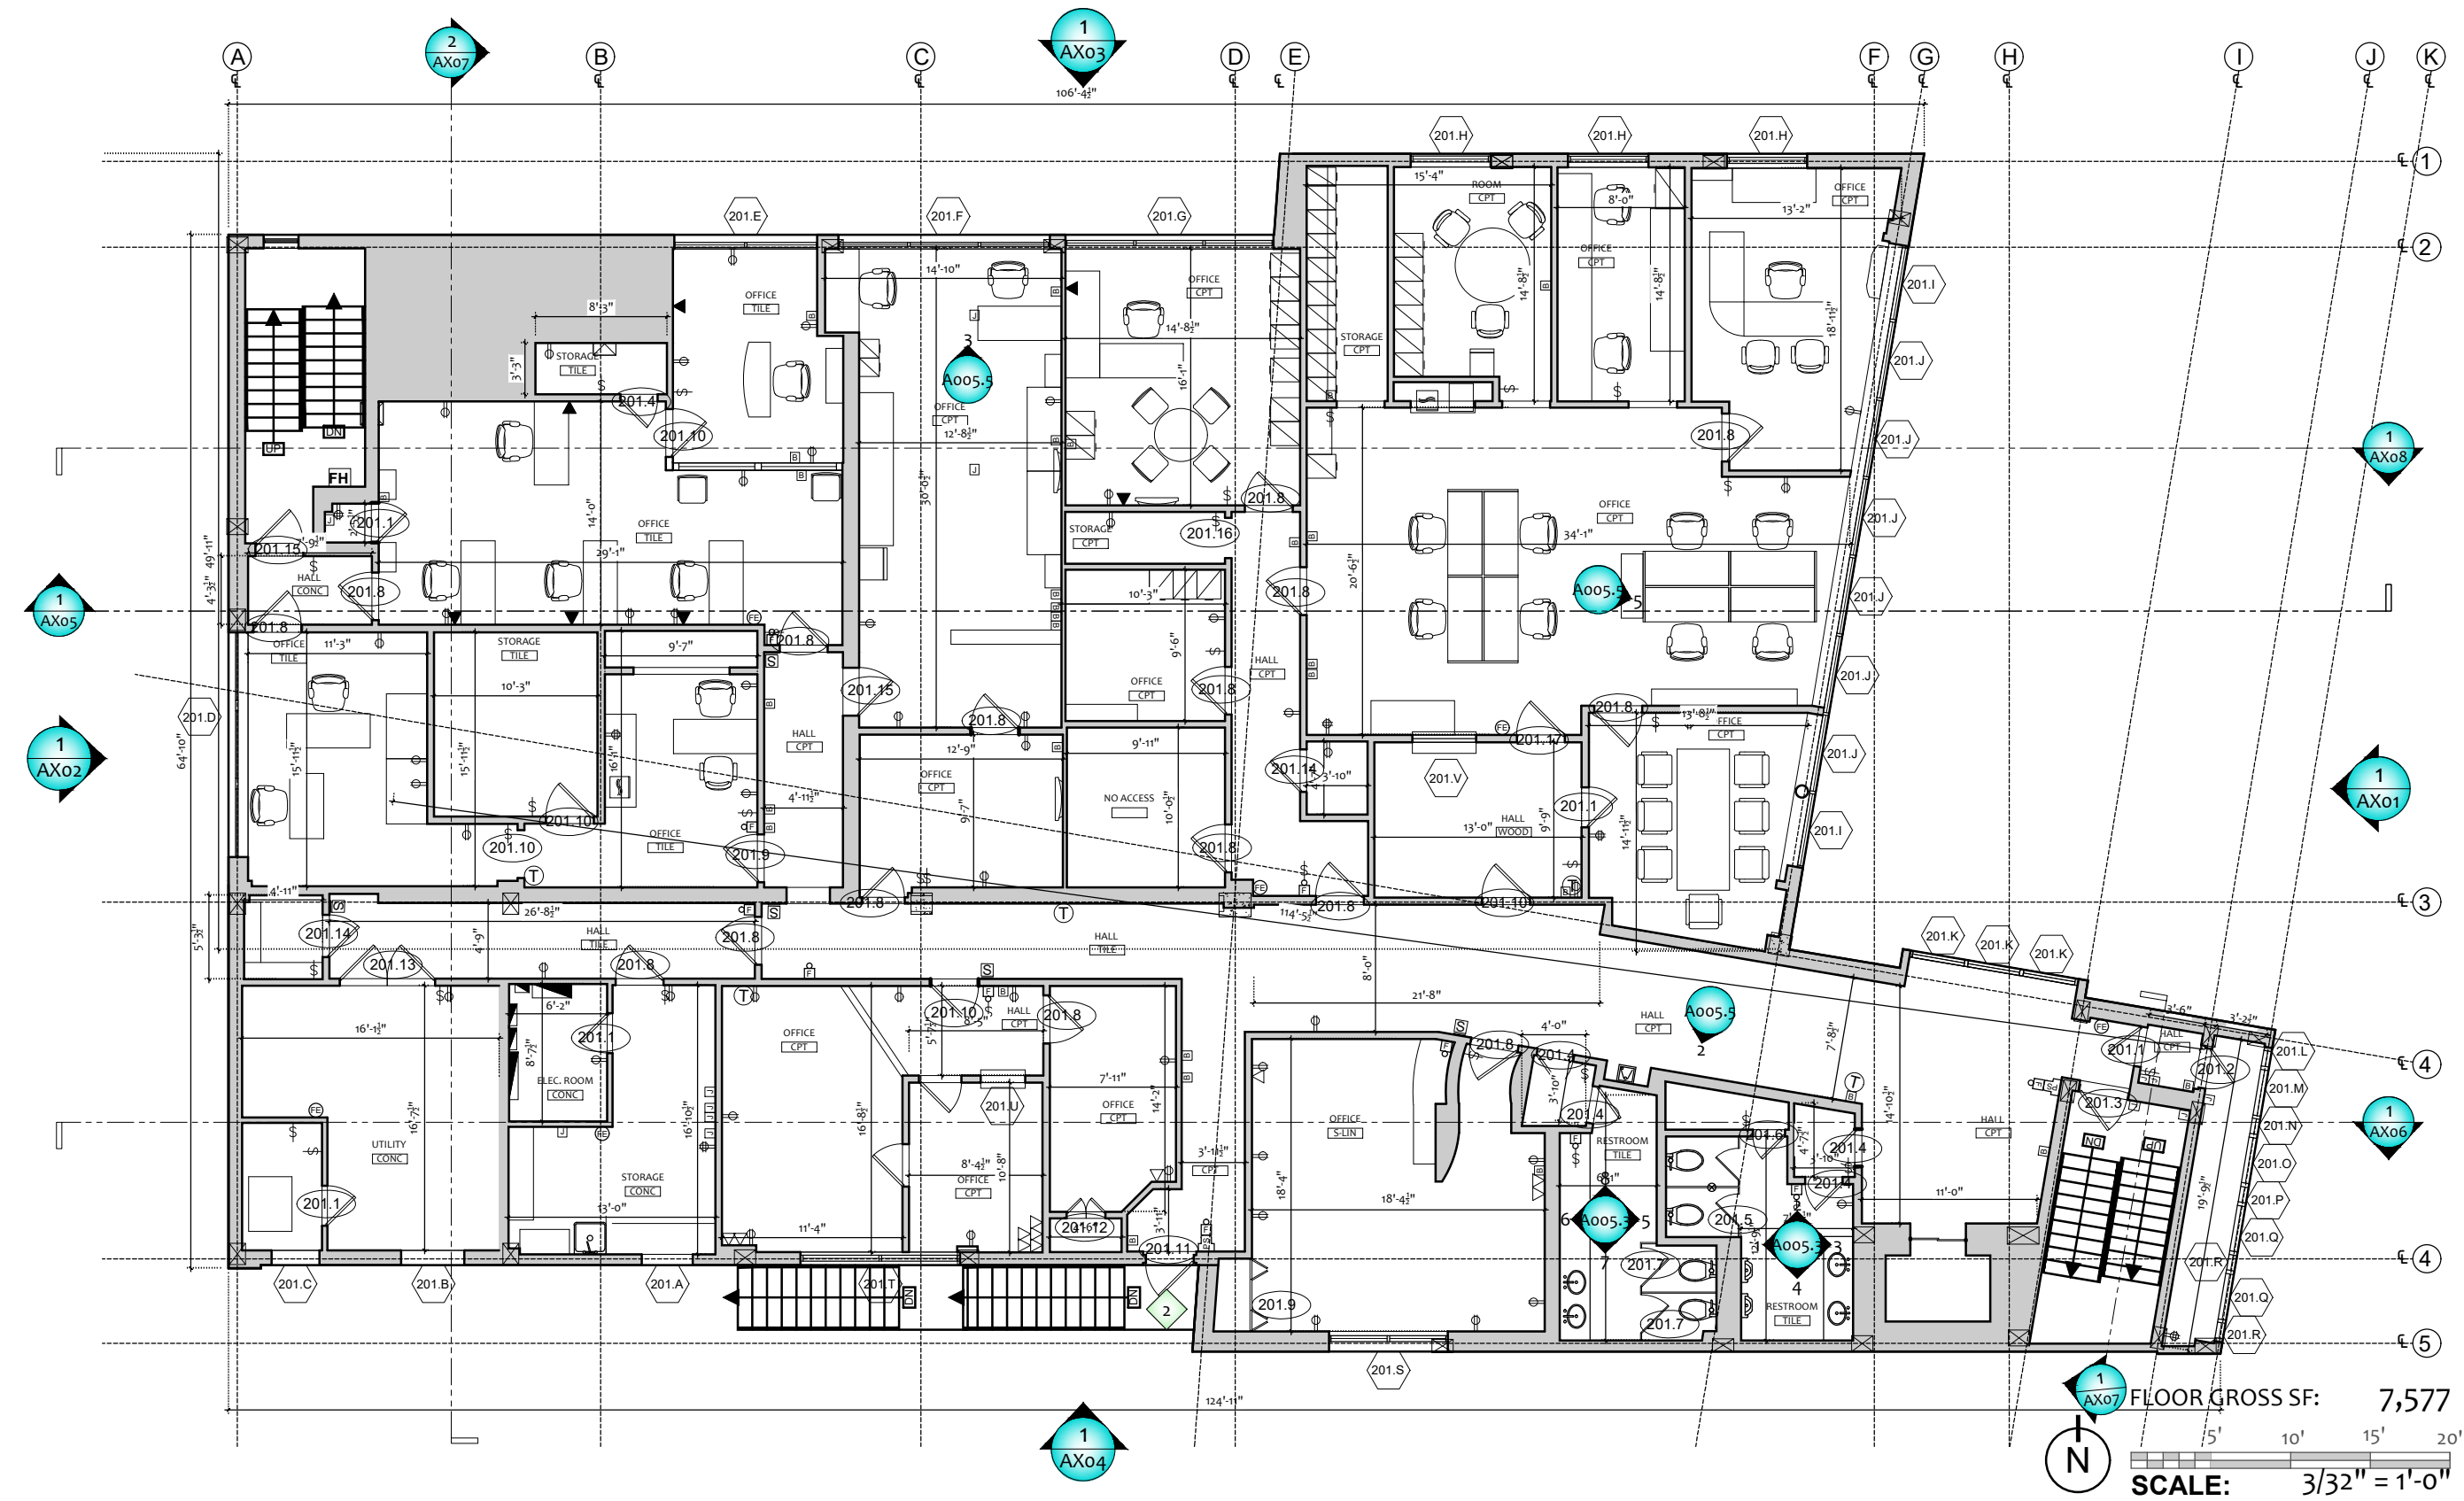

- 1 BUILDING ENTRANCE
- 2 EMERGENCY/ ALARMED EXIT DOOR
- 101.1 DOOR TAG - SEE DOOR SCHEDULE ON 1/A8.2-8.3
- 101.A WINDOW TAG - SEE WINDOW SCHEDULE ON 2/A8.2-8.3

- CPT CARPET
- TILE TILE
- WOOD WOOD
- S-LIN LINOLEUM SHEET
- MAT FLOOR MAT
- VCT VINYL COMP. TILE
- CONC CONCRETE

- ⊕ DUPLEX OUTLET
- ⊕ QUAD PLEX OUTLET
- ▼ DATA OUTLET
- ▼ DATA/ TELEPHONE
- ▽ TELEPHONE
- ⊕ DUPLEX - FLOOR
- ⊕ QUADPLEX - FLOOR
- ▼ DATA - FLOOR
- ▼ DATA / TELE - FLOOR
- ⊕ THERMOSTAT
- ⊕ FIRE EXTINGUISHER
- ⊕ FIRE HOSE
- ⊕ LIGHT SWITCH

- SCP SEC. CONT'L. PANEL
- MONITOR
- AV AV OUTLET
- ELEC PANEL - RECESSED
- ELEC PANEL - SURFACE
- GENERATOR ELEC GENERATOR
- C CARD READER
- K KEYPAD LOCK
- P PULL STATION
- V FIRE CUT-OFF VALVE
- DRINKING FOUNTAIN

- VAULT
- VCT ROOM NAME & FLOORING MATERIAL
- COLUMN SIZE 6.5" X 6.5" @ 32'-0" O.C.
- COLUMN SIZE & FREQUENCY
- A005 INTERIOR ELEVATIONS
- 1 AX01 EXTERIOR ELEVATIONS
- 1 AX01 SECTIONS

OWNER:

CLIENT:


Arktech Solutions LLC.
10804 Inside Loop
Orlando, FL 32825
tel: (407) 205-7787
www.ArktechSolution.com

FC NAME: ---

FCID: N/A

FC ADDRESS: ---

FIELD SURVEYOR: ---

PROJECT DIRECTOR: M.Vanegas

CHECKED BY: ---


DATE COMPLETED: 12-23-2019

PROJECT NUMBER: ---

SHEET: A002.2

DRAWING NUMBER: 08 OF: 41

DRAWING NAME: 2nd FLOOR PLAN

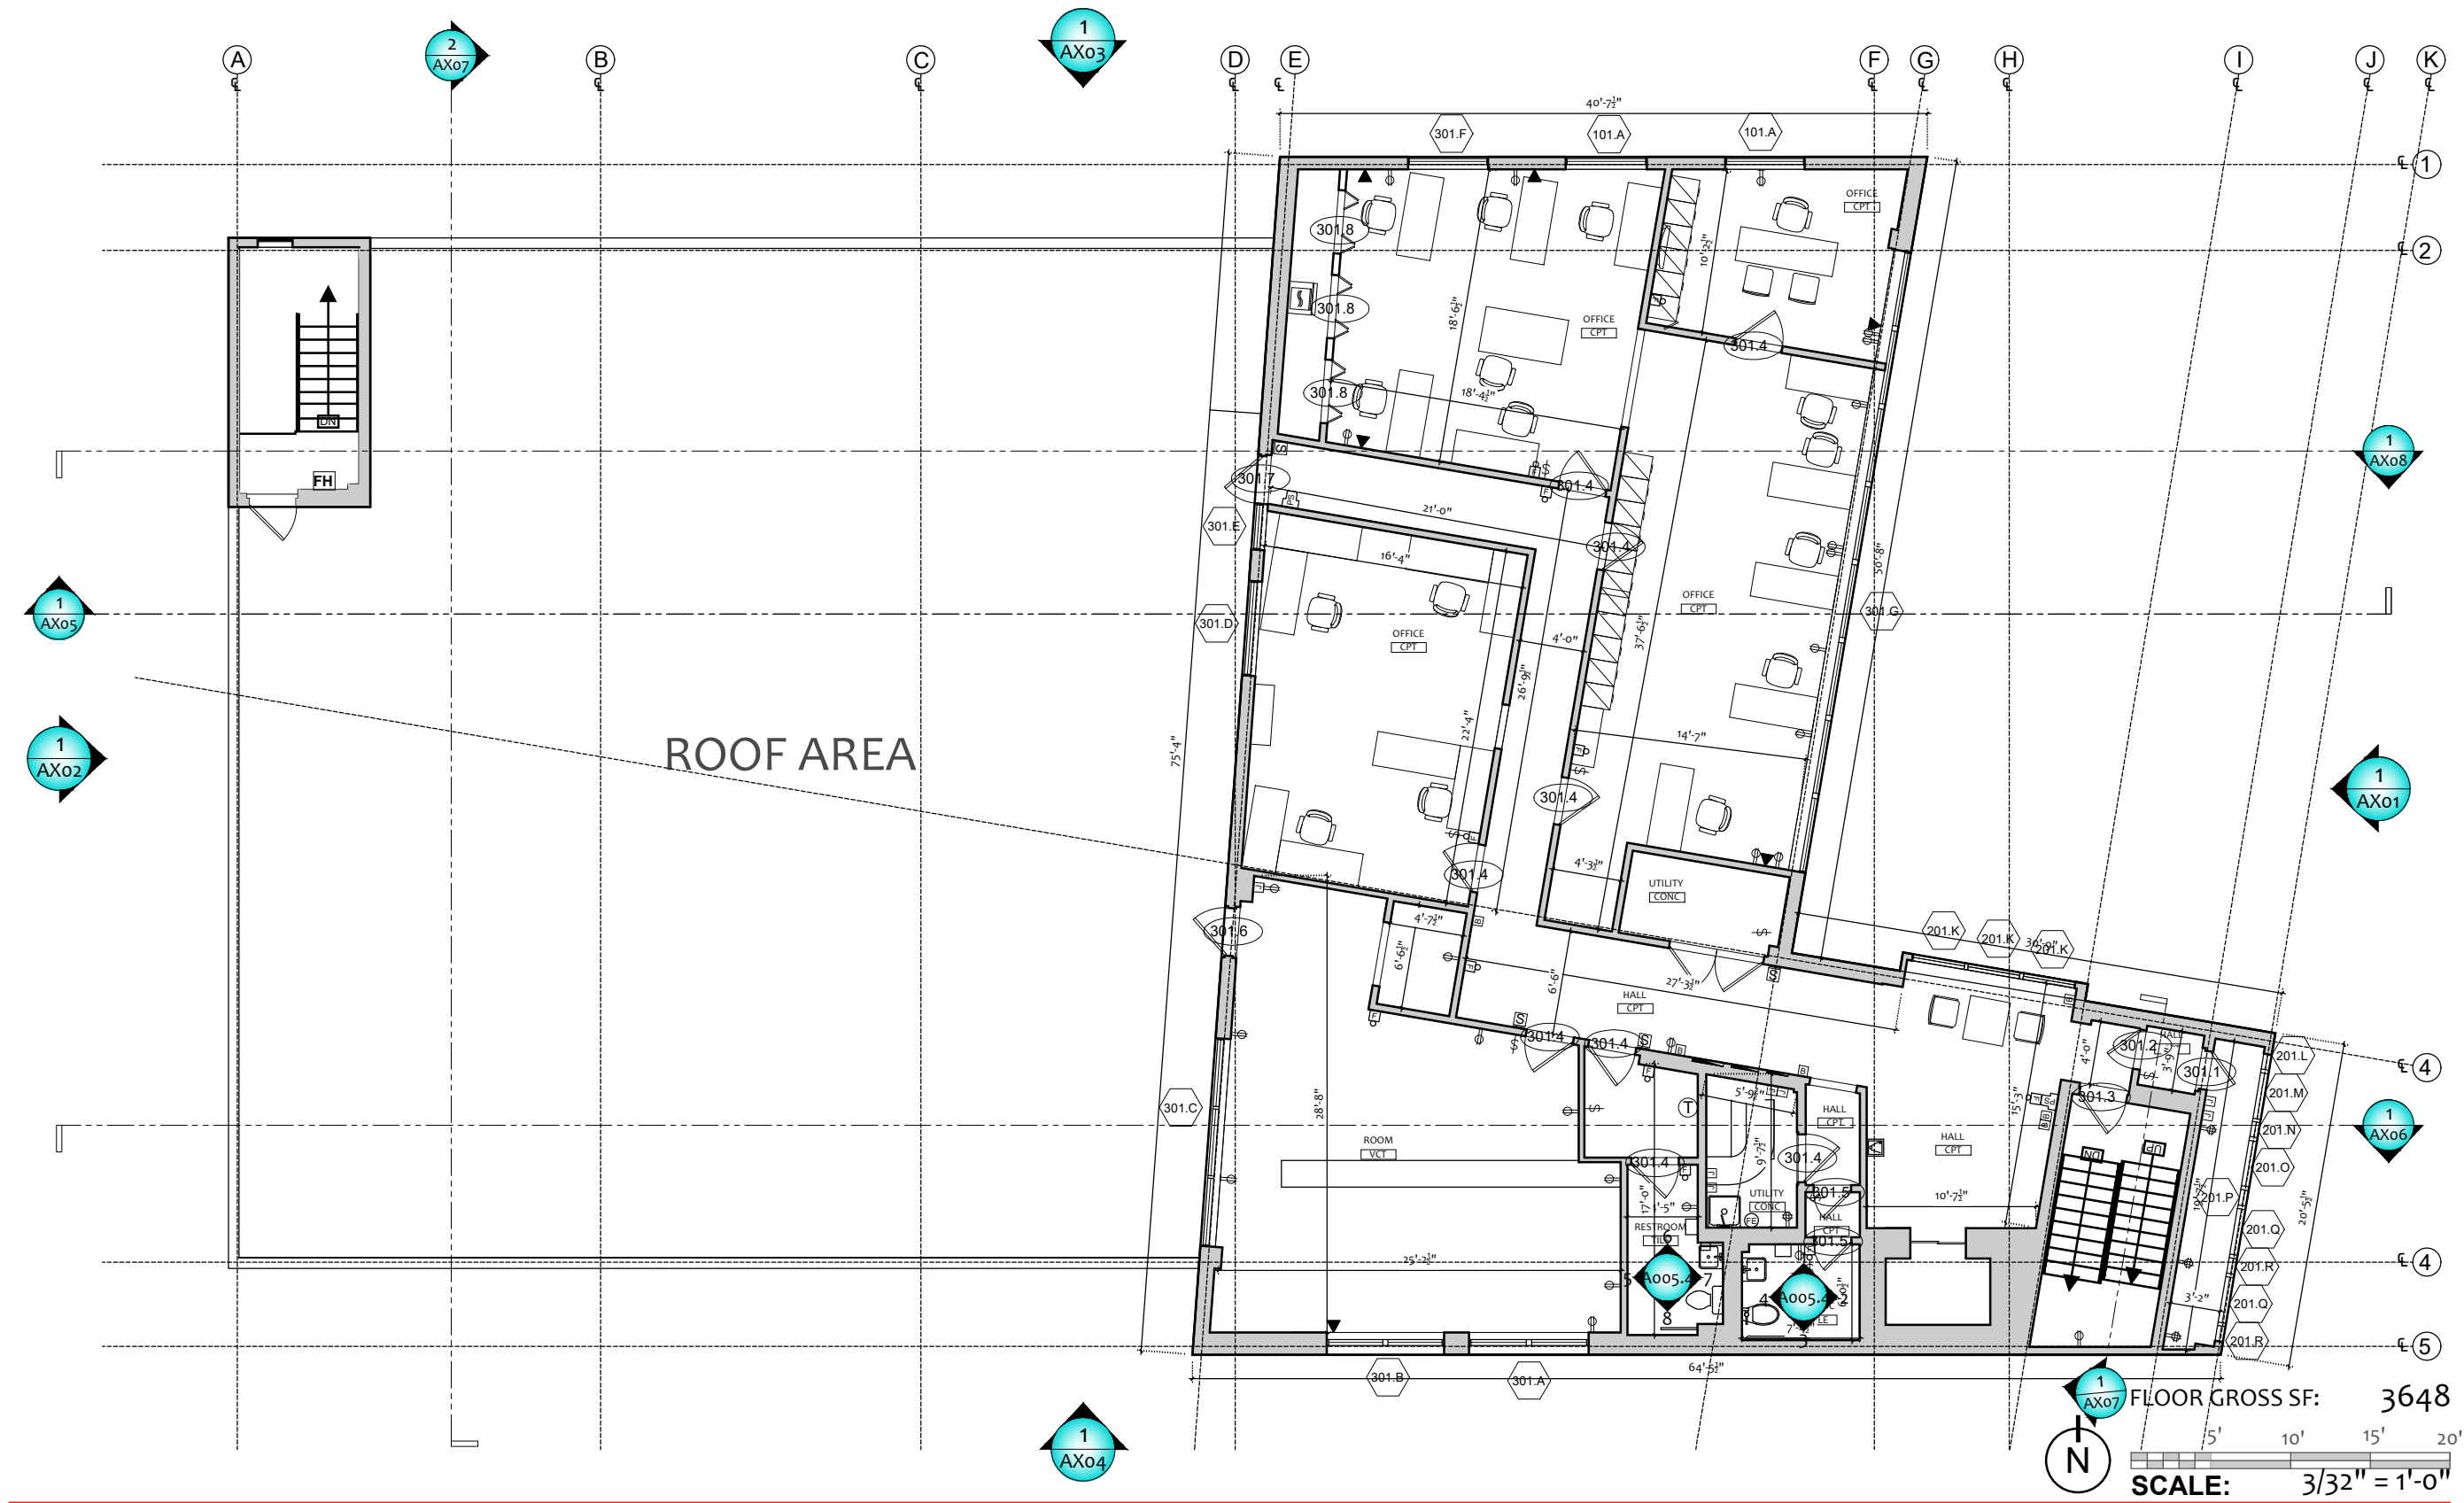

- 1 BUILDING ENTRANCE
- 2 EMERGENCY/ ALARMED EXIT DOOR
- 101.1 DOOR TAG - SEE DOOR SCHEDULE ON 1/A8.4
- 101.A WINDOW TAG - SEE WINDOW SCHEDULE ON 2/A8.4

- CPT CARPET
- TILE TILE
- WOOD WOOD
- S-LIN LINOLEUM SHEET
- MAT FLOOR MAT
- VCT VINYL COMP. TILE
- CONC CONCRETE

- ⌀ DUPLEX OUTLET
- ⌀ QUAD PLEX OUTLET
- ▼ DATA OUTLET
- ▼ DATA/ TELEPHONE
- ▽ TELEPHONE
- ⌀ DUPLEX - FLOOR
- ⌀ QUADPLEX - FLOOR

- ▼ DATA - FLOOR
- ▼ DATA / TELE - FLOOR
- ⌀ THERMOSTAT
- ⌀ FIRE EXTINGUISHER
- ⌀ FIRE HOSE
- ⌀ LIGHT SWITCH

- SCP SEC. CONT'L. PANEL
- MONITOR
- AV AV OUTLET
- ELEC PANEL - RECESSED
- ELEC PANEL - SURFACE
- GENERATOR ELEC GENERATOR

- C CARD READER
- K KEYPAD LOCK
- P PULL STATION
- ✓ FIRE CUT-OFF VALVE
- ☑ DRINKING FOUNTAIN

- VAULT
- VCT ROOM NAME & FLOORING MATERIAL
- COLUMN SIZE 6.5" X 6.5" @ 32'-0" O.C.
- COLUMN SIZE & FREQUENCY

- 1 A005 INTERIOR ELEVATIONS
- 1 AX01 EXTERIOR ELEVATIONS
- 1 AX01 SECTIONS

OWNER:

CLIENT:




Arktech Solutions LLC.
10804 Inside Loop
Orlando, FL 32825
tel: (407) 205-7787
www.ArktechSolution.com

FC NAME:	----
FCID:	N/A
FC ADDRESS:	----- ----- -----

FIELD SURVEYOR:	----
PROJECT DIRECTOR:	M.Vanegas
CHECKED BY:	----
DATE COMPLETED:	12-23-2019

PROJECT NUMBER:	----
SHEET:	A002.3
DRAWING NUMBER:	09
OF:	41

DRAWING NAME:
3rd FLOOR PLAN

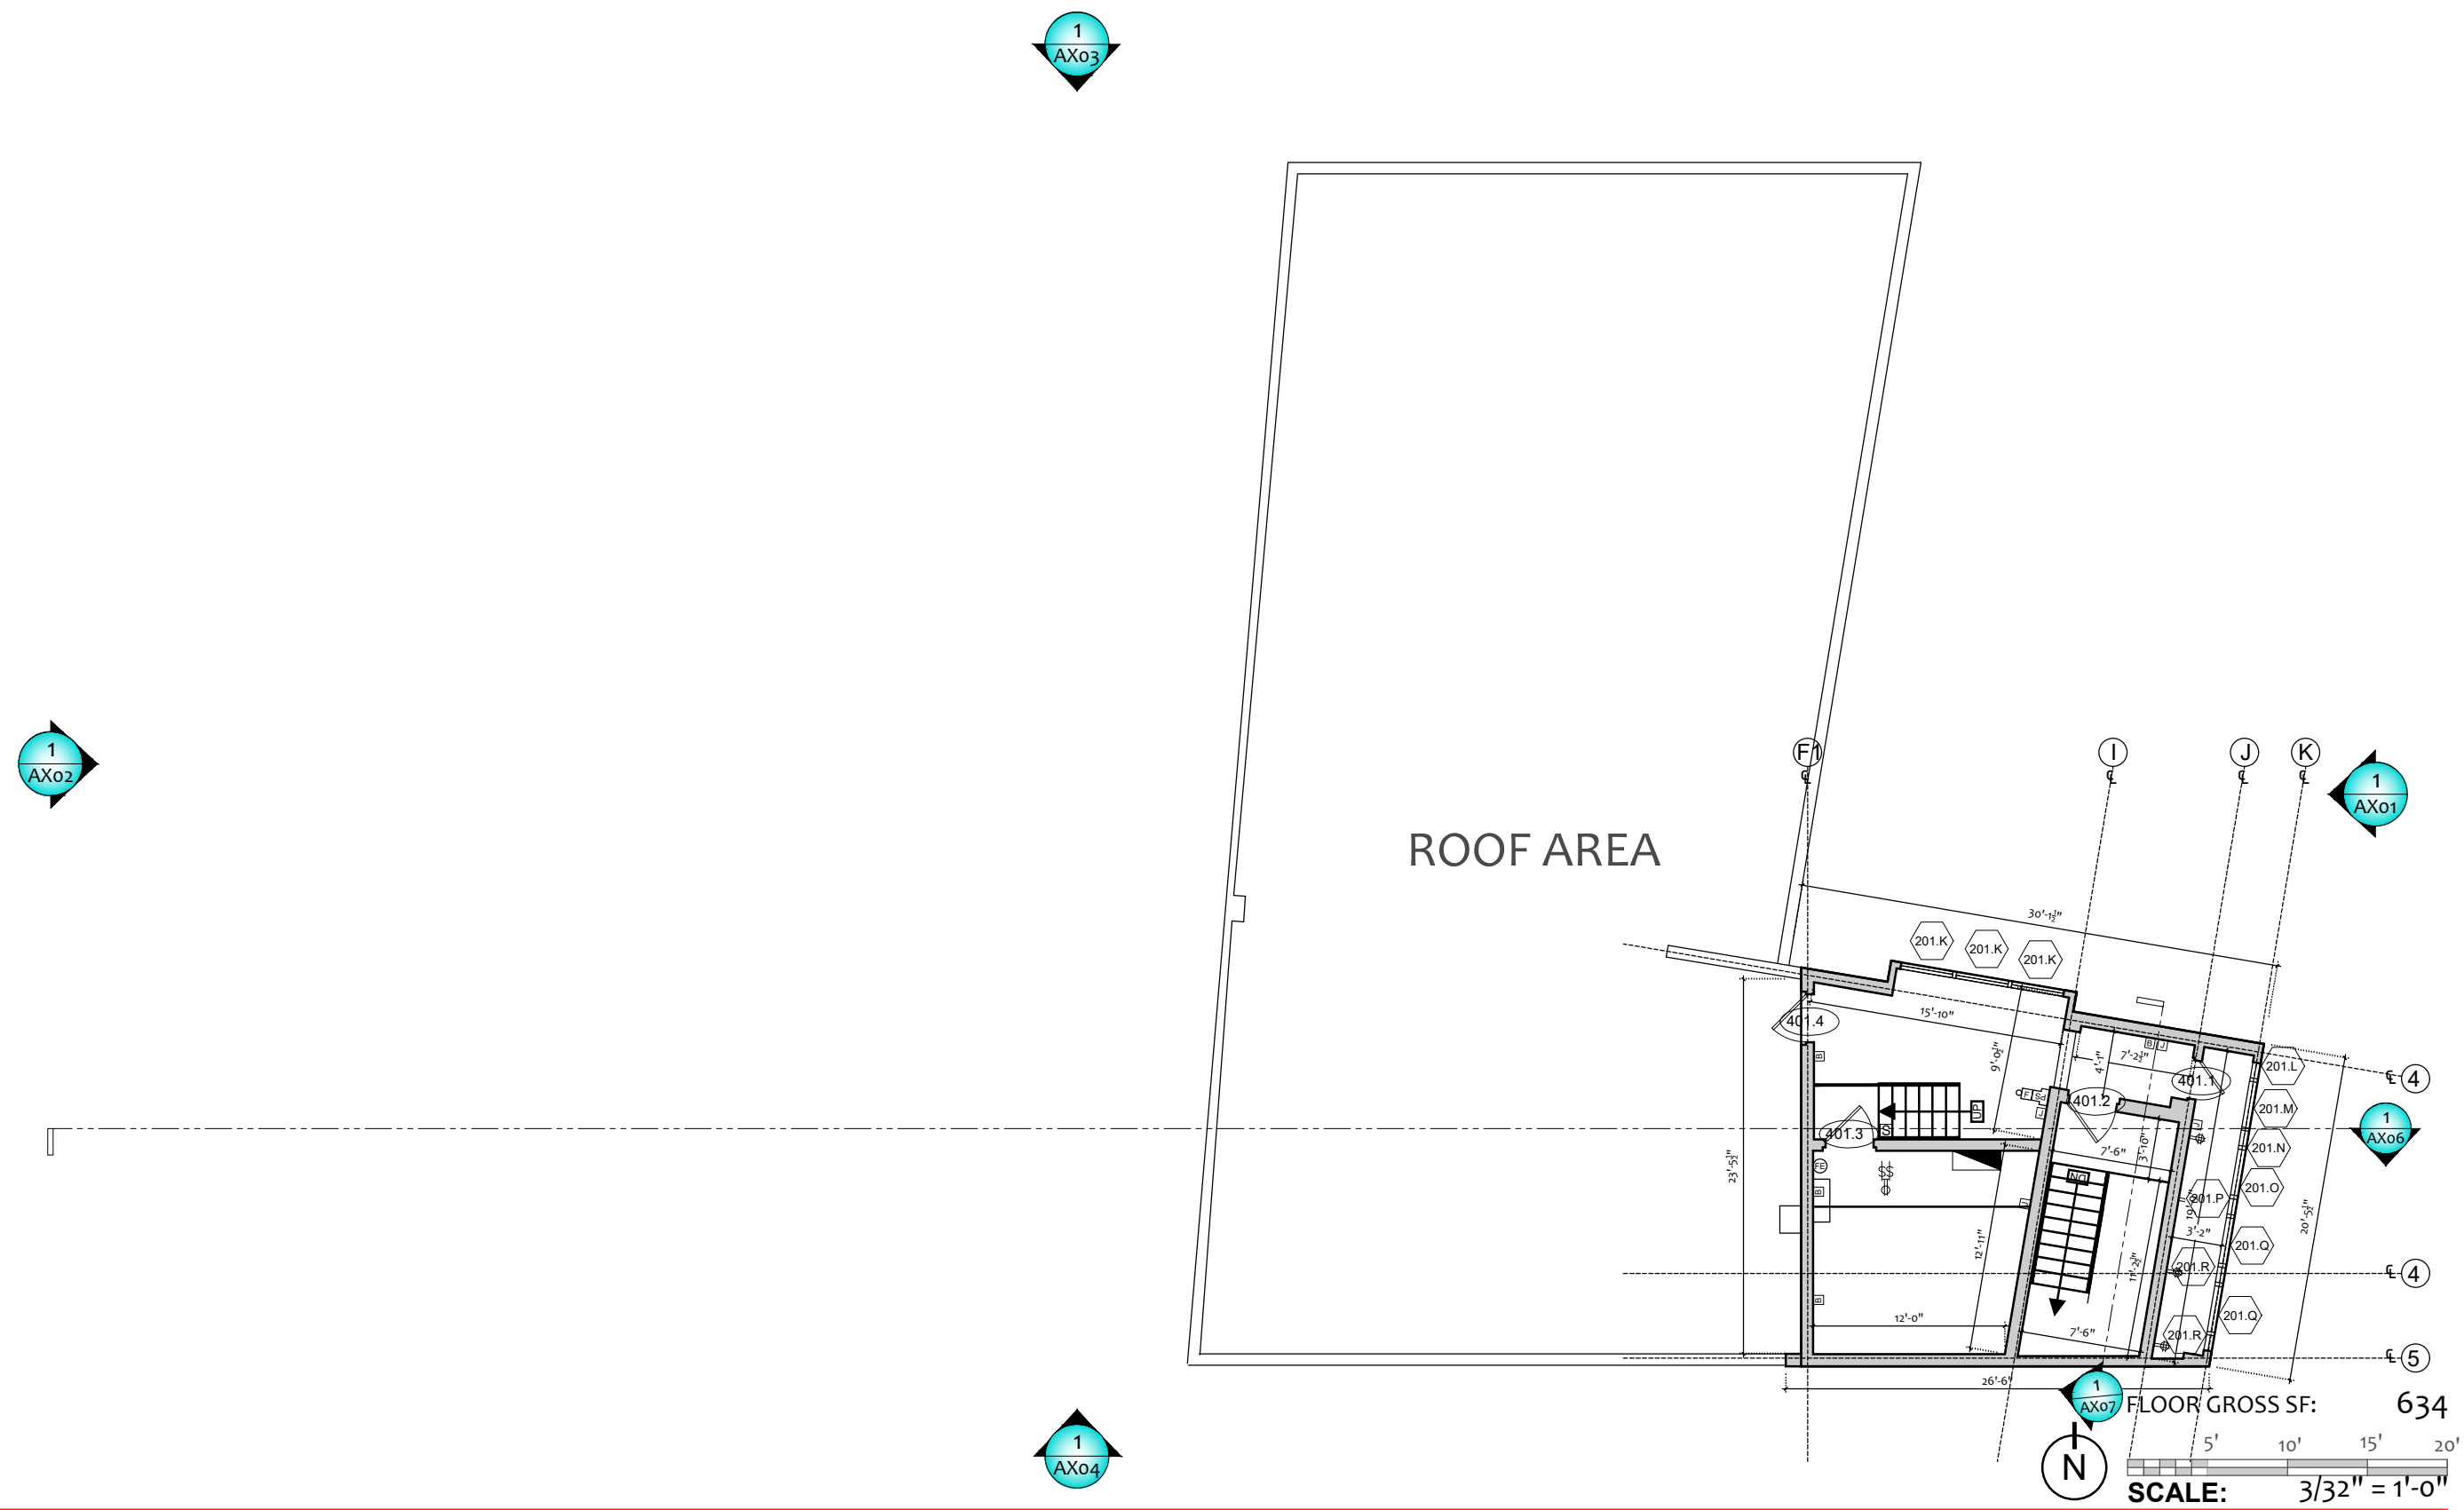

- 1 BUILDING ENTRANCE
- 2 EMERGENCY/ ALARMED EXIT DOOR
- 101.1 DOOR TAG - SEE DOOR SCHEDULE ON 1/A8.5
- 101.A WINDOW TAG - SEE WINDOW SCHEDULE ON 2/A8.5

- CPT CARPET
- TILE TILE
- WOOD WOOD
- S-LIN LINOLEUM SHEET
- MAT FLOOR MAT
- VCT VINYL COMP. TILE
- CONC CONCRETE

- ⌀ DUPLEX OUTLET
- ⌀ QUAD PLEX OUTLET
- ▼ DATA OUTLET
- ▼ DATA/ TELEPHONE
- ▽ TELEPHONE
- Ⓛ DUPLEX - FLOOR
- Ⓛ QUADPLEX - FLOOR

- ▼ DATA - FLOOR
- ▼ DATA / TELE - FLOOR
- Ⓢ THERMOSTAT
- Ⓢ FIRE EXTINGUISHER
- Ⓢ FIRE HOSE
- Ⓢ LIGHT SWITCH

- SCP SEC. CONT'L. PANEL
- MONITOR
- AV AV OUTLET
- ELEC PANEL - RECESSED
- ELEC PANEL - SURFACE
- GENERATOR ELEC GENERATOR

- C CARD READER
- K KEYPAD LOCK
- P PULL STATION
- V FIRE CUT-OFF VALVE
- DRINKING FOUNTAIN

- VAULT
- VCT ROOM NAME & FLOORING MATERIAL
- COLUMN SIZE 6.5" X 6.5" @ 32'-0" O.C.
- COLUMN SIZE & FREQUENCY

- A005 INTERIOR ELEVATIONS
- 1 AX01 EXTERIOR ELEVATIONS
- 1 AX01 SECTIONS


OWNER:

CLIENT:



Arktech Solutions LLC.
10804 Inside Loop
Orlando, FL 32825
tel: (407) 205-7787
www.ArktechSolution.com

FC NAME:	----
FCID:	N/A
FC ADDRESS:	----- ----- -----
FIELD SURVEYOR:	----
PROJECT DIRECTOR:	M.Vanegas
CHECKED BY:	----
DATE COMPLETED:	12-23-2019
PROJECT NUMBER:	----
SHEET:	A002.4
DRAWING NUMBER:	10
OF:	41
DRAWING NAME:	PENTHOUSE FLOOR PLAN

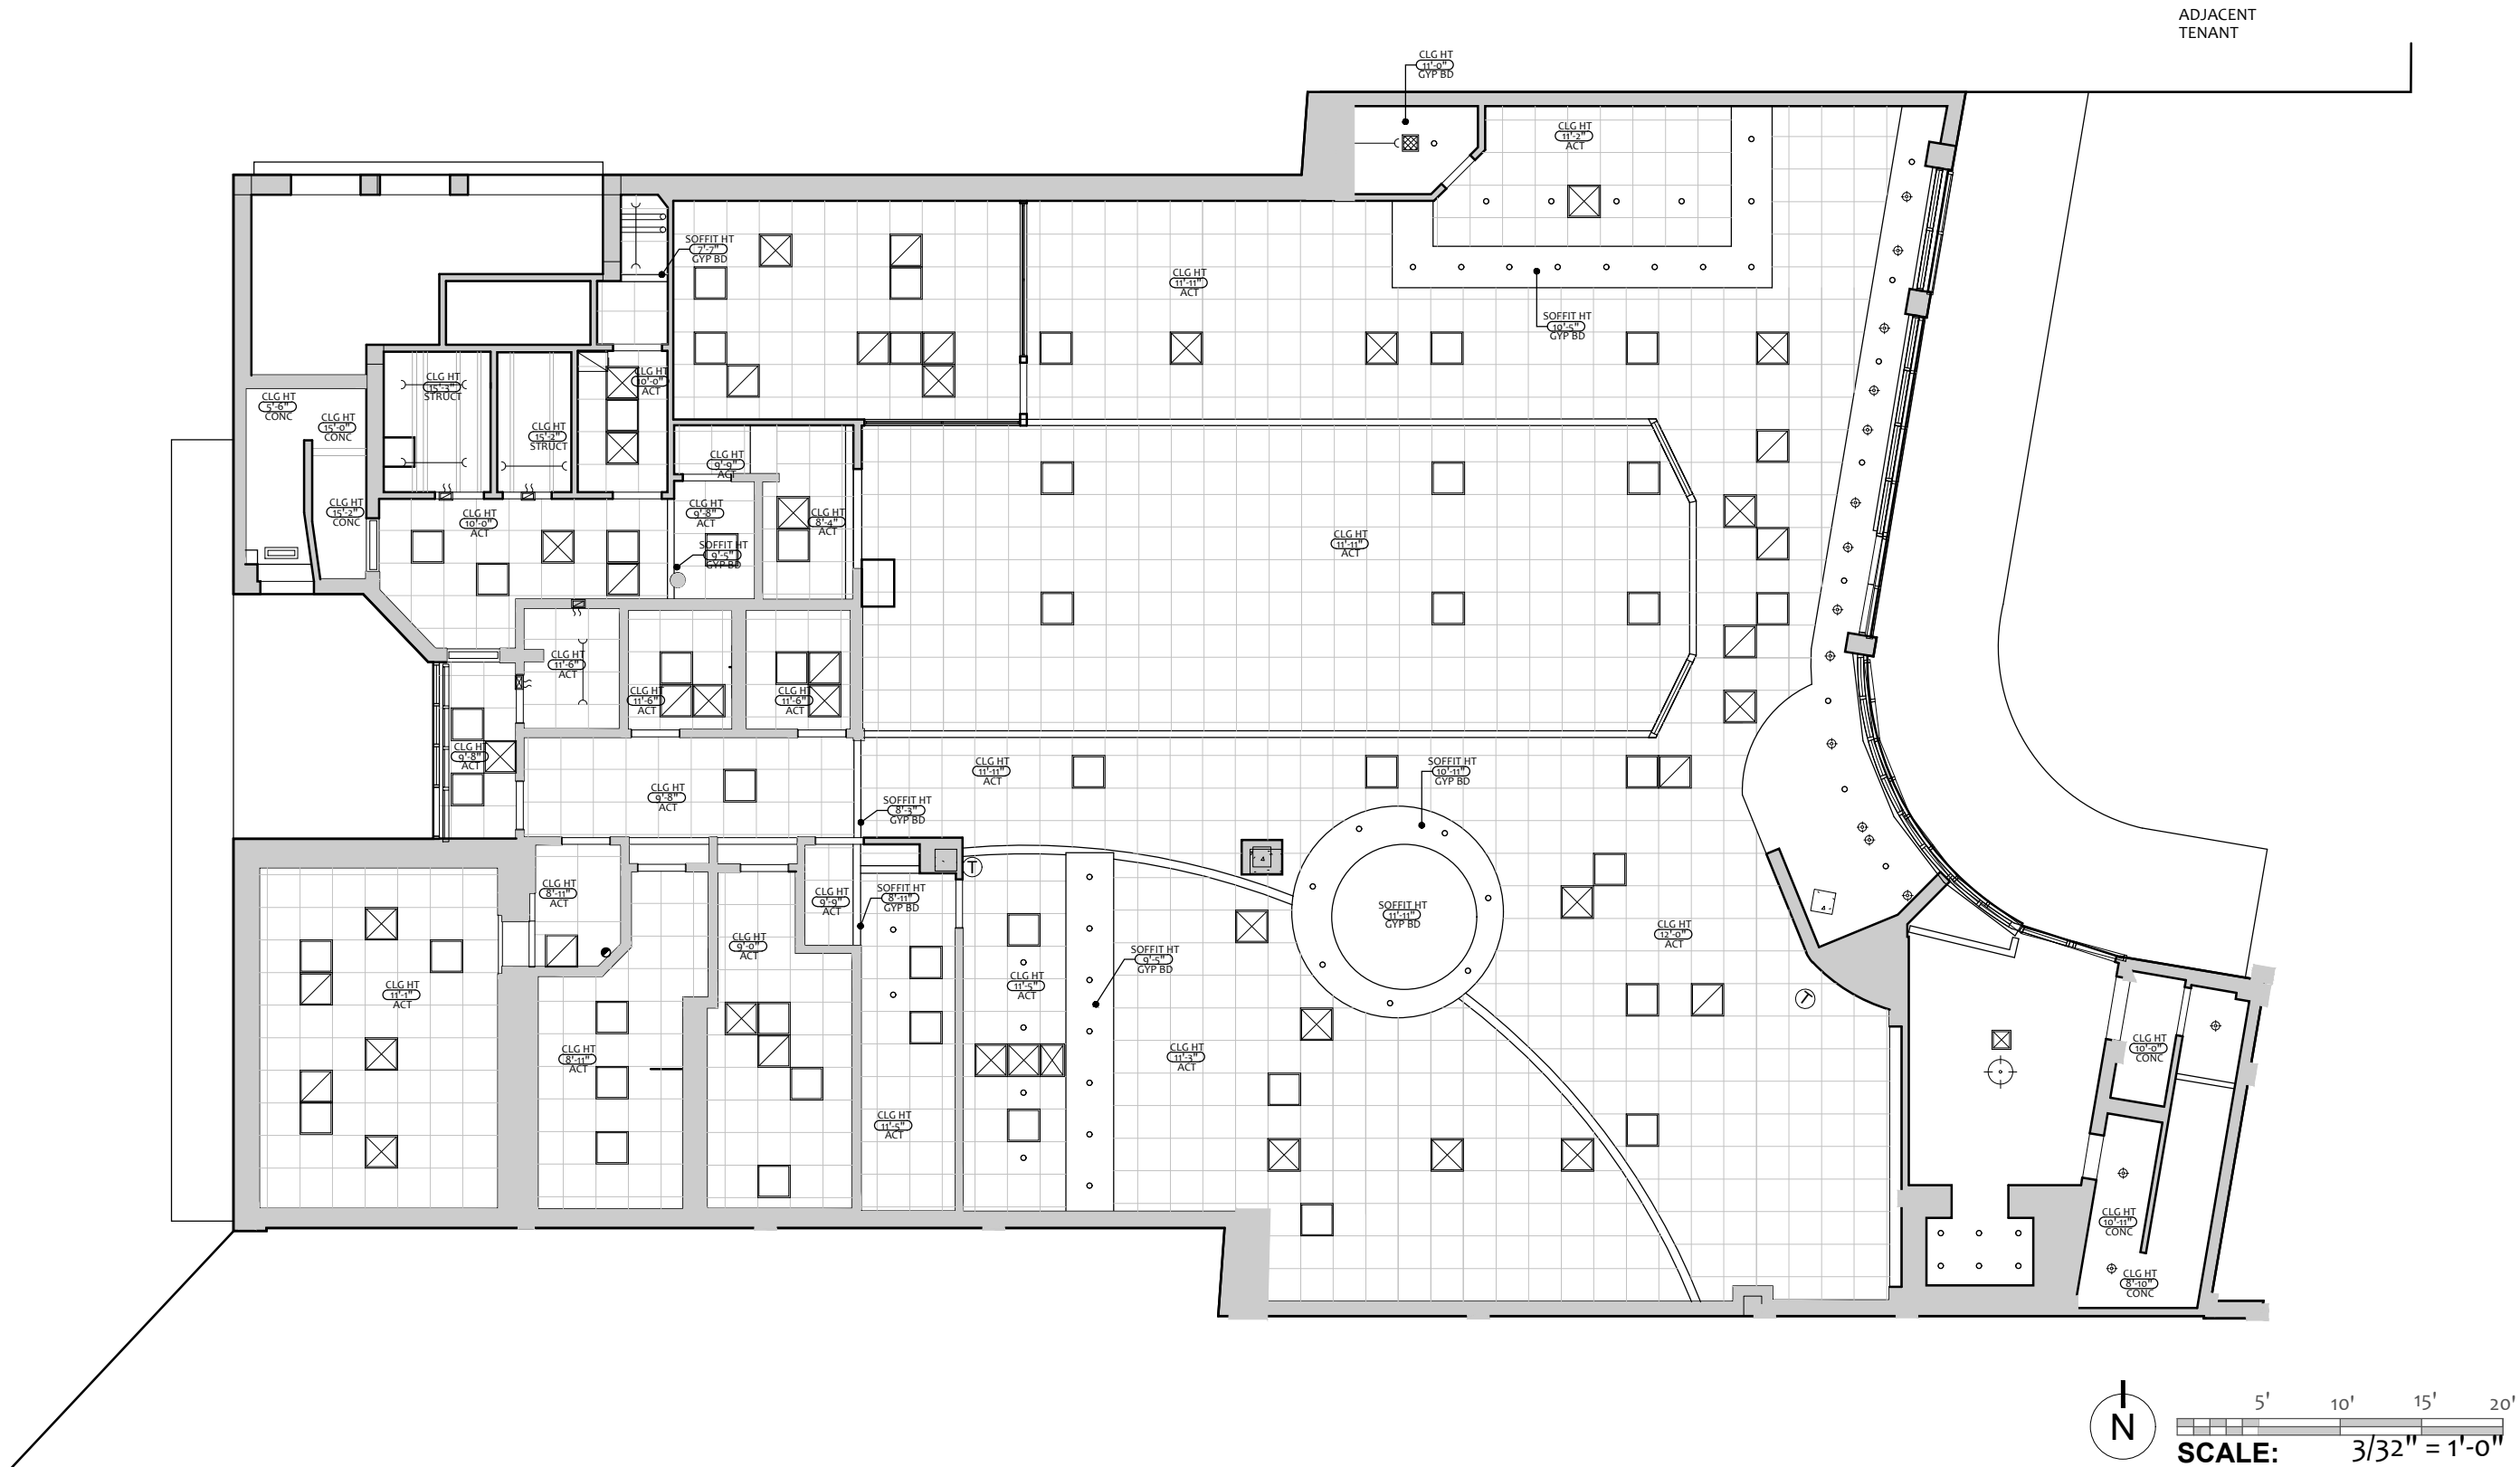

- | | | | | | | | |
|---------|------------------------------|---|-----------------------|---|-----------------|---|-------------------------|
| ACT | CEILING TILE | ⊠ | DUPLEX - CEILING | ⊙ | SMOKE DETECTOR | ⊗ | MOTION SENSOR - CEILING |
| GYP BD | GYPSUM BOARD | ⊠ | QUADPLEX - CEILING | ⊙ | FIRE SPRINKLER | ⊗ | MOTION SENSOR - WALL |
| STRUCT | STRUCTURE | ⬇ | DATA - CEILING | ⊙ | EMERGENCY LIGHT | ⊠ | FIRE STROBE |
| CONC | CONCRETE | ⬆ | DATA / TELE - CEILING | ⊠ | FIRE HORN/ALARM | ⊠ | SURVEILLANCE CAMERA |
| METAL | METAL | ⊙ | SPEAKER | ⊠ | MONITOR | ⊠ | CAMERA BUBBLE |
| WOOD | WOOD | ⊠ | | ⊠ | EXIT SIGN | ⊠ | THERMOSTAT |
| ACT DIR | CEILING TILE, DIRECT-APPLIED | | | | | | |
| APP | | | | | | | |

- | | | | | |
|-----------------------------|---|-----------------------|---|--------------------------|
| 2 x 4 FLUORESCENT FIXTURE | ○ | RECESSED CAN LIGHT | ⊠ | SUPPLY AIR REGISTER |
| 2 x 2 FLUORESCENT FIXTURE | ⊙ | PENDANT LIGHT | ⊠ | RETURN AIR REGISTER |
| FLUORESCENT FIXTURE | ⊙ | WALL SCONCE | ⊠ | SUPPLY REGISTERS |
| UTILITY FLUORESCENT FIXTURE | ○ | SURFACE MOUNTED LIGHT | ⊠ | SUPPLY WALL AIR REGISTER |
| TRACK LIGHT FIXTURE | | | ⊠ | RETURN WALL AIR REGISTER |

CLG HT 8'-0" ACT
HEIGHT OF CEILING FROM FLOOR & CEILING MATERIAL

OWNER:

CLIENT:



Arktech Solutions LLC.
10804 Inside Loop
Orlando, FL 32825
tel: (407) 205-7787
www.ArktechSolution.com

FC NAME:	----
FCID:	N/A
FC ADDRESS:	----- ----- -----
FIELD SURVEYOR:	----
PROJECT DIRECTOR:	M.Vanegas
CHECKED BY:	----
DATE COMPLETED:	12-23-2019
PROJECT NUMBER:	----
SHEET:	A003.1
DRAWING NUMBER:	11
OF:	41
DRAWING NAME:	RCP 1st FLOOR PLAN

OWNER:

CLIENT:



Arktech Solutions LLC.
10804 Inside Loop
Orlando, FL 32825
tel: (407) 205-7787
www.ArktechSolution.com

FC NAME:	----
FCID:	N/A
FC ADDRESS:	----- ----- -----

FIELD SURVEYOR:	----
PROJECT DIRECTOR:	M.Vanegas
CHECKED BY:	----
DATE COMPLETED:	12-23-2019

PROJECT NUMBER:	----
SHEET:	A003.2
DRAWING NUMBER:	12
OF:	41

DRAWING NAME:
RCP 2nd FLOOR PLAN




ACT	CEILING TILE	DUPLX - CEILING	SMOKE DETECTOR	MOTION SENSOR - CEILING
GYP BD	GYPSUM BOARD	QUADPLEX - CEILING	FIRE SPRINKLER	MOTION SENSOR - WALL
STRUCT	STRUCTURE	DATA - CEILING	EMERGENCY LIGHT	FIRE STROBE
CONC	CONCRETE	DATA / TELE - CEILING	FIRE HORN/ALARM	SURVEILLANCE CAMERA
METAL	METAL	SPEAKER	MONITOR	CAMERA BUBBLE
WOOD	WOOD		EXIT SIGN	
ACT DIR	CEILING TILE, DIRECT-APPLIED			
APP				

2 x 4 FLUORESCENT FIXTURE	RECESSED CAN LIGHT	SUPPLY AIR REGISTER
2 x 2 FLUORESCENT FIXTURE	ADJUSTABLE CAN LIGHT	RETURN AIR REGISTER
FLUORESCENT FIXTURE	PENDANT LIGHT	SUPPLY REGISTERS
UTILITY FLUORESCENT FIXTURE	WALL SCONCE	VENT
TRACK LIGHT FIXTURE	SURFACE MOUNTED LIGHT	CEILING FAN

CLG HT 8'-0" ACT
HEIGHT OF CEILING FROM FLOOR & CEILING MATERIAL



ROOF AREA

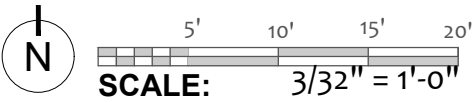

- | | | | | | | | |
|---------|------------------------------|---|-----------------------|---|-----------------|---|-------------------------|
| ACT | CEILING TILE | ⊠ | DUPLEX - CEILING | ⊙ | SMOKE DETECTOR | ⊗ | MOTION SENSOR - CEILING |
| GYP BD | GYPSUM BOARD | ⊠ | QUADPLEX - CEILING | ⊙ | FIRE SPRINKLER | ⊗ | MOTION SENSOR - WALL |
| STRUCT | STRUCTURE | ▼ | DATA - CEILING | ⊙ | EMERGENCY LIGHT | ✱ | FIRE STROBE |
| CONC | CONCRETE | ▼ | DATA / TELE - CEILING | ⊗ | FIRE HORN/ALARM | ⇒ | SURVEILLANCE CAMERA |
| METAL | METAL | ⊙ | SPEAKER | ⊗ | MONITOR | ⊙ | CAMERA BUBBLE |
| WOOD | WOOD | ⊙ | SPEAKER | ⊗ | EXIT SIGN | ⊙ | |
| ACT DIR | CEILING TILE, DIRECT-APPLIED | ⊙ | | ⊗ | | ⊙ | |
| APP | | ⊙ | | ⊗ | | ⊙ | |

- | | | | | |
|-----------------------------|---|-----------------------|---|---------------------|
| 2 x 4 FLUORESCENT FIXTURE | ○ | RECESSED CAN LIGHT | ⊗ | SUPPLY AIR REGISTER |
| 2 x 2 FLUORESCENT FIXTURE | ● | ADJUSTABLE CAN LIGHT | ⊗ | RETURN AIR REGISTER |
| FLUORESCENT FIXTURE | ⊙ | PENDANT LIGHT | ⊗ | SUPPLY REGISTERS |
| UTILITY FLUORESCENT FIXTURE | ⊙ | WALL SCONCE | ⊗ | VENT |
| TRACK LIGHT FIXTURE | ○ | SURFACE MOUNTED LIGHT | ⊗ | CEILING FAN |

CLG HT 8'-0" ACT
HEIGHT OF CEILING FROM FLOOR & CEILING MATERIAL

OWNER:

CLIENT:



Arktech Solutions LLC.
10804 Inside Loop
Orlando, FL 32825
tel: (407) 205-7787
www.ArktechSolution.com

FC NAME:	----
FCID:	N/A
FC ADDRESS:	----- ----- -----

FIELD SURVEYOR:	----
PROJECT DIRECTOR:	M.Vanegas
CHECKED BY:	----
DATE COMPLETED:	12-23-2019

PROJECT NUMBER:	----
SHEET:	A003.3
DRAWING NUMBER:	13
OF:	41

DRAWING NAME:	RCP 3rd FLOOR PLAN
---------------	--------------------

ACT
GYP BD
STRUCT
CONC
METAL
WOOD
ACT DIR
APP

CEILING TILE
GYPSUM BOARD
STRUCTURE
CONCRETE
METAL
WOOD
CEILING TILE,
DIRECT-APPLIED

DUPLEX - CEILING

QUADPLEX - CEILING

DATA - CEILING

DATA / TELE - CEILING

SPEAKER

SMOKE DETECTOR

FIRE SPRINKLER

EMERGENCY LIGHT

FIRE HORN/ALARM

MONITOR

EXIT SIGN

MOTION SENSOR - CEILING

MOTION SENSOR - WALL

FIRE STROBE

SURVEILLANCE CAMERA

CAMERA BUBBLE

2 x 4 FLUORESCENT FIXTURE

2 x 2 FLUORESCENT FIXTURE

FLUORESCENT FIXTURE

UTILITY FLUORESCENT FIXTURE

TRACK LIGHT FIXTURE

RECESSED CAN LIGHT

ADJUSTABLE CAN LIGHT

PENDANT LIGHT

WALL SCONCE

SURFACE MOUNTED LIGHT

SUPPLY AIR REGISTER

RETURN AIR REGISTER

SUPPLY REGISTERS


VENT

CEILING FAN

CLG HT
8'-0"

ACT

HEIGHT OF CEILING
FROM FLOOR &
CEILING MATERIAL

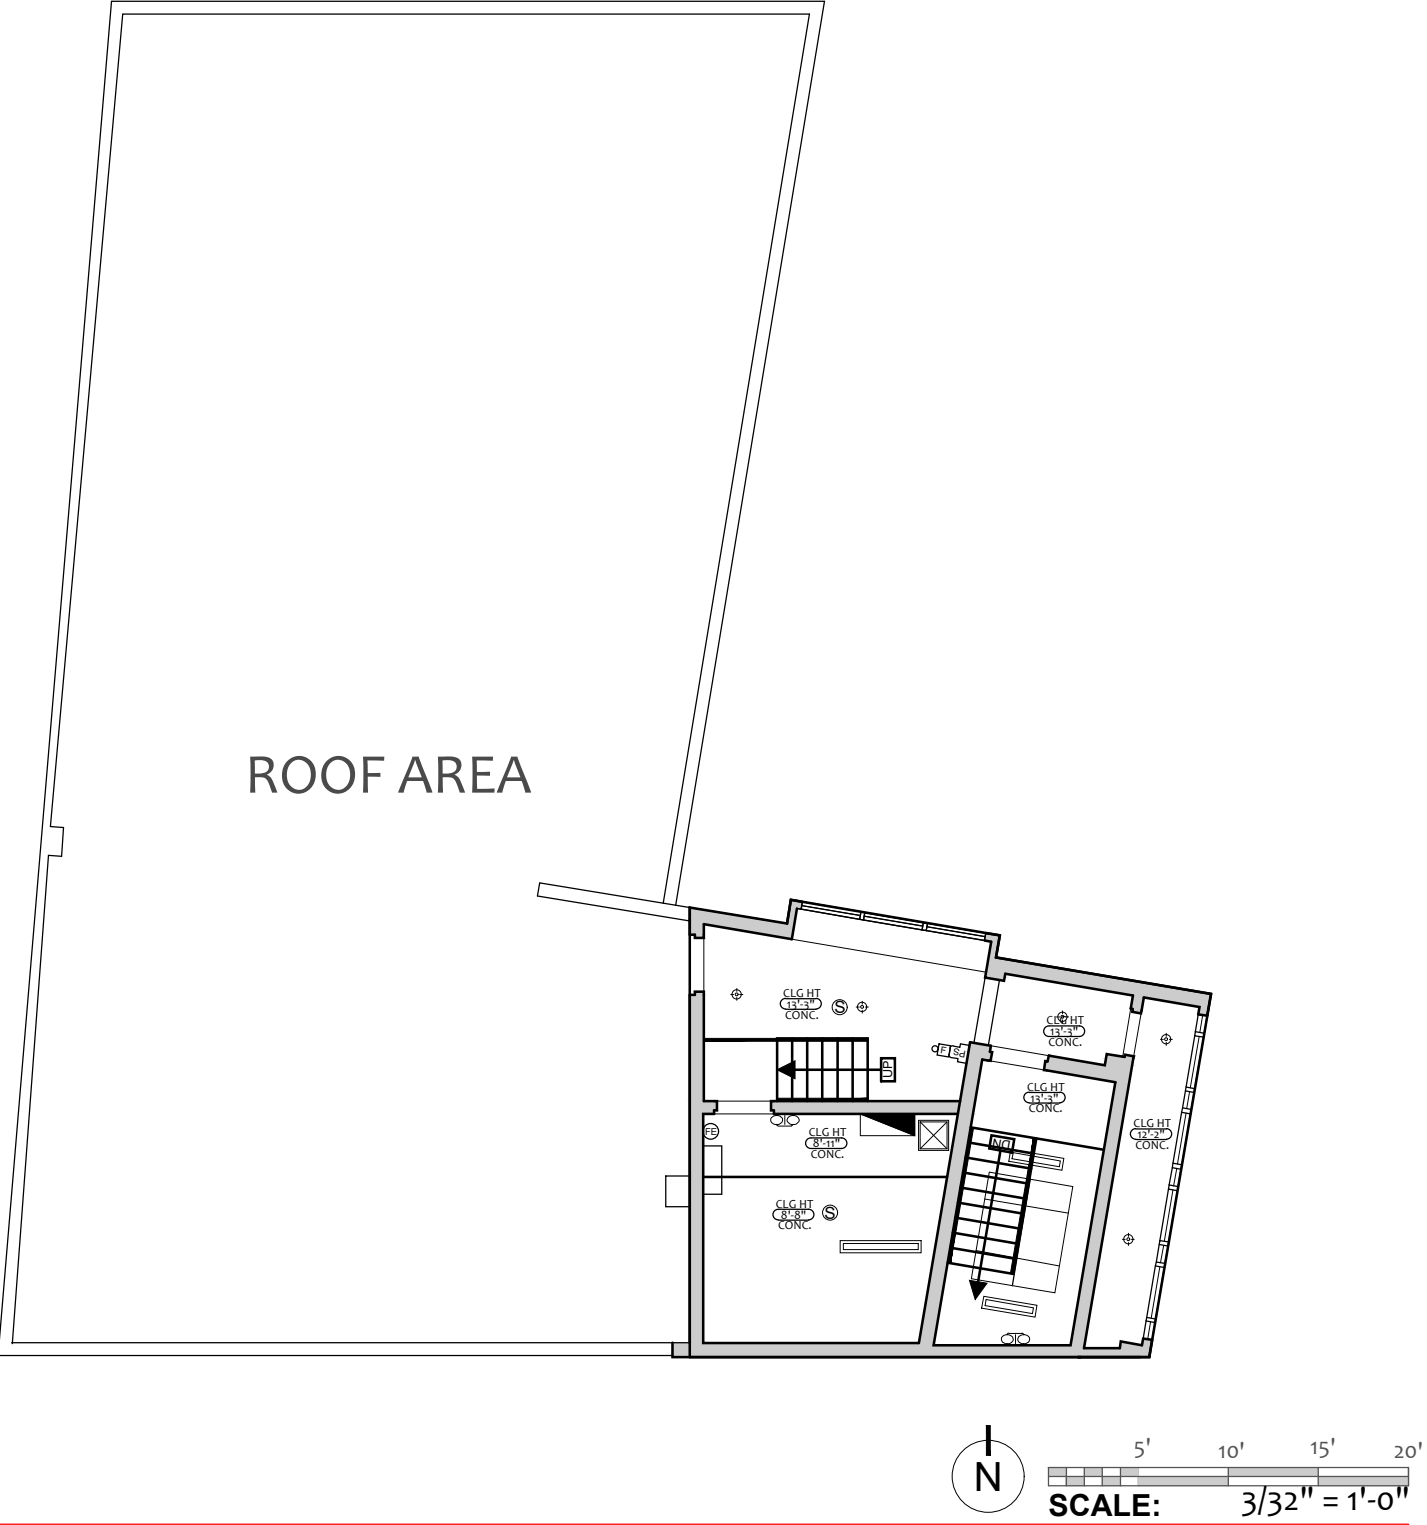

OWNER:

CLIENT:



Arktech Solutions LLC.
10804 Inside Loop
Orlando, FL 32825
tel: (407) 205-7787
www.ArktechSolution.com

FC NAME:

FCID:
N/A

FC ADDRESS:

FIELD SURVEYOR:

PROJECT DIRECTOR:
M.Vanegas

CHECKED BY:

DATE COMPLETED:
12-23-2019

PROJECT NUMBER:

SHEET:
A003.4

DRAWING NUMBER:
14

OF:
41

DRAWING NAME:
RCP PENTHOUSE PLAN

OWNER:

CLIENT:





Arktech Solutions LLC.
10804 Inside Loop
Orlando, FL 32825
tel: (407) 205-7787
www.ArktechSolution.com

FC NAME:	----
FCID:	N/A
FC ADDRESS:	----- ----- -----

FIELD SURVEYOR:	----
PROJECT DIRECTOR:	M.Vanegas
CHECKED BY:	----
DATE COMPLETED:	12-23-2019


PROJECT NUMBER:	----
SHEET:	A004
DRAWING NUMBER:	15
OF:	41

DRAWING NAME:	ROOF PLAN
---------------	-----------

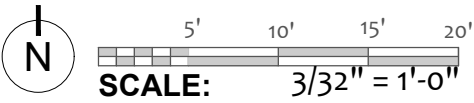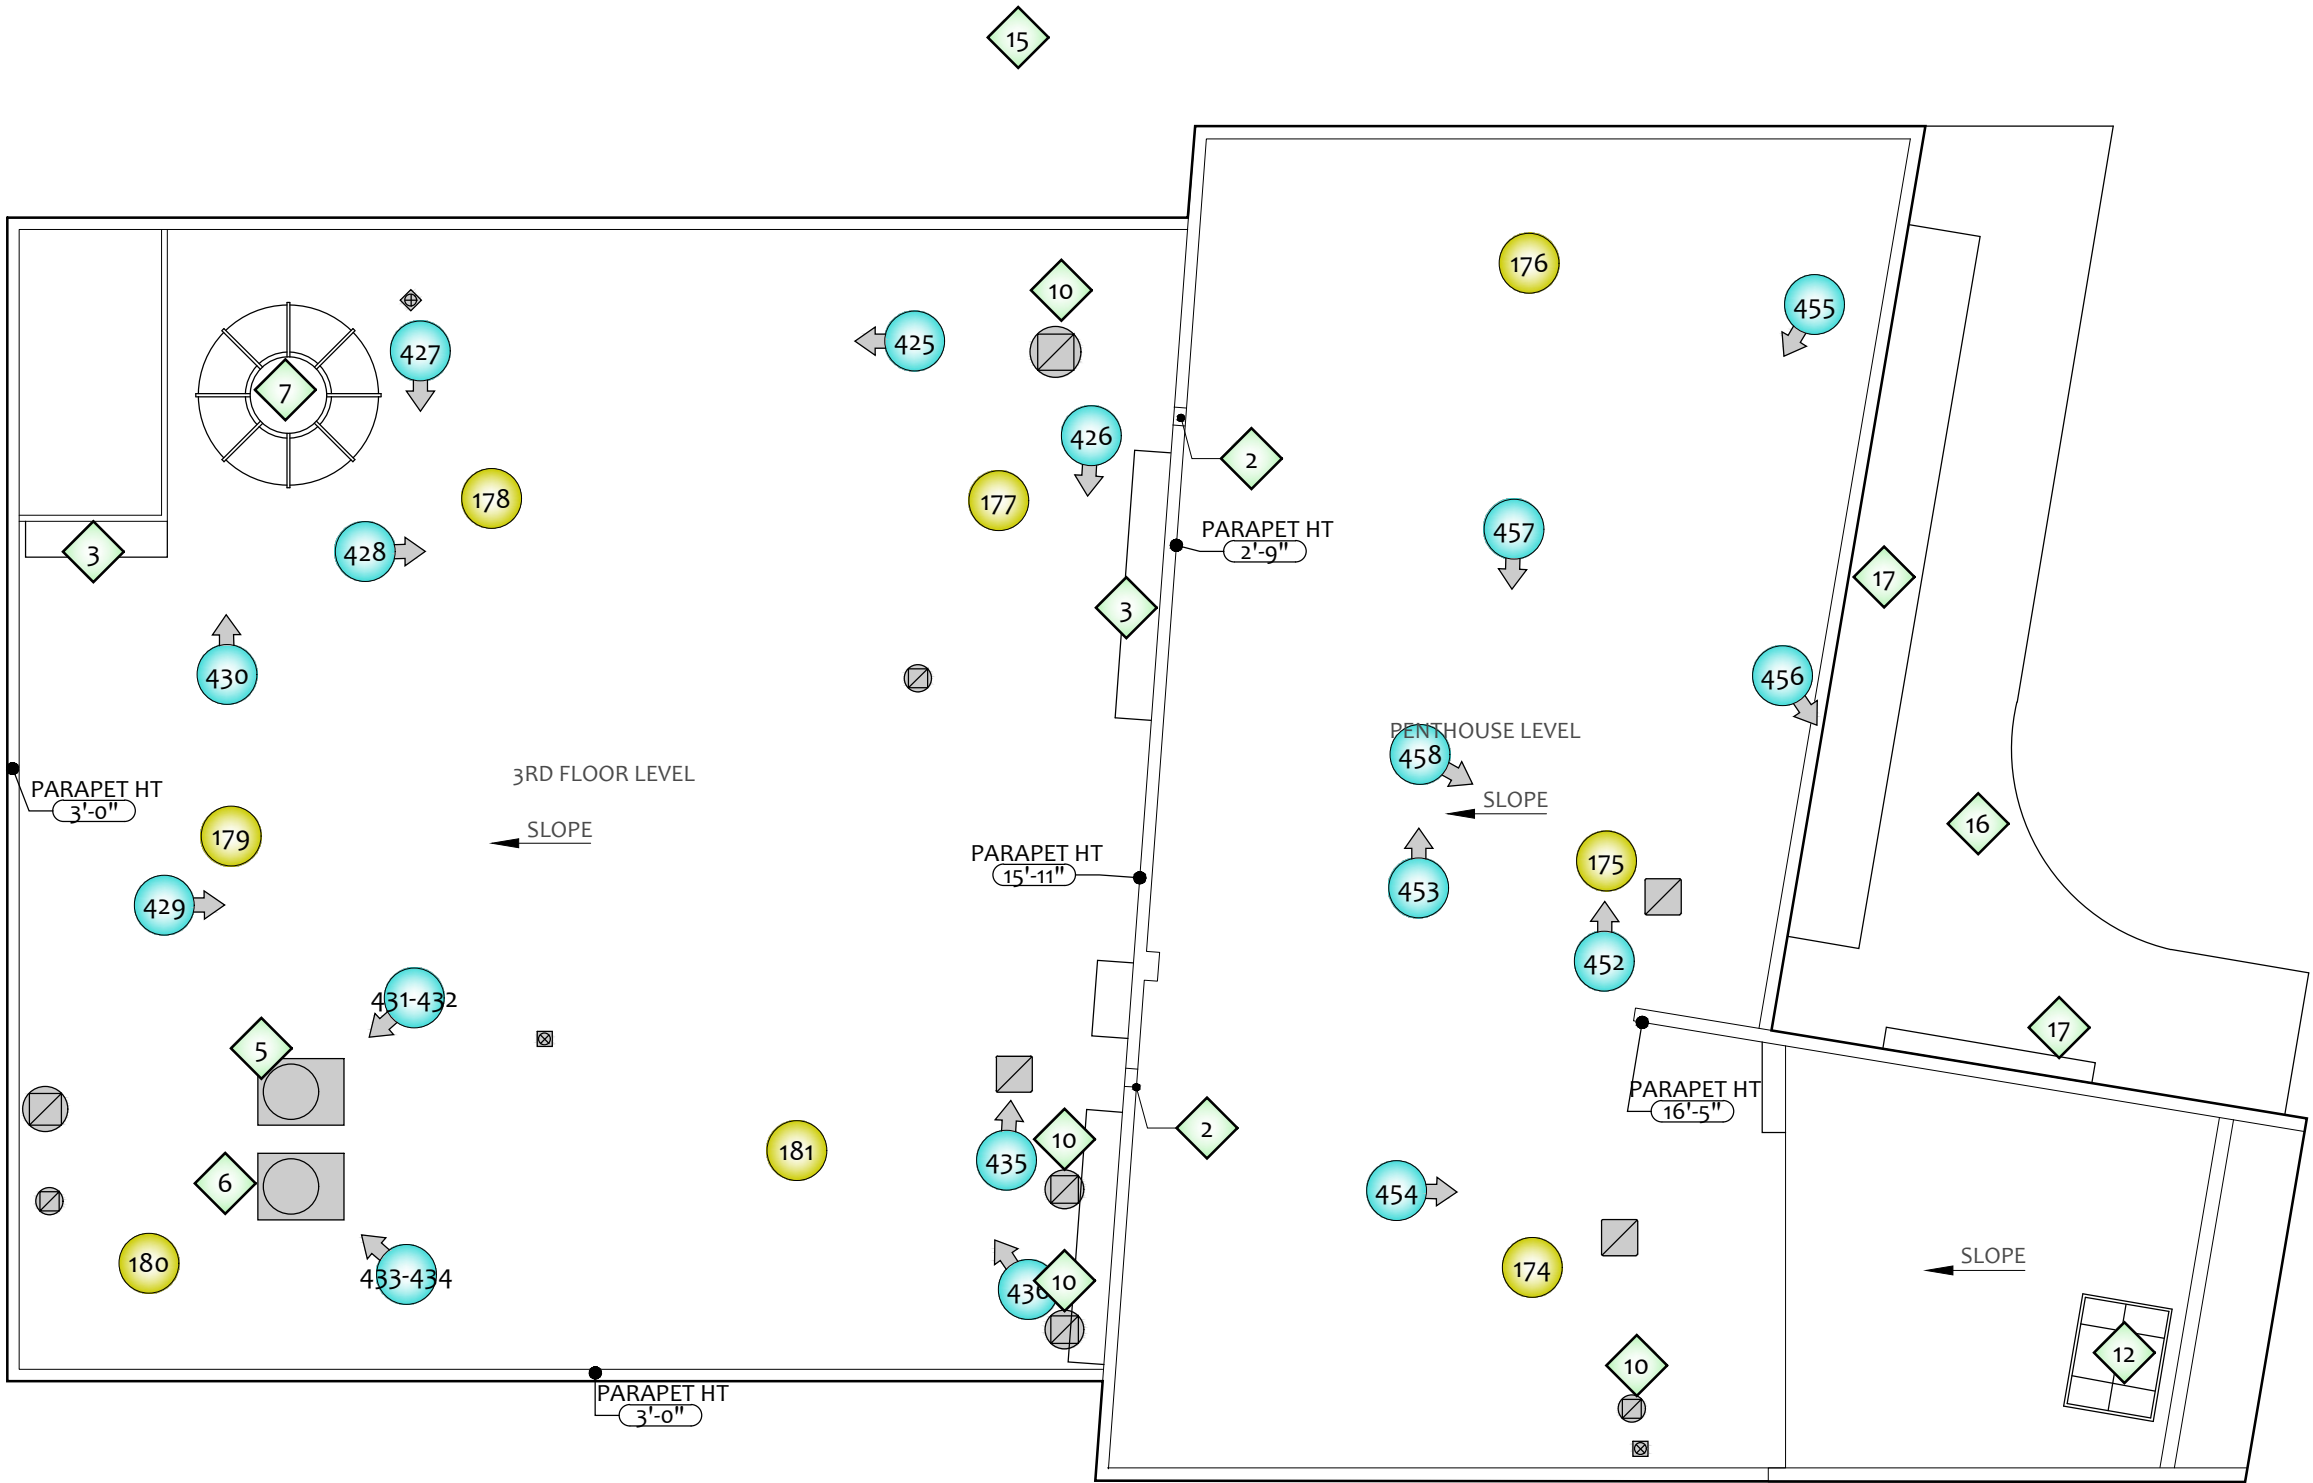


- | | | | |
|----------------------|--|-------------------------|--------------------------------|
| 1 PARAPET WALL | 5 CARRIER - MODEL NUMBER 38ARD012 - Serial Number 3505G30080 | 10 EXHAUST FAN | 14 COOLER / FREEZER COND. UNIT |
| 2 ROOF DRAIN | 6 CARRIER - MODEL NUMBER 38ARD012 - Serial Number 3505G30089 | 11 EXHAUST VENT | 15 ROOF TOP BELOW |
| 3 ROOF LADDER ACCESS | 7 PROTEC WATER TREATMENT UNIT | 12 SKYLIGHT | 16 METAL CANOPY |
| 4 DISCONNECT | | 13 HEATCRAFT COND. UNIT | 17 AWNING BELOW |


CLG HT
8'-0"
ACT
HEIGHT OF CEILING
FROM FLOOR &
CEILING MATERIAL

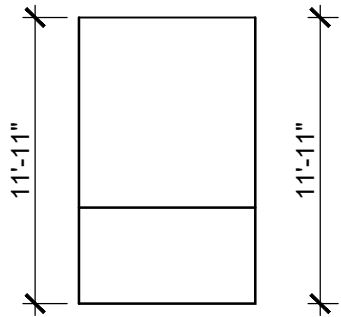


1 INTERIOR ELEVATION

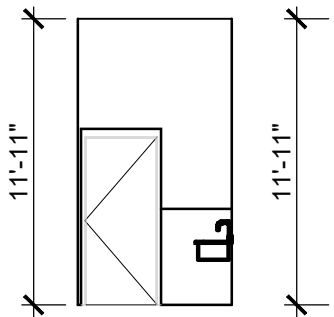


2 INTERIOR ELEVATION

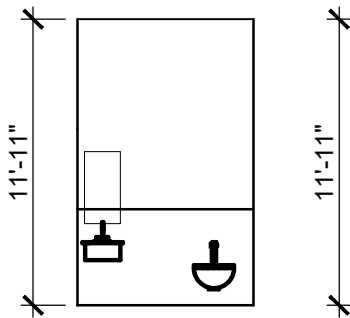


3 INTERIOR ELEVATION

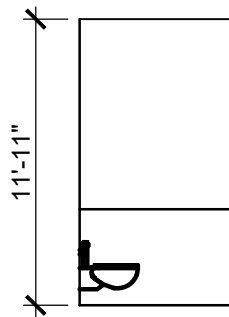


4 INTERIOR ELEVATION

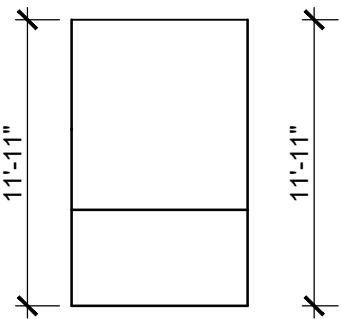


5 INTERIOR ELEVATION

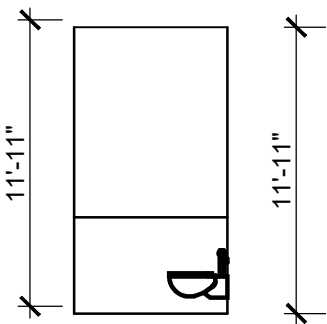

6 INTERIOR ELEVATION

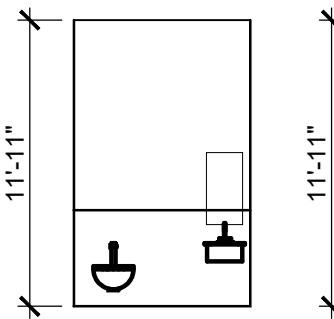


7 INTERIOR ELEVATION

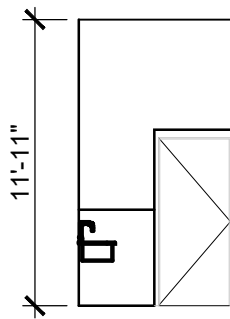


8 INTERIOR ELEVATION

- | | | | | | |
|---|----------|----|------------------|----|--------------------|
| 1 | STUCCO | 6 | ENTRY DOOR | 11 | TILE |
| 2 | GRANITE | 7 | BUILDING SIGNAGE | 12 | METAL SIDING |
| 3 | BRICK | 8 | GLAZING | 13 | ROOFING - SHINGLES |
| 4 | CONCRETE | 9 | LIGHT FIXTURE | 14 | METAL CURTAIN |
| 5 | CMU | 10 | STONE | 15 | METAL GUARDRAIL |

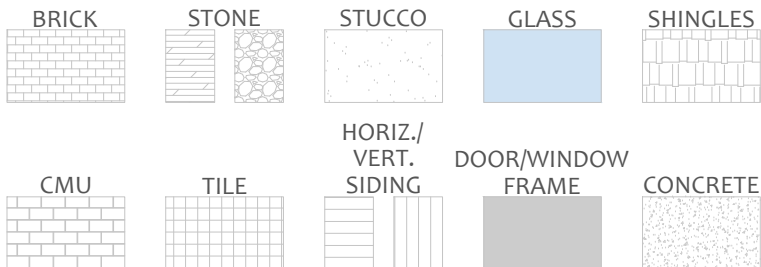

SCALE: 1/8" = 1'-0"

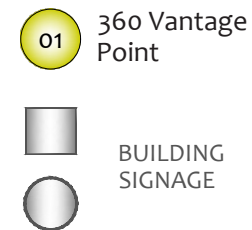

OWNER:

CLIENT:




Arktech Solutions LLC.
10804 Inside Loop
Orlando, FL 32825
tel: (407) 205-7787
www.ArktechSolution.com

FC NAME:	----
FCID:	N/A
FC ADDRESS:	----- ----- -----


FIELD SURVEYOR:	----
PROJECT DIRECTOR:	M.Vanegas
CHECKED BY:	----
DATE COMPLETED:	12-23-2019

PROJECT NUMBER:	----
SHEET:	A005.1
DRAWING NUMBER:	16
OF:	41


DRAWING NAME:	INTERIOR ELEVATIONS
---------------	---------------------

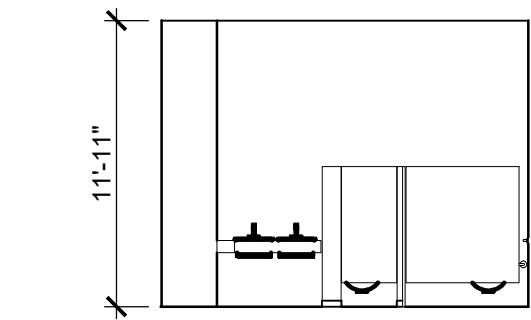


1 INTERIOR ELEVATION

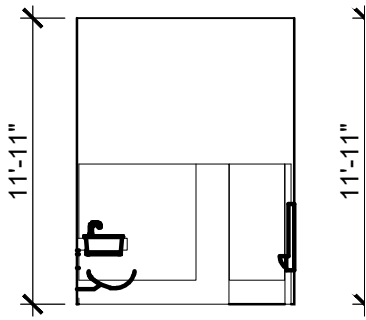


2 INTERIOR ELEVATION

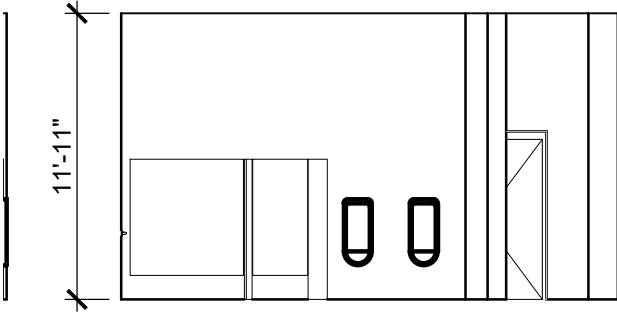


3 INTERIOR ELEVATION

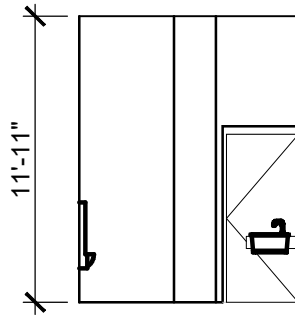


4 INTERIOR ELEVATION

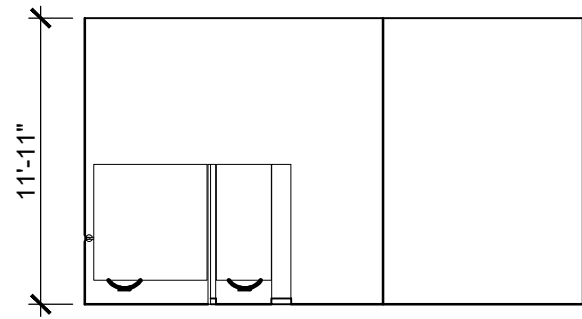


5 INTERIOR ELEVATION

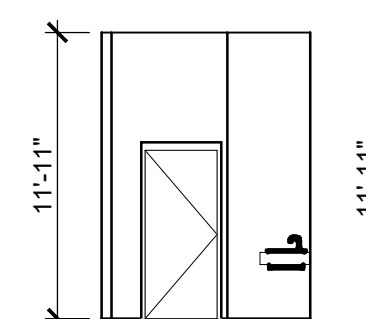

6 INTERIOR ELEVATION

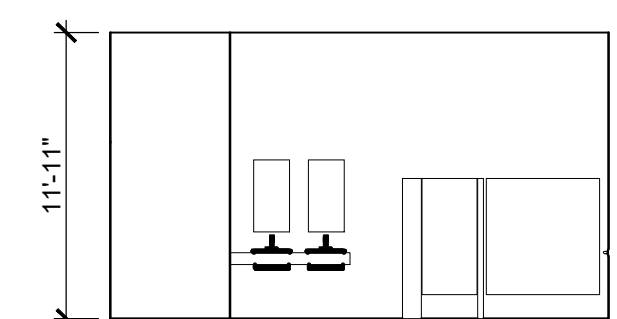


7 INTERIOR ELEVATION

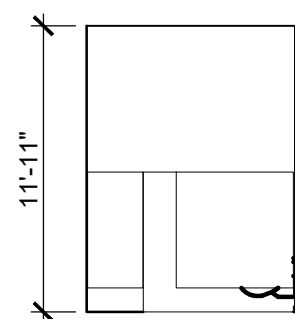


8 INTERIOR ELEVATION

- | | | | | | |
|---|----------|----|------------------|----|--------------------|
| 1 | STUCCO | 6 | ENTRY DOOR | 11 | TILE |
| 2 | GRANITE | 7 | BUILDING SIGNAGE | 12 | METAL SIDING |
| 3 | BRICK | 8 | GLAZING | 13 | ROOFING - SHINGLES |
| 4 | CONCRETE | 9 | LIGHT FIXTURE | 14 | METAL CURTAIN |
| 5 | CMU | 10 | STONE | 15 | METAL GUARDRAIL |

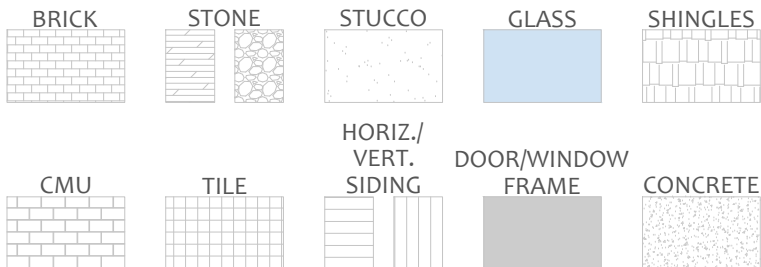

SCALE: 1/8" = 1'-0"

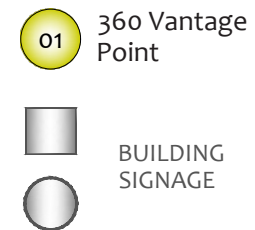

OWNER:

CLIENT:




Arktech Solutions LLC.
10804 Inside Loop
Orlando, FL 32825
tel: (407) 205-7787
www.ArktechSolution.com

FC NAME:	----
FCID:	N/A
FC ADDRESS:	----- ----- -----


FIELD SURVEYOR:	----
PROJECT DIRECTOR:	M.Vanegas
CHECKED BY:	----
DATE COMPLETED:	12-23-2019

PROJECT NUMBER:	----
SHEET:	A005.2
DRAWING NUMBER:	17
OF:	41


DRAWING NAME:
INTERIOR ELEVATIONS

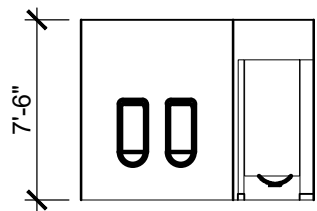


1 INTERIOR ELEVATION

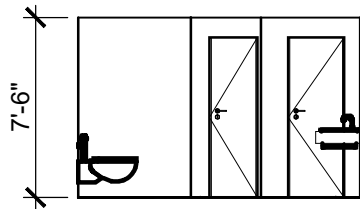


2 INTERIOR ELEVATION

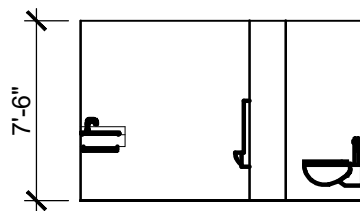


3 INTERIOR ELEVATION

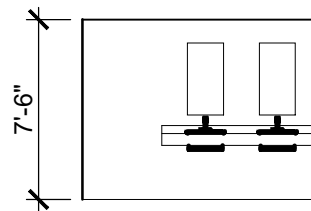


4 INTERIOR ELEVATION

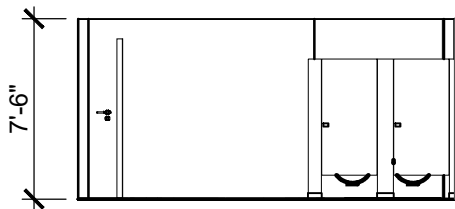


5 INTERIOR ELEVATION

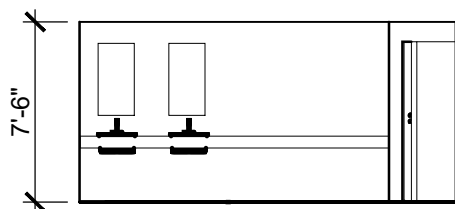

6 INTERIOR ELEVATION

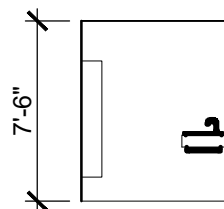


7 INTERIOR ELEVATION

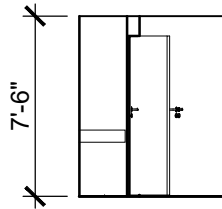


8 INTERIOR ELEVATION

- | | | | | | |
|---|----------|----|------------------|----|--------------------|
| 1 | STUCCO | 6 | ENTRY DOOR | 11 | TILE |
| 2 | GRANITE | 7 | BUILDING SIGNAGE | 12 | METAL SIDING |
| 3 | BRICK | 8 | GLAZING | 13 | ROOFING - SHINGLES |
| 4 | CONCRETE | 9 | LIGHT FIXTURE | 14 | METAL CURTAIN |
| 5 | CMU | 10 | STONE | 15 | METAL GUARDRAIL |

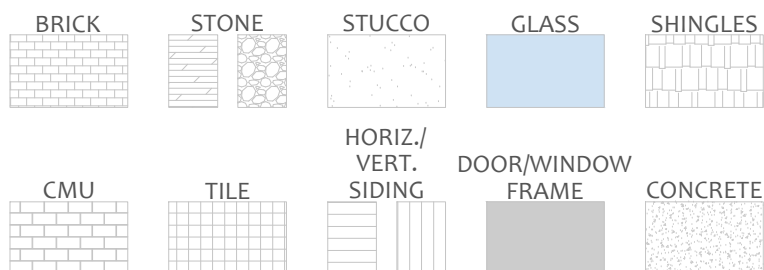

SCALE: 1/8" = 1'-0"

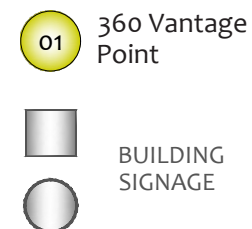

OWNER:

CLIENT:




Arktech Solutions LLC.
10804 Inside Loop
Orlando, FL 32825
tel: (407) 205-7787
www.ArktechSolution.com

FC NAME:	----
FCID:	N/A
FC ADDRESS:	----- ----- -----


FIELD SURVEYOR:	----
PROJECT DIRECTOR:	M.Vanegas
CHECKED BY:	-----
DATE COMPLETED:	12-23-2019

PROJECT NUMBER:	----
SHEET:	A005.3
DRAWING NUMBER:	18
OF:	41


DRAWING NAME:	INTERIOR ELEVATIONS
---------------	---------------------

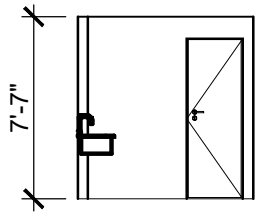


1 INTERIOR ELEVATION

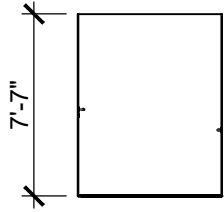


2 INTERIOR ELEVATION

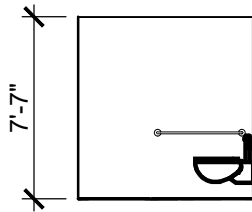


3 INTERIOR ELEVATION

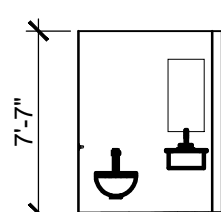


4 INTERIOR ELEVATION

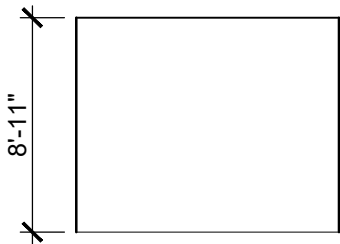


1 INTERIOR ELEVATION

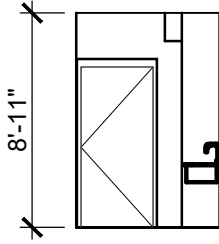

2 INTERIOR ELEVATION

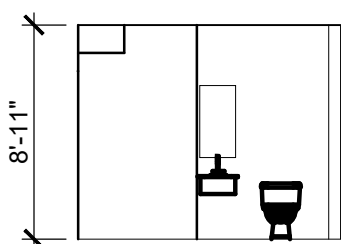


3 INTERIOR ELEVATION

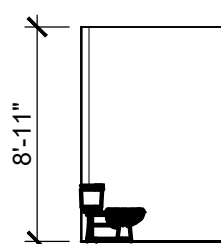


4 INTERIOR ELEVATION

- | | | | | | |
|---|----------|----|------------------|----|--------------------|
| 1 | STUCCO | 6 | ENTRY DOOR | 11 | TILE |
| 2 | GRANITE | 7 | BUILDING SIGNAGE | 12 | METAL SIDING |
| 3 | BRICK | 8 | GLAZING | 13 | ROOFING - SHINGLES |
| 4 | CONCRETE | 9 | LIGHT FIXTURE | 14 | METAL CURTAIN |
| 5 | CMU | 10 | STONE | 15 | METAL GUARDRAIL |

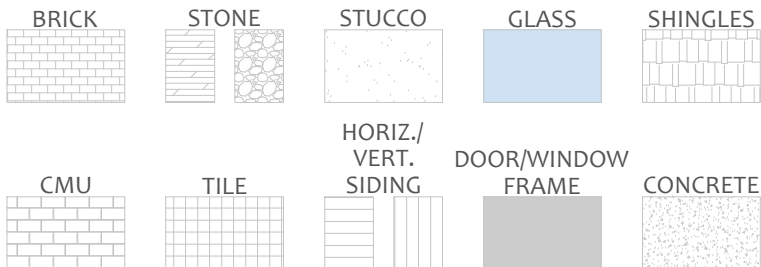

SCALE: 1/8" = 1'-0"

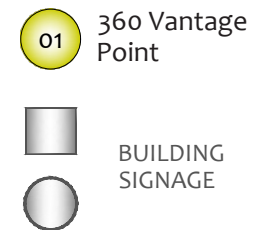

OWNER:

CLIENT:




Arktech Solutions LLC.
10804 Inside Loop
Orlando, FL 32825
tel: (407) 205-7787
www.ArktechSolution.com

FC NAME:	----
FCID:	N/A
FC ADDRESS:	----- ----- -----


FIELD SURVEYOR:	----
PROJECT DIRECTOR:	M.Vanegas
CHECKED BY:	----
DATE COMPLETED:	12-23-2019

PROJECT NUMBER:	----
SHEET:	A005.4
DRAWING NUMBER:	19
OF:	41


DRAWING NAME:	INTERIOR ELEVATIONS
---------------	---------------------

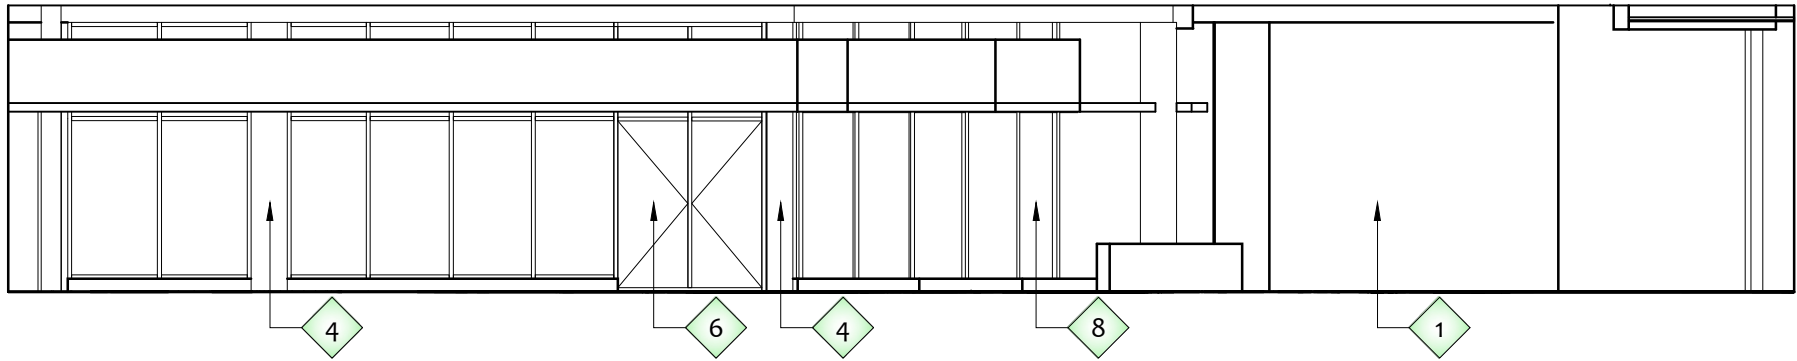


1 INTERIOR ELEVATION

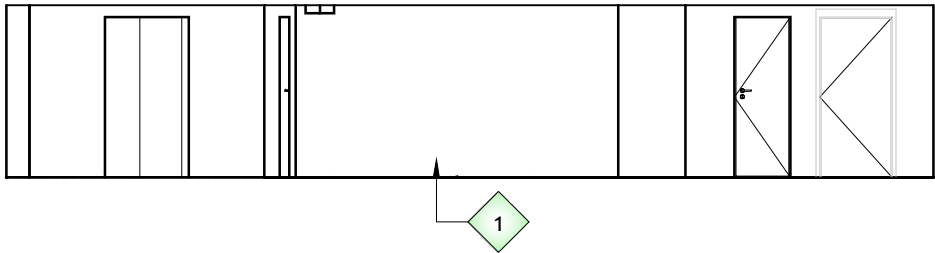


2 INTERIOR ELEVATION

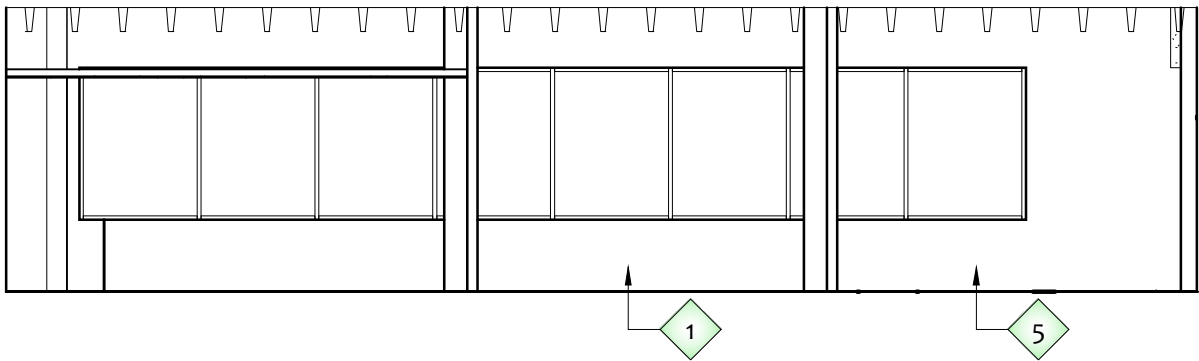

3 INTERIOR ELEVATION

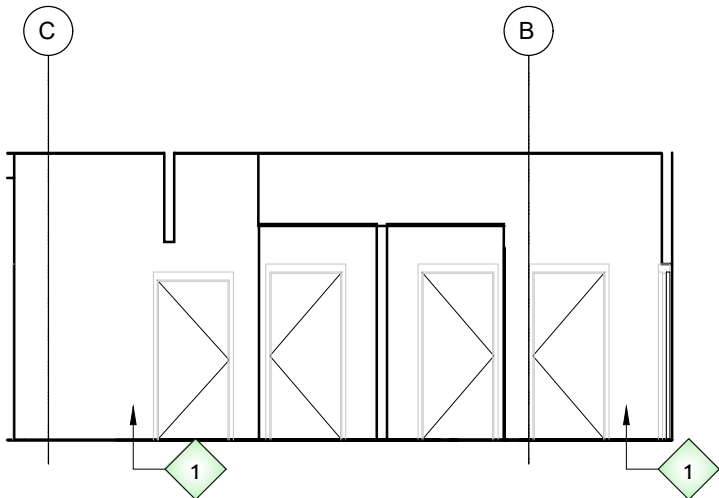


4 INTERIOR ELEVATION

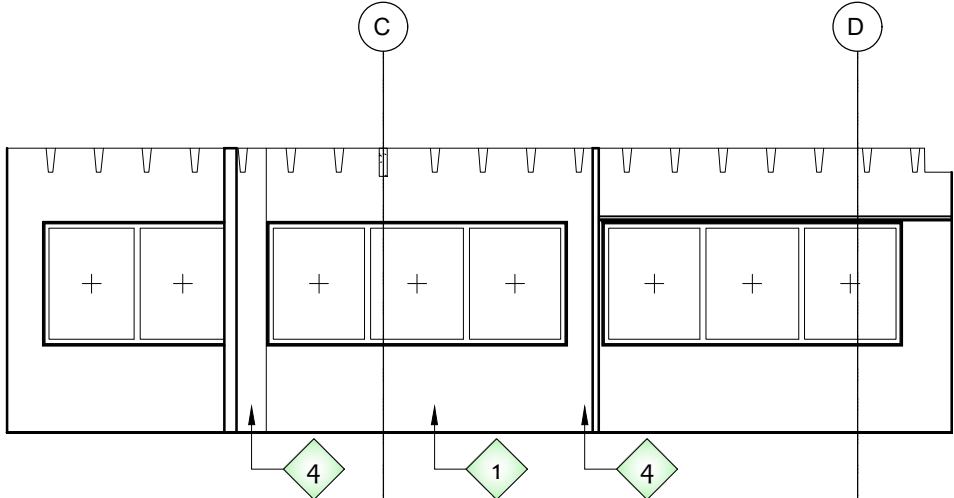


5 INTERIOR ELEVATION

- | | | |
|-------------------|--------------------|-----------------------|
| 1 STUCCO | 6 ENTRY DOOR | 11 TILE |
| 2 GRANITE | 7 BUILDING SIGNAGE | 12 METAL SIDING |
| 3 BRICK | 8 GLAZING | 13 ROOFING - SHINGLES |
| 4 CONCRETE COLUMN | 9 LIGHT FIXTURE | 14 METAL CURTAIN |
| 5 CMU | 10 STONE | 15 METAL GUARDRAIL |

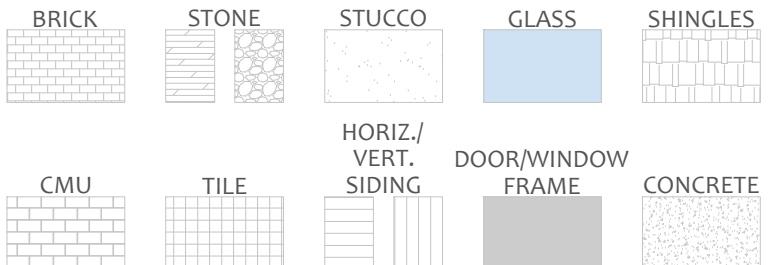

SCALE: 1/8" = 1'-0"

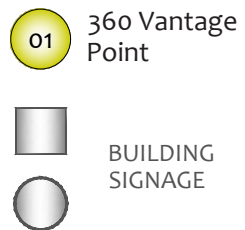


OWNER:

CLIENT:



Arktech Solutions LLC.
10804 Inside Loop
Orlando, FL 32825
tel: (407) 205-7787
www.ArktechSolution.com

FC NAME:	----
FCID:	N/A
FC ADDRESS:	----- ----- -----
FIELD SURVEYOR:	----
PROJECT DIRECTOR:	M.Vanegas
CHECKED BY:	----
DATE COMPLETED:	12-23-2019
PROJECT NUMBER:	----
SHEET:	A005.5
DRAWING NUMBER:	20
OF:	41
DRAWING NAME:	INTERIOR ELEVATIONS

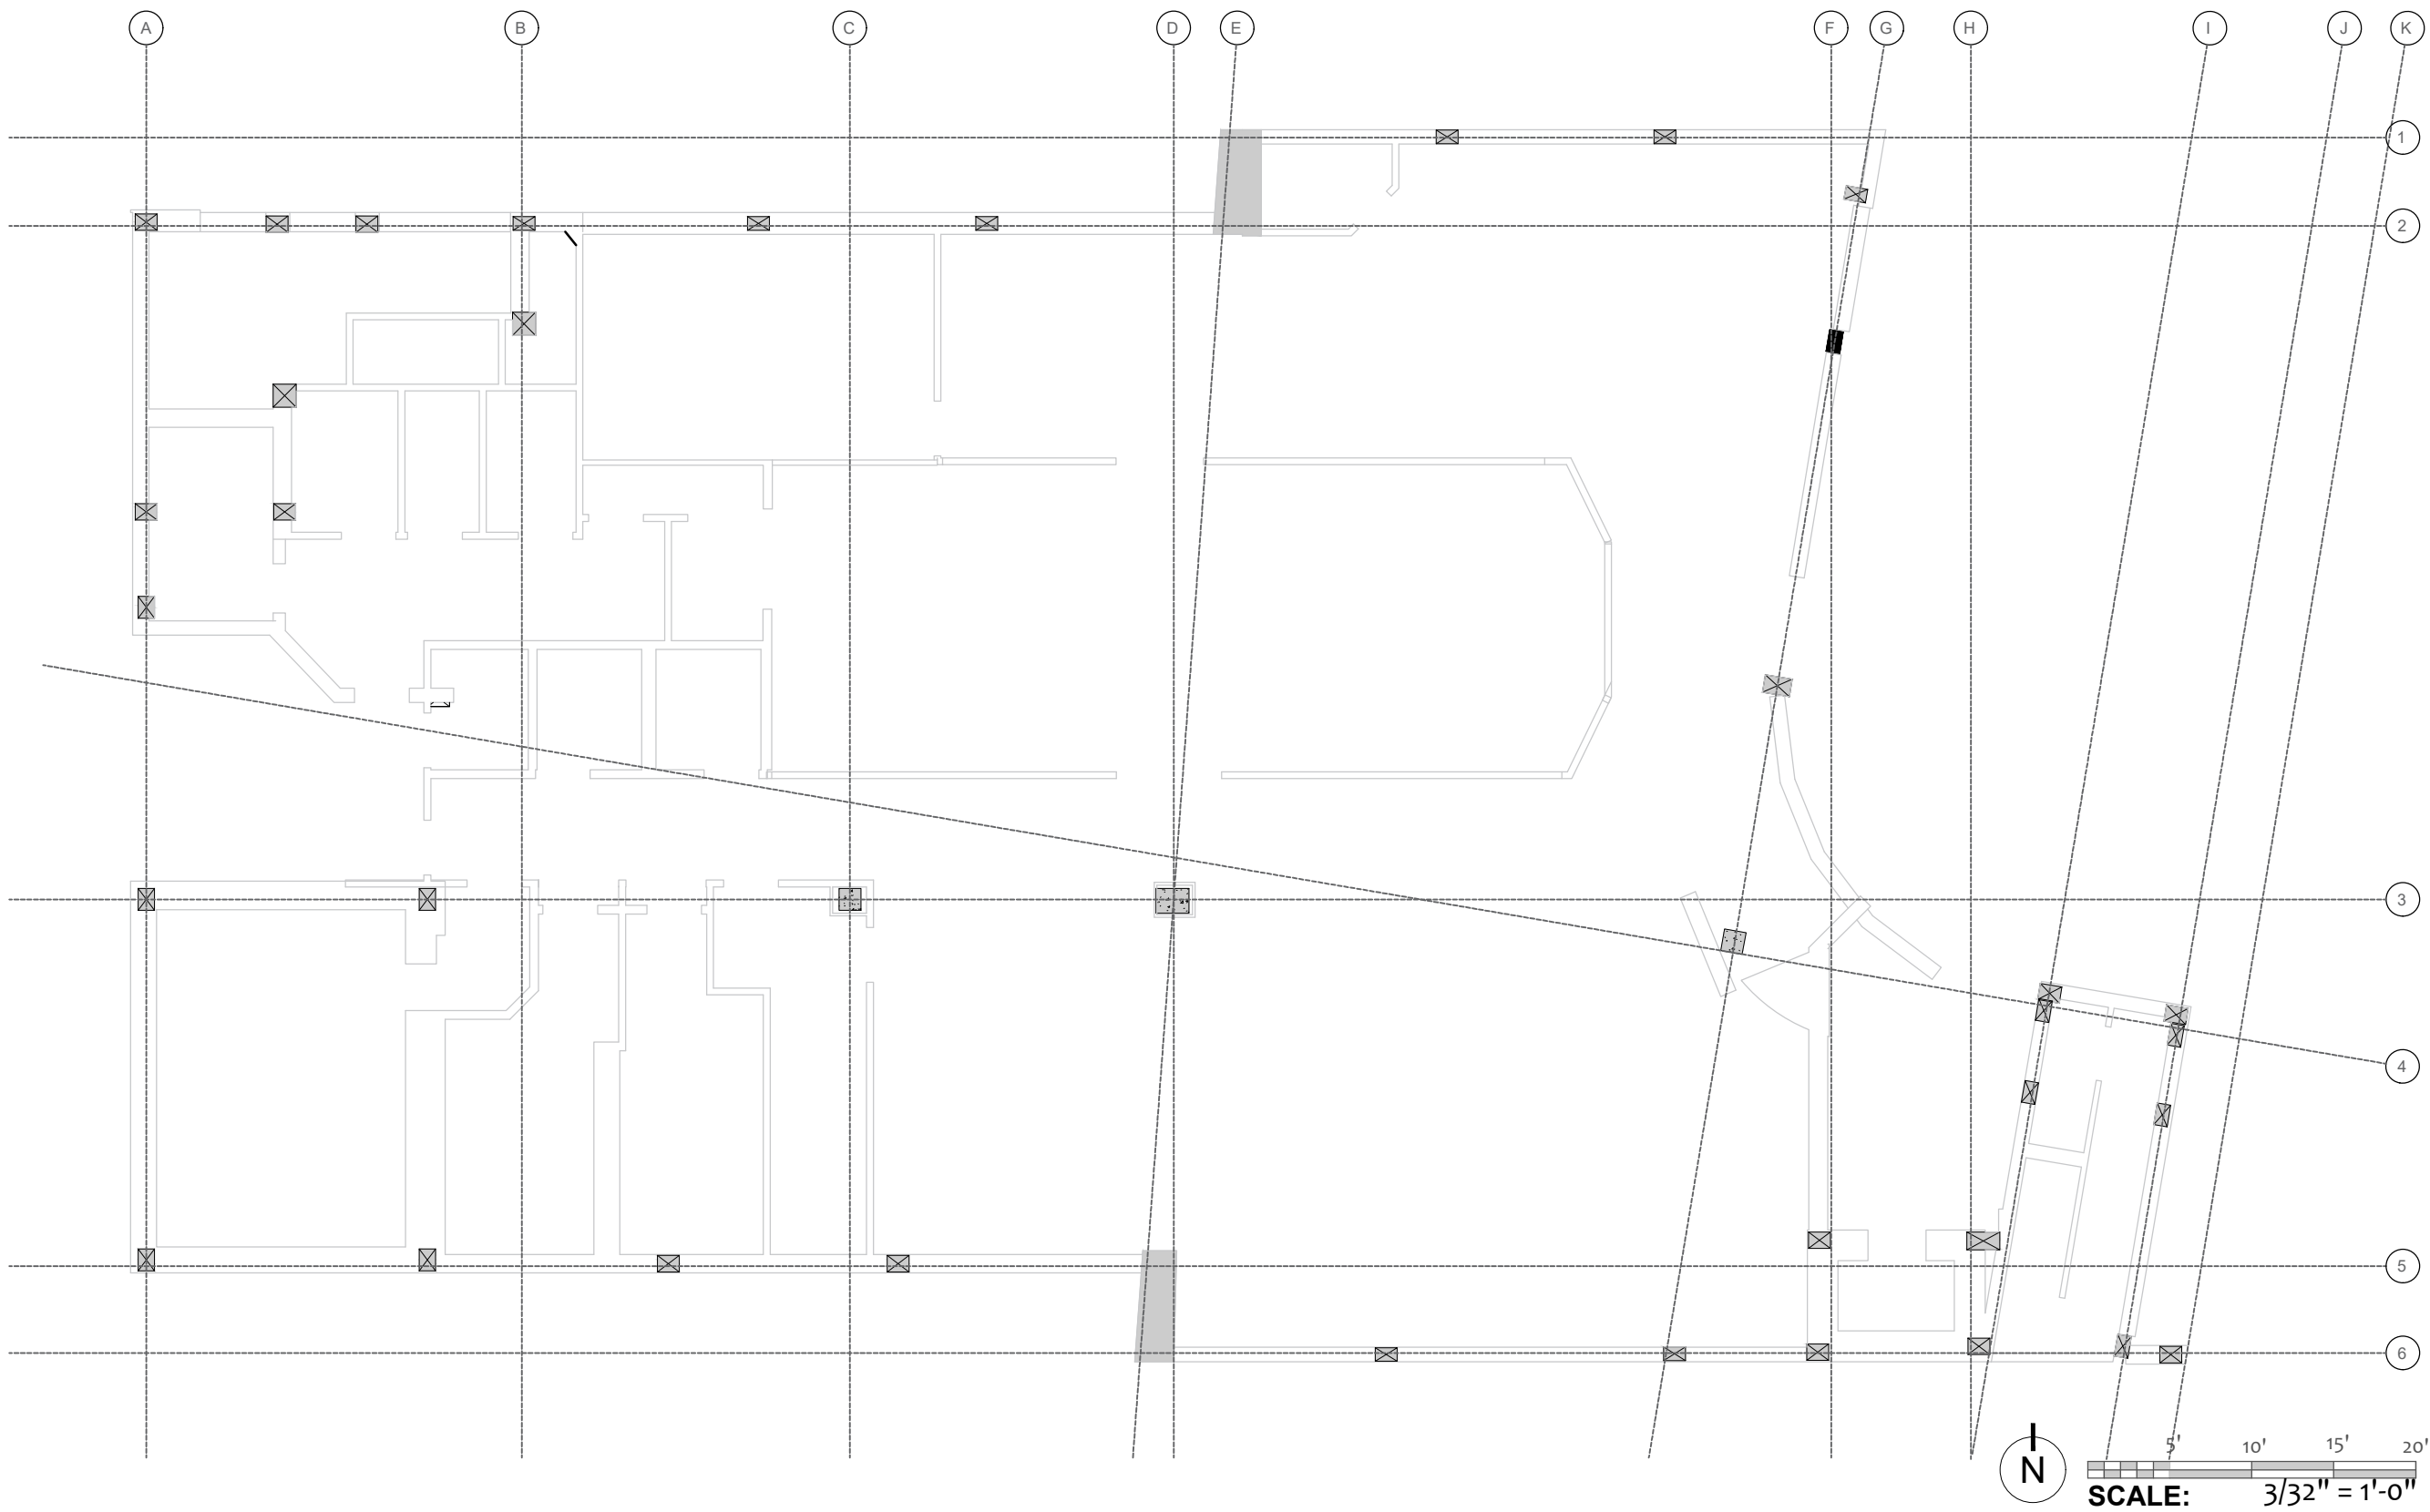

- 01 360 Vantage Point (Web Link)
- 01 Still Photo
- 01 Red Flag Notification


OWNER:

CLIENT:



Arktech Solutions LLC.
10804 Inside Loop
Orlando, FL 32825
tel: (407) 205-7787
www.ArktechSolution.com

FC NAME:		----
FCID:		N/A
FC ADDRESS:		----- ----- -----
FIELD SURVEYOR:		----
PROJECT DIRECTOR:		M.Vanegas
CHECKED BY:		----
DATE COMPLETED:		12-23-2019
PROJECT NUMBER:		----
SHEET:		A006.1
DRAWING NUMBER:	OF:	21 41
DRAWING NAME: STRUCTURAL 1st FLOOR		

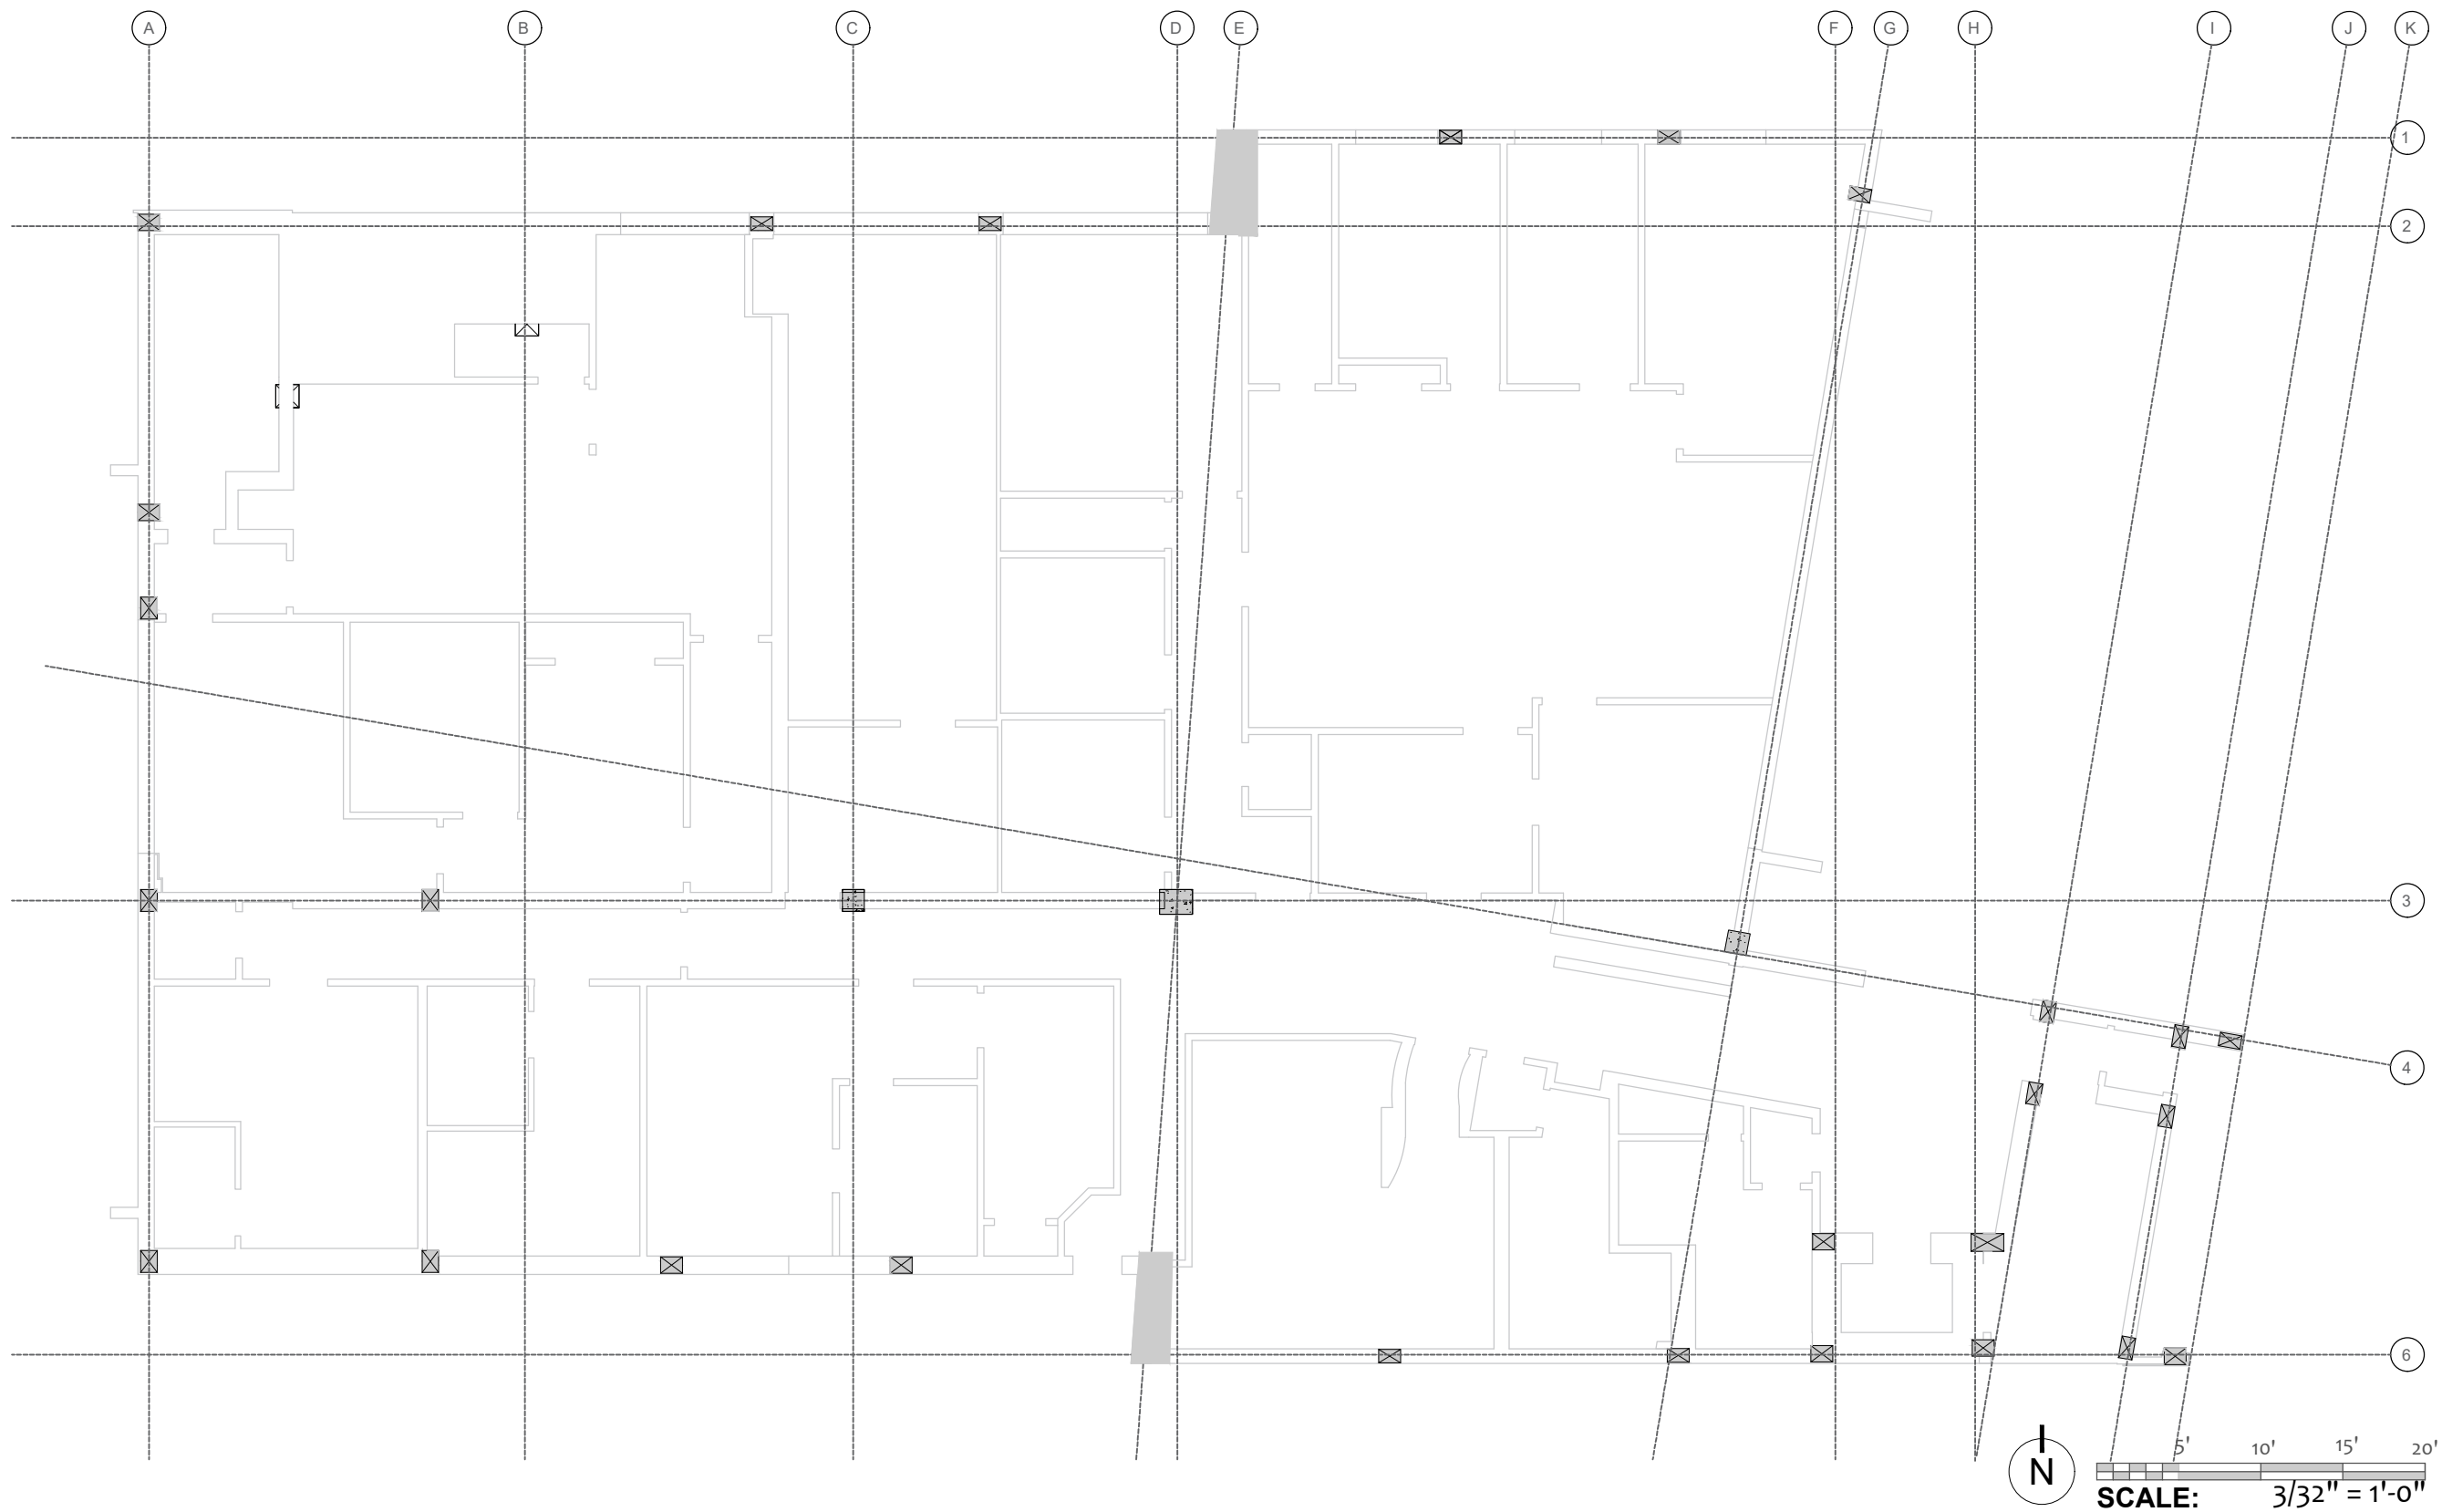

- 01 360 Vantage Point (Web Link)
- 01 Still Photo
- 01 Red Flag Notification


OWNER:

CLIENT:



Arktech Solutions LLC.
10804 Inside Loop
Orlando, FL 32825
tel: (407) 205-7787
www.ArktechSolution.com

FC NAME: ----	
FCID: N/A	
FC ADDRESS: ----- ----- -----	
FIELD SURVEYOR: ----	
PROJECT DIRECTOR: M.Vanegas	
CHECKED BY: ----	
DATE COMPLETED: 12-23-2019	
PROJECT NUMBER: ----	
SHEET: A006.2	
DRAWING NUMBER: 22	OF: 41
DRAWING NAME: STRUCTURAL 2nd FLOOR	

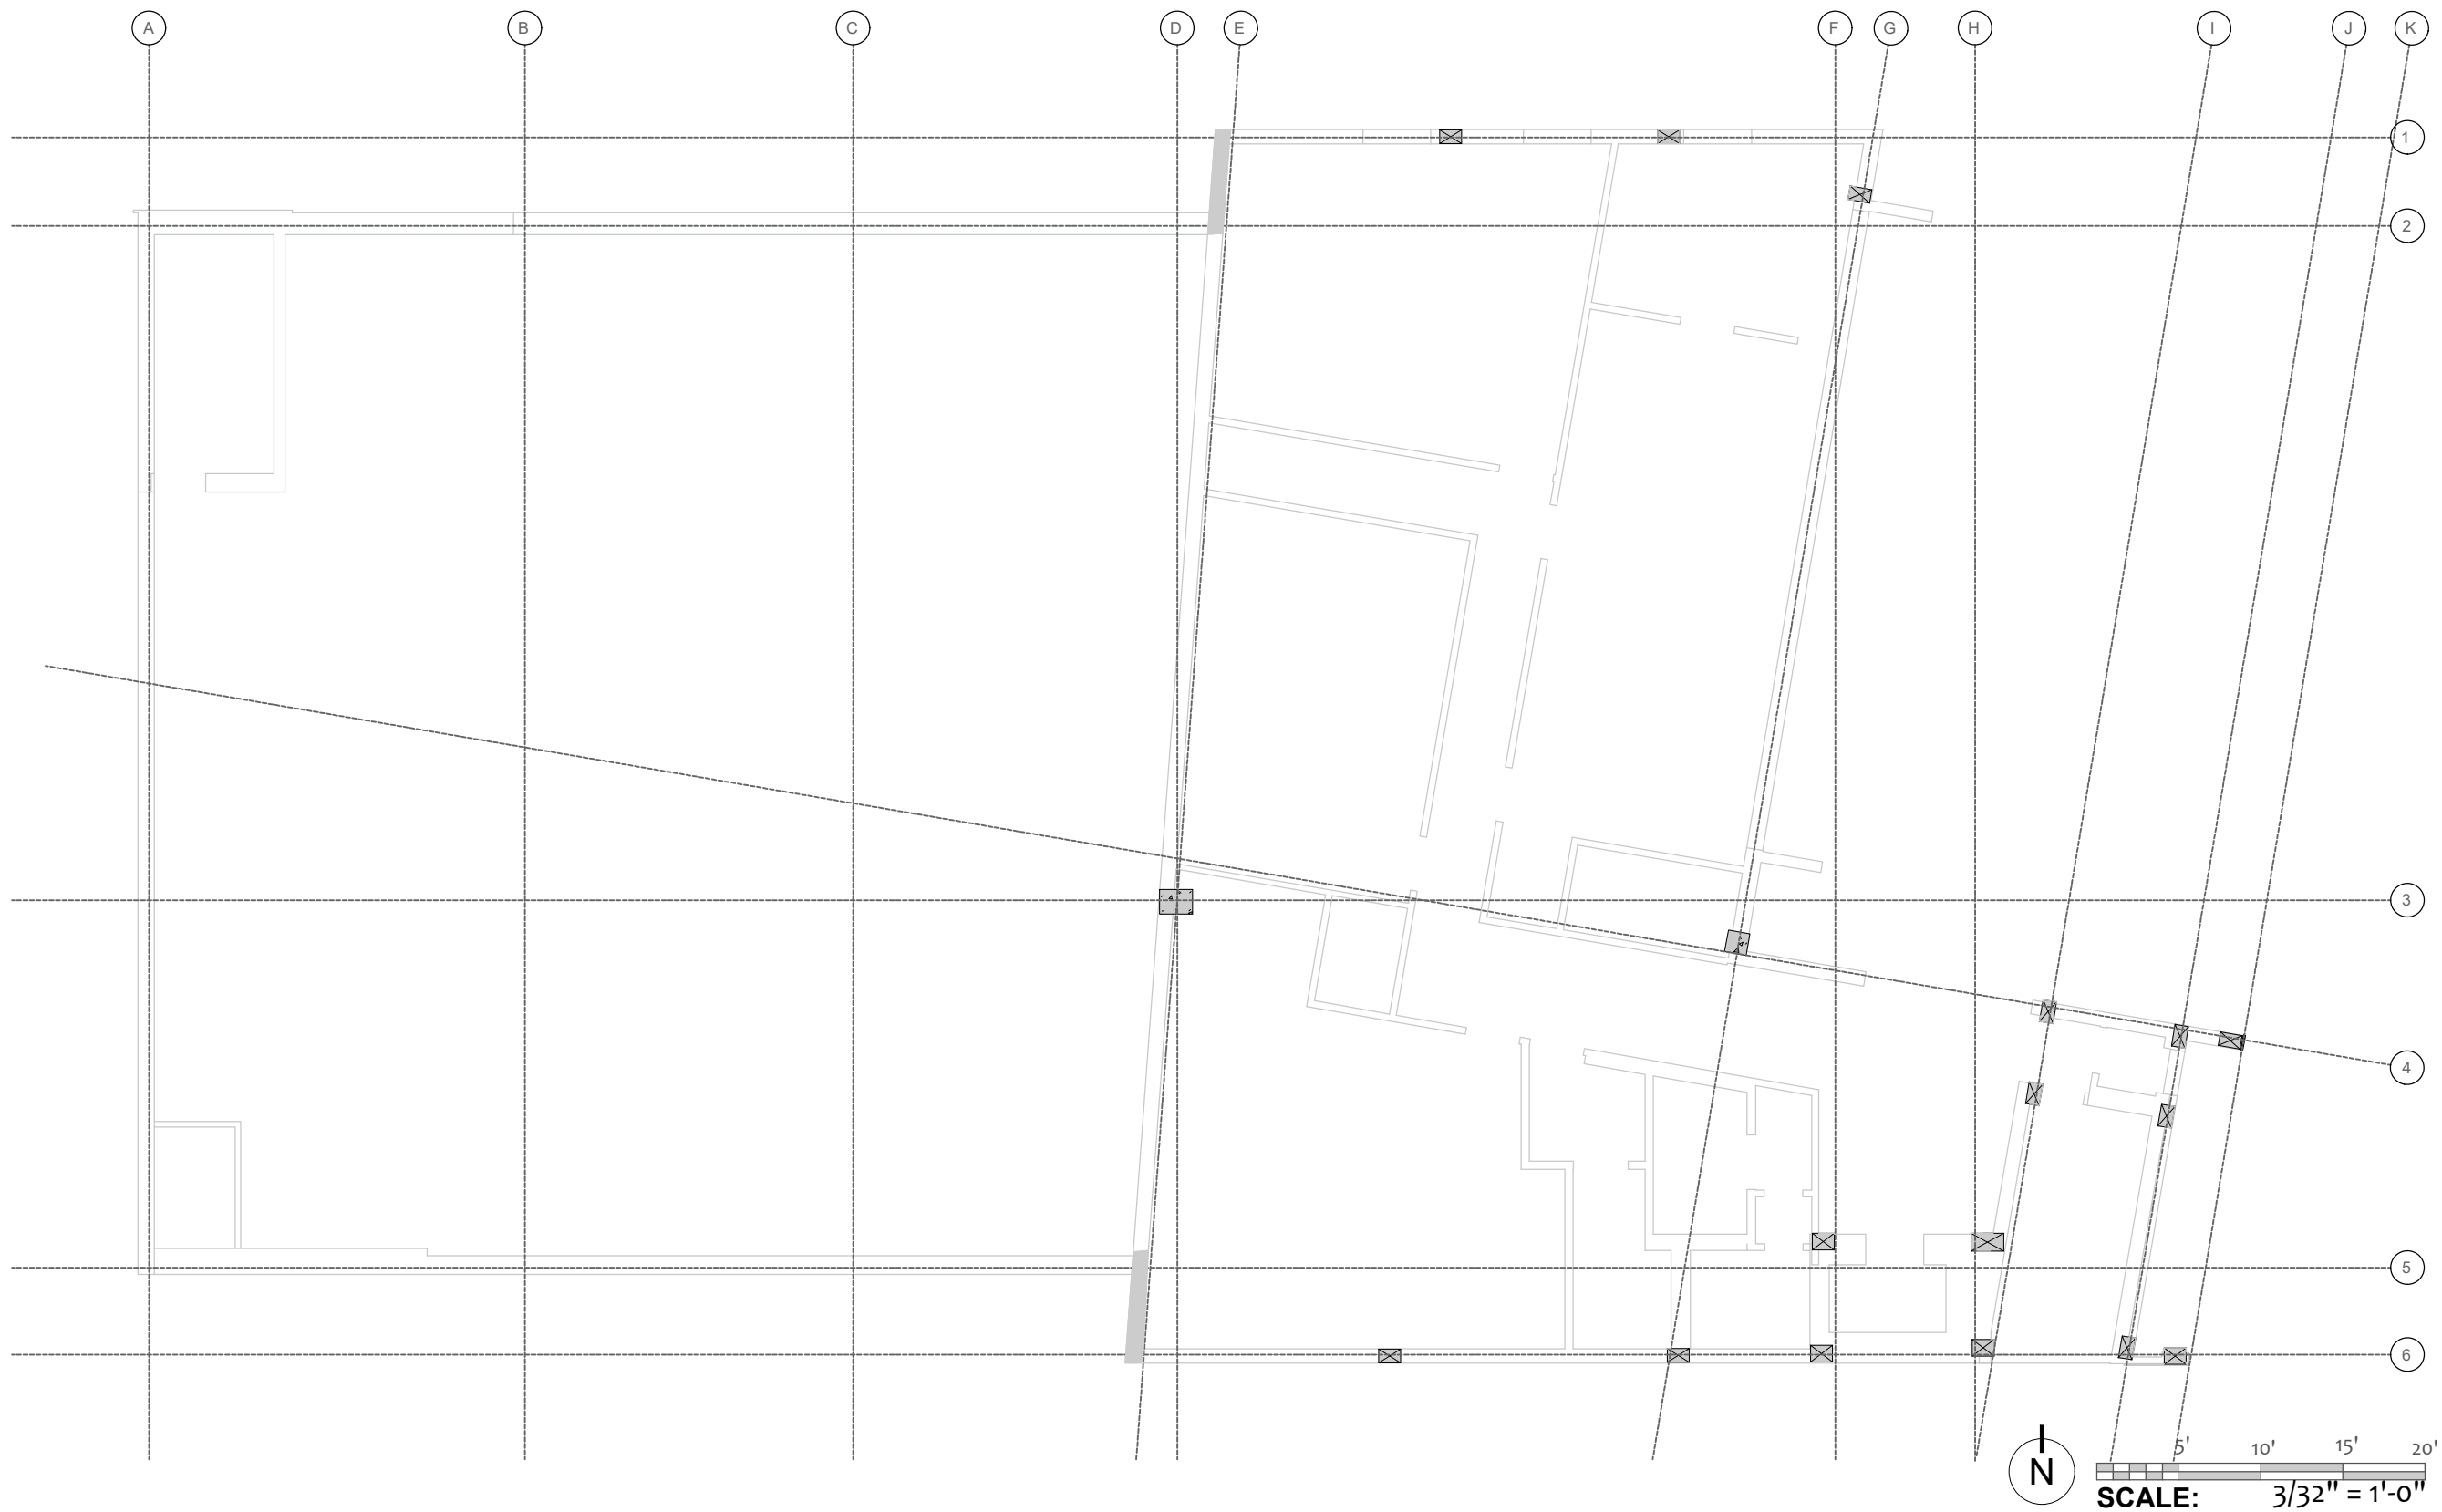

- 01 360 Vantage Point (Web Link)
- 01 Still Photo
- 01 Red Flag Notification


OWNER:

CLIENT:



Arktech Solutions LLC.
10804 Inside Loop
Orlando, FL 32825
tel: (407) 205-7787
www.ArktechSolution.com

FC NAME: ----	
FCID: N/A	
FC ADDRESS: ----- ----- -----	
FIELD SURVEYOR: ----	
PROJECT DIRECTOR: M.Vanegas	
CHECKED BY: ----	
DATE COMPLETED: 12-23-2019	
PROJECT NUMBER: ----	
SHEET: A006.3	
DRAWING NUMBER: 23	OF: 41
DRAWING NAME: STRUCTURAL 3rd FLOOR	

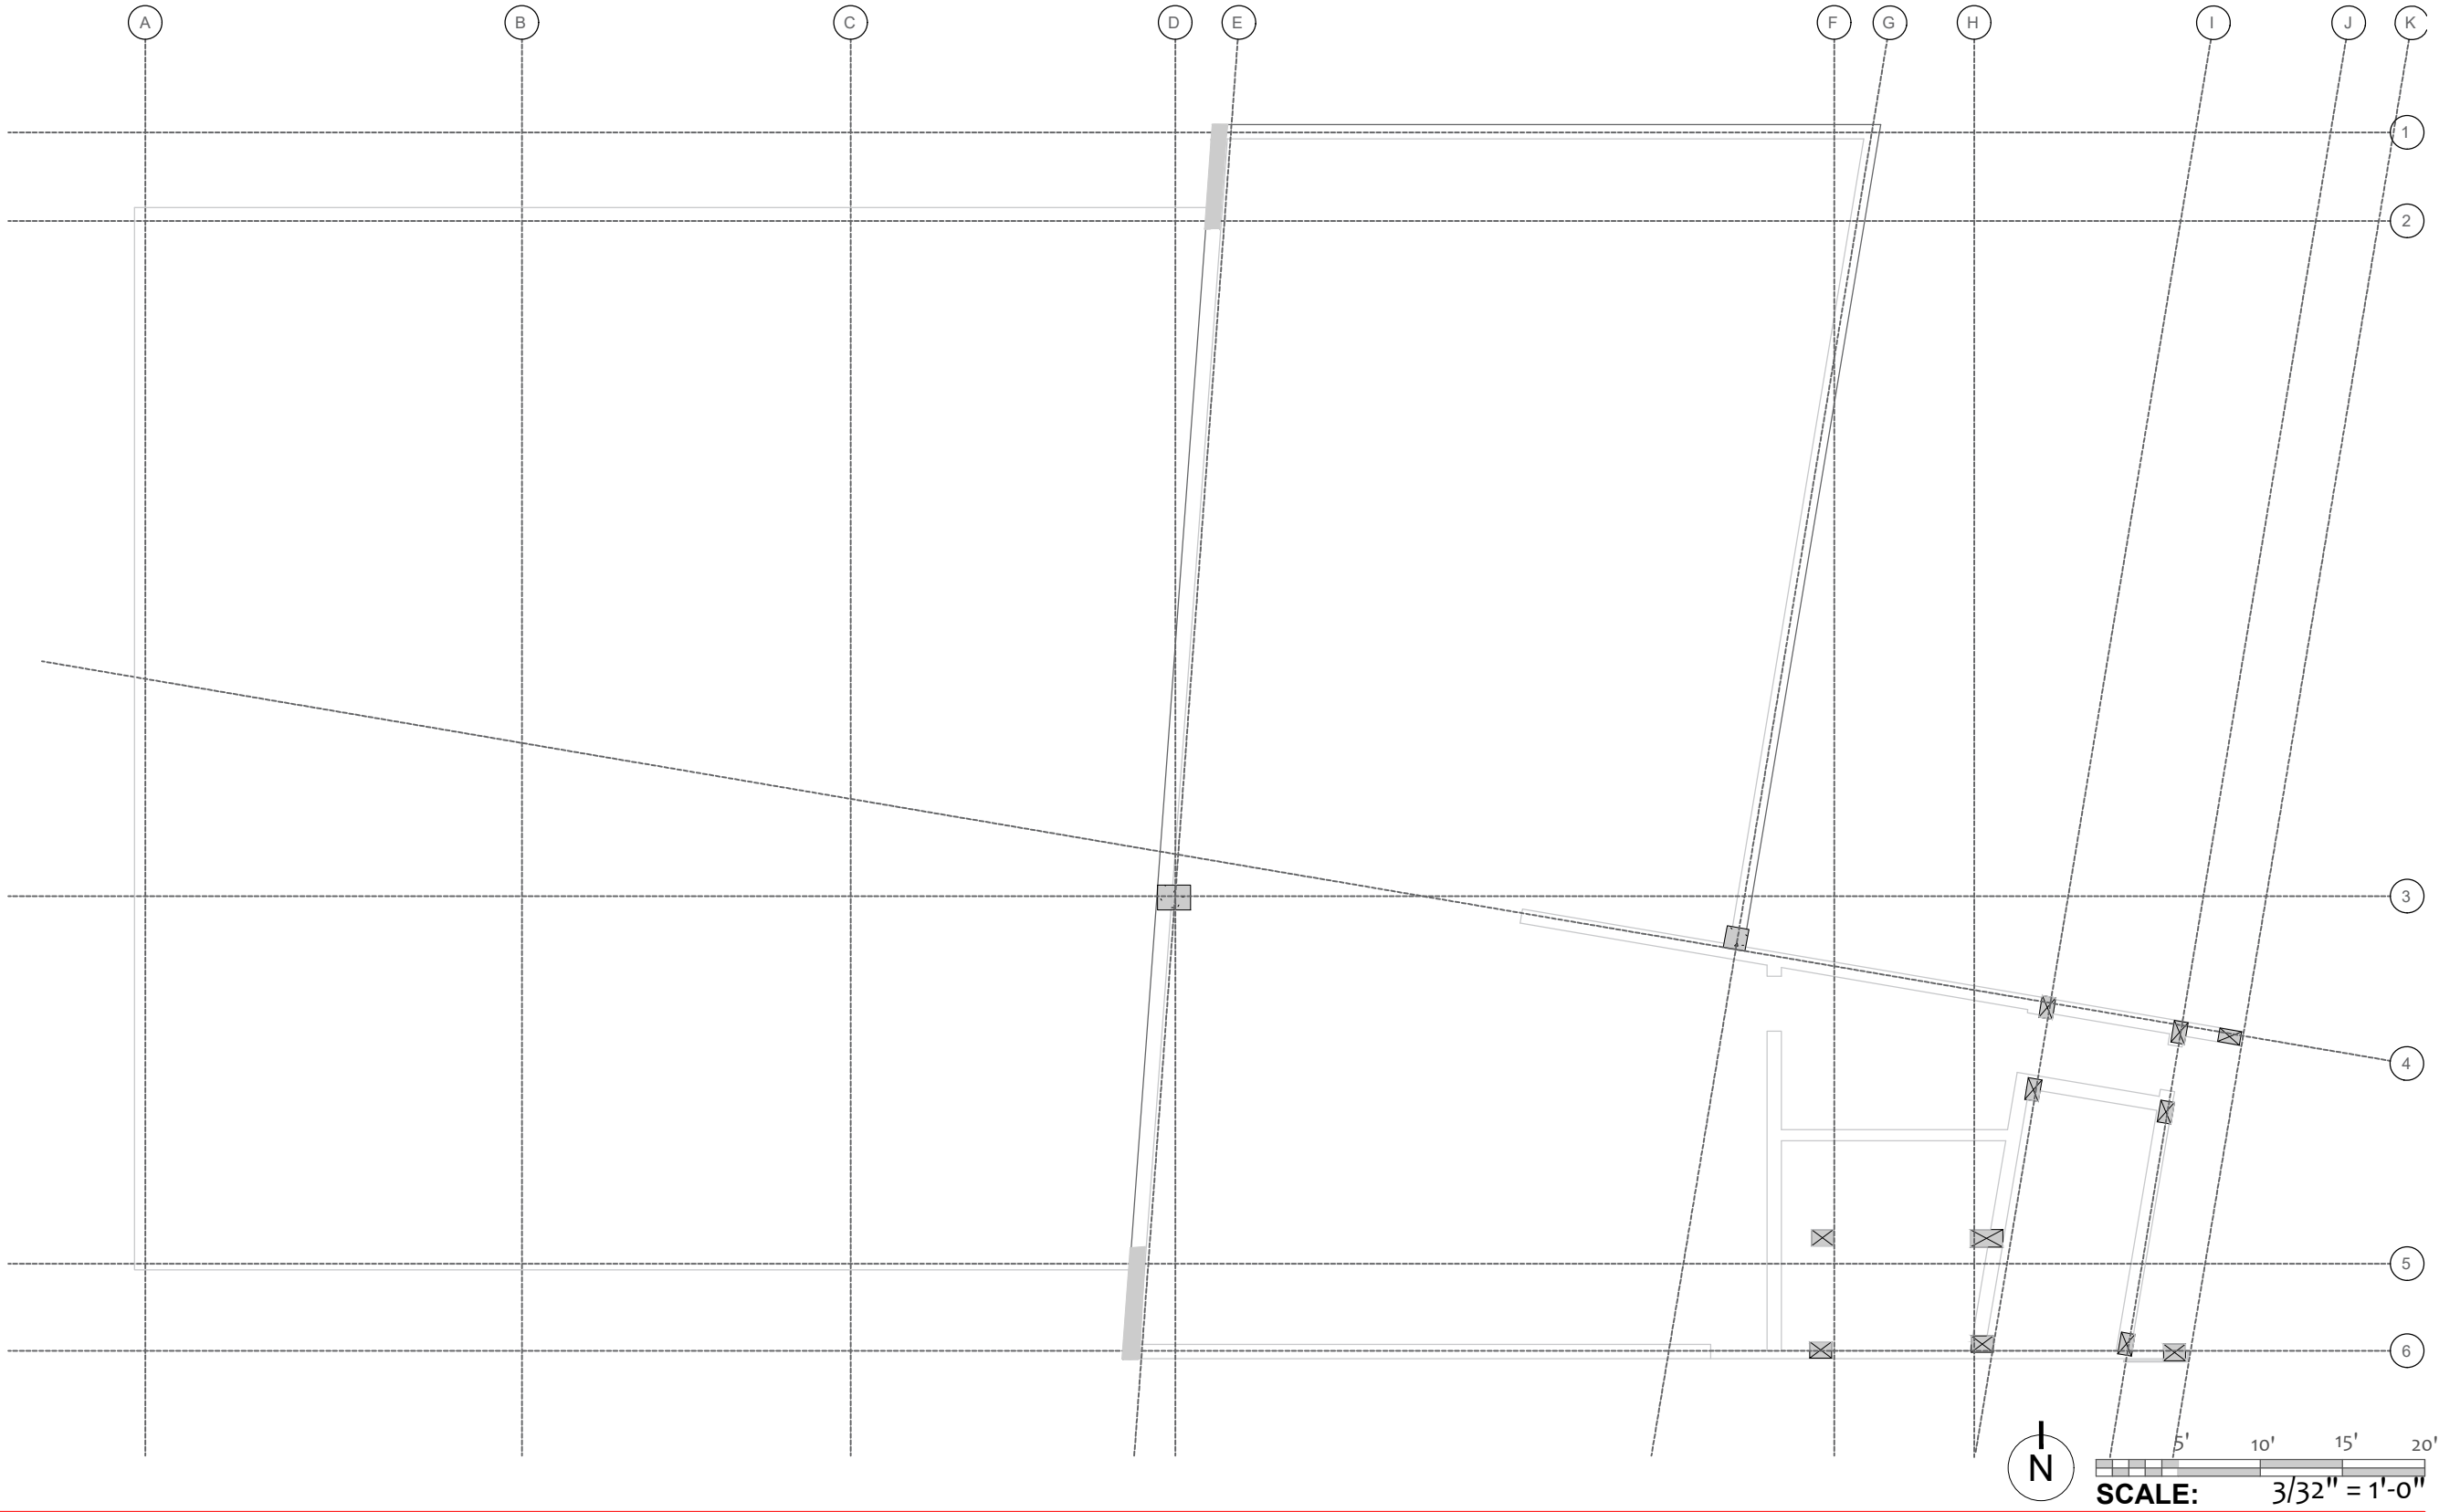

- 01 360 Vantage Point (Web Link)
- 01 Still Photo
- 01 Red Flag Notification


OWNER:

CLIENT:



Arktech Solutions LLC.
10804 Inside Loop
Orlando, FL 32825
tel: (407) 205-7787
www.ArktechSolution.com

FC NAME: ----	
FCID: N/A	
FC ADDRESS: ----- ----- -----	
FIELD SURVEYOR: ----	
PROJECT DIRECTOR: M.Vanegas	
CHECKED BY: -----	
DATE COMPLETED: 12-23-2019	
PROJECT NUMBER: ----	
SHEET: A006.4	
DRAWING NUMBER: 24	OF: 41
DRAWING NAME: STRUCTURAL PENTHOUSE	

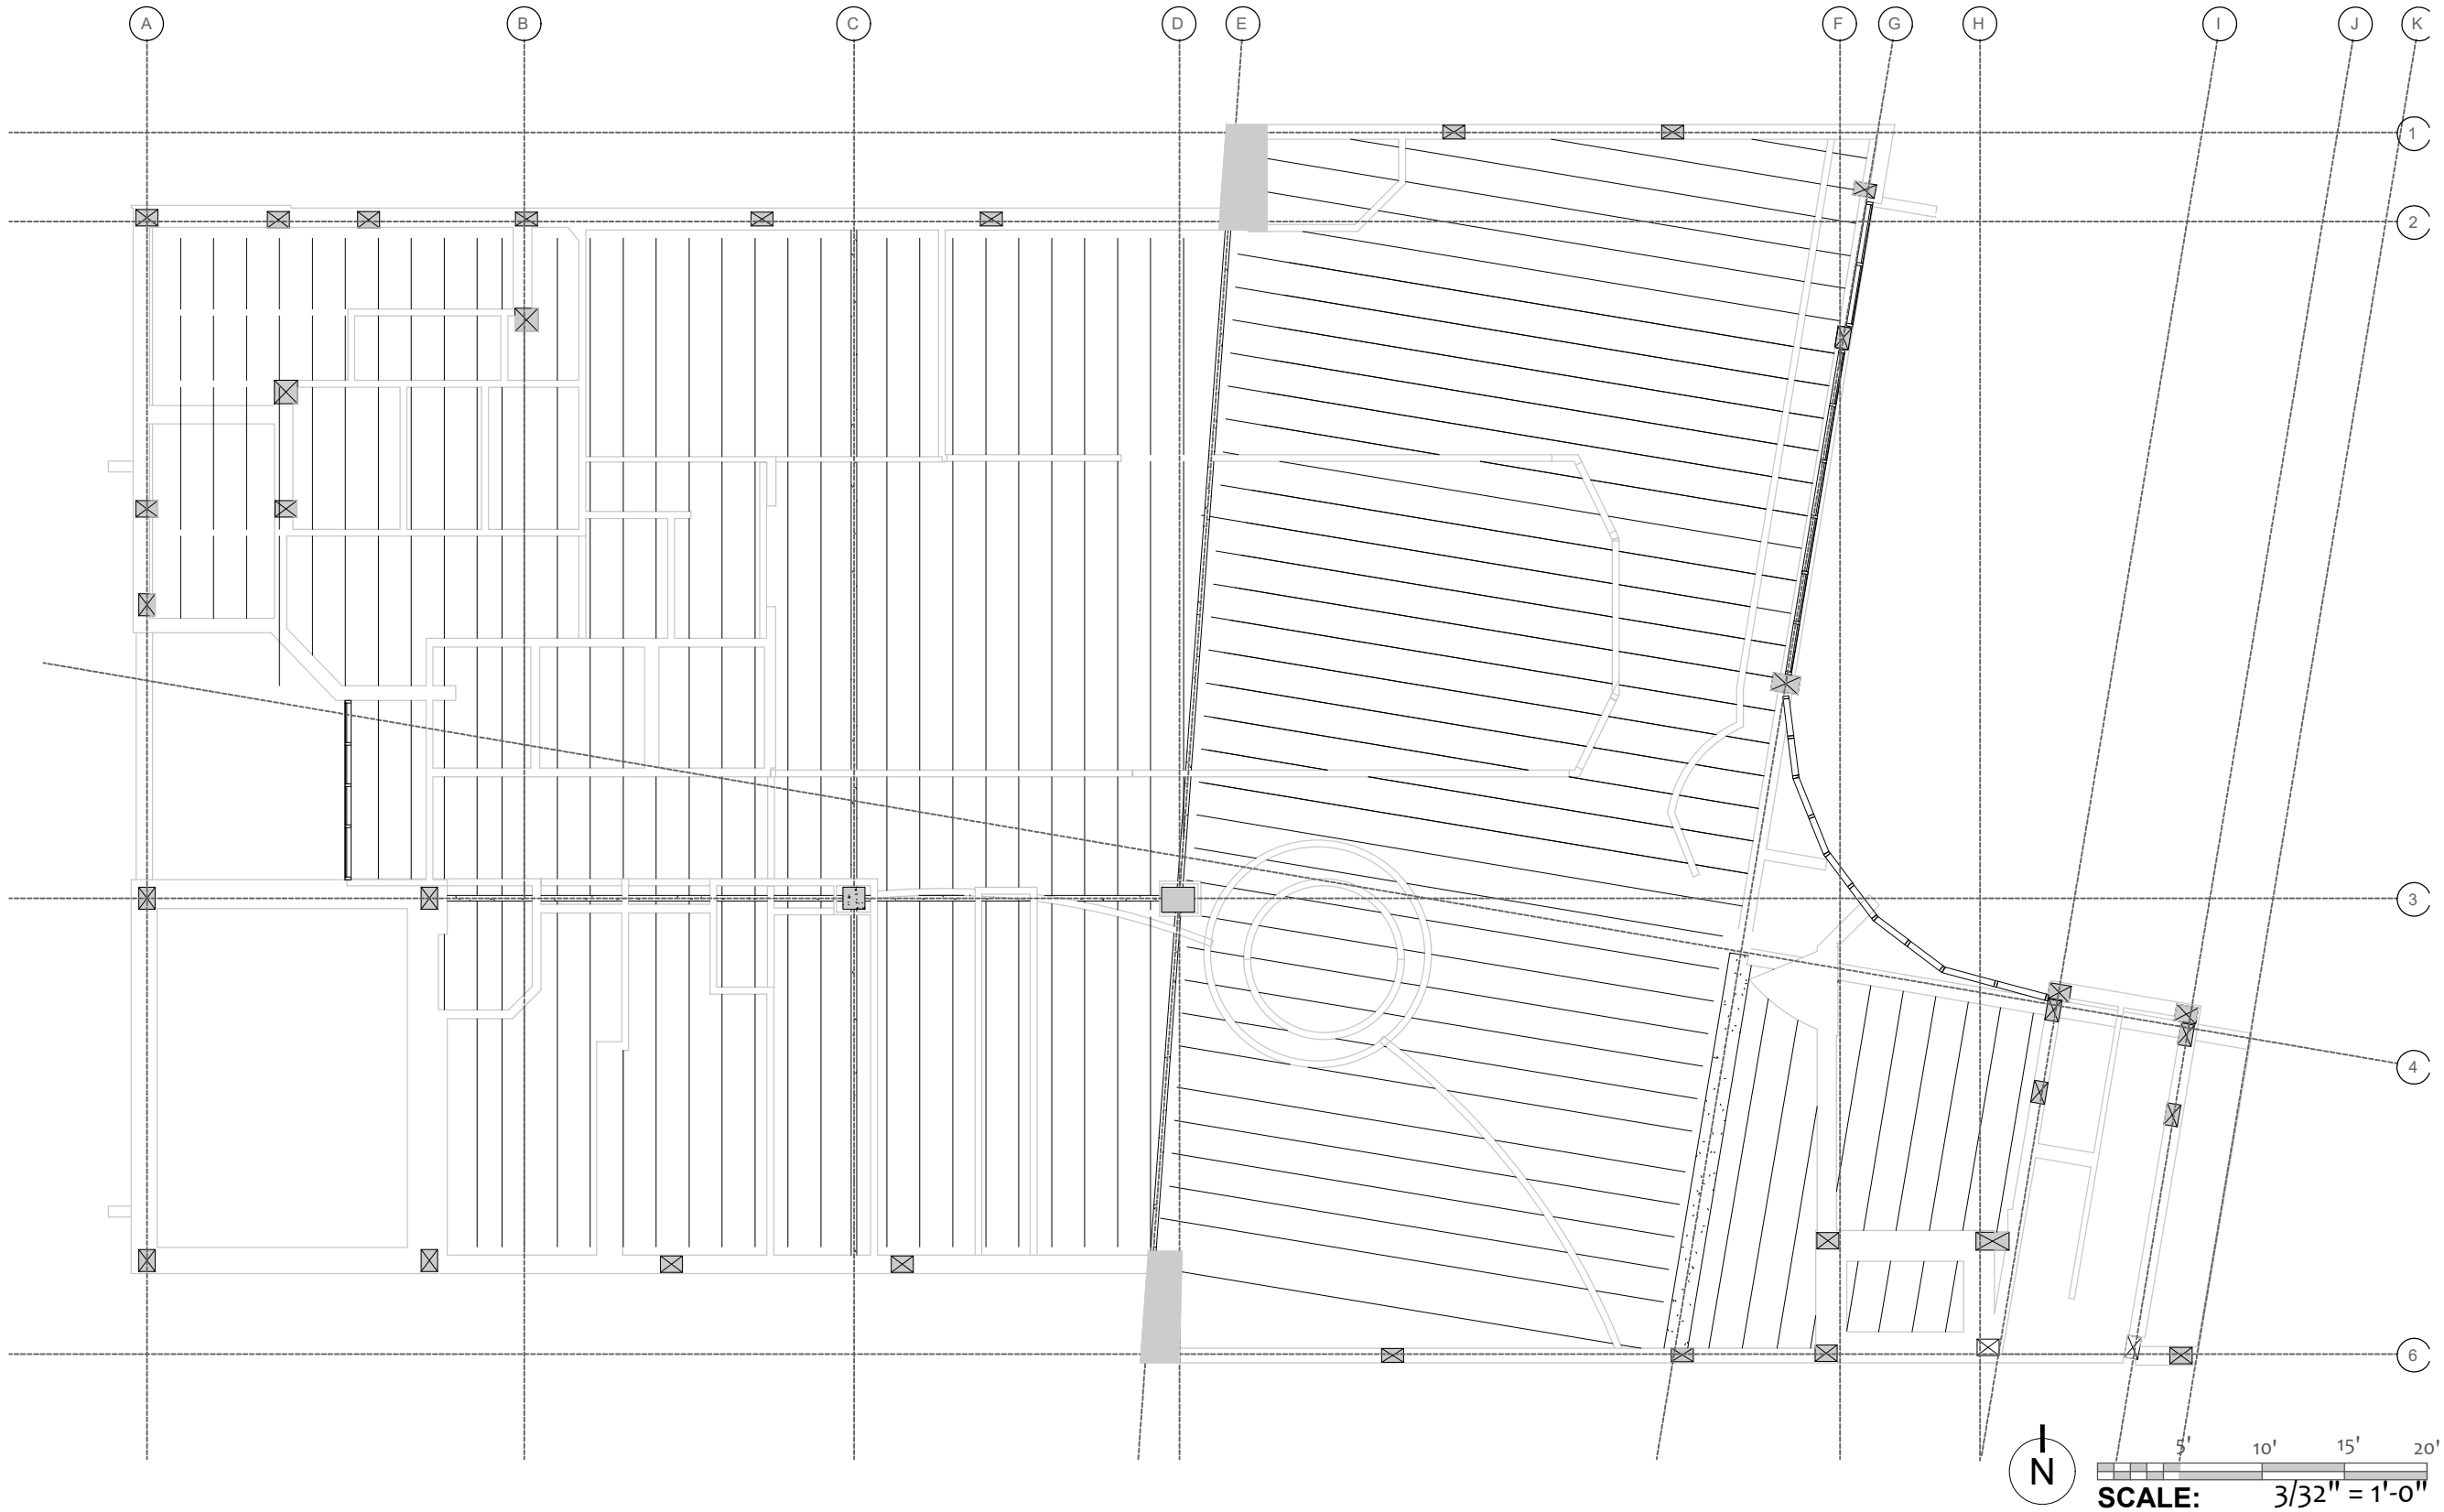

SCALE: 3/32" = 1'-0"

- 01 360 Vantage Point (Web Link)
- 01 Still Photo
- 01 Red Flag Notification

OWNER:

CLIENT:




Arktech Solutions LLC.
10804 Inside Loop
Orlando, FL 32825
tel: (407) 205-7787
www.ArktechSolution.com

FC NAME:	----
FCID:	N/A
FC ADDRESS:	----- ----- -----

FIELD SURVEYOR:	----
PROJECT DIRECTOR:	M.Vanegas
CHECKED BY:	----
DATE COMPLETED:	12-23-2019

PROJECT NUMBER:	----
SHEET:	A007.1
DRAWING NUMBER:	25
OF:	41

DRAWING NAME:	FRAMING PLAN 1st FL
---------------	---------------------

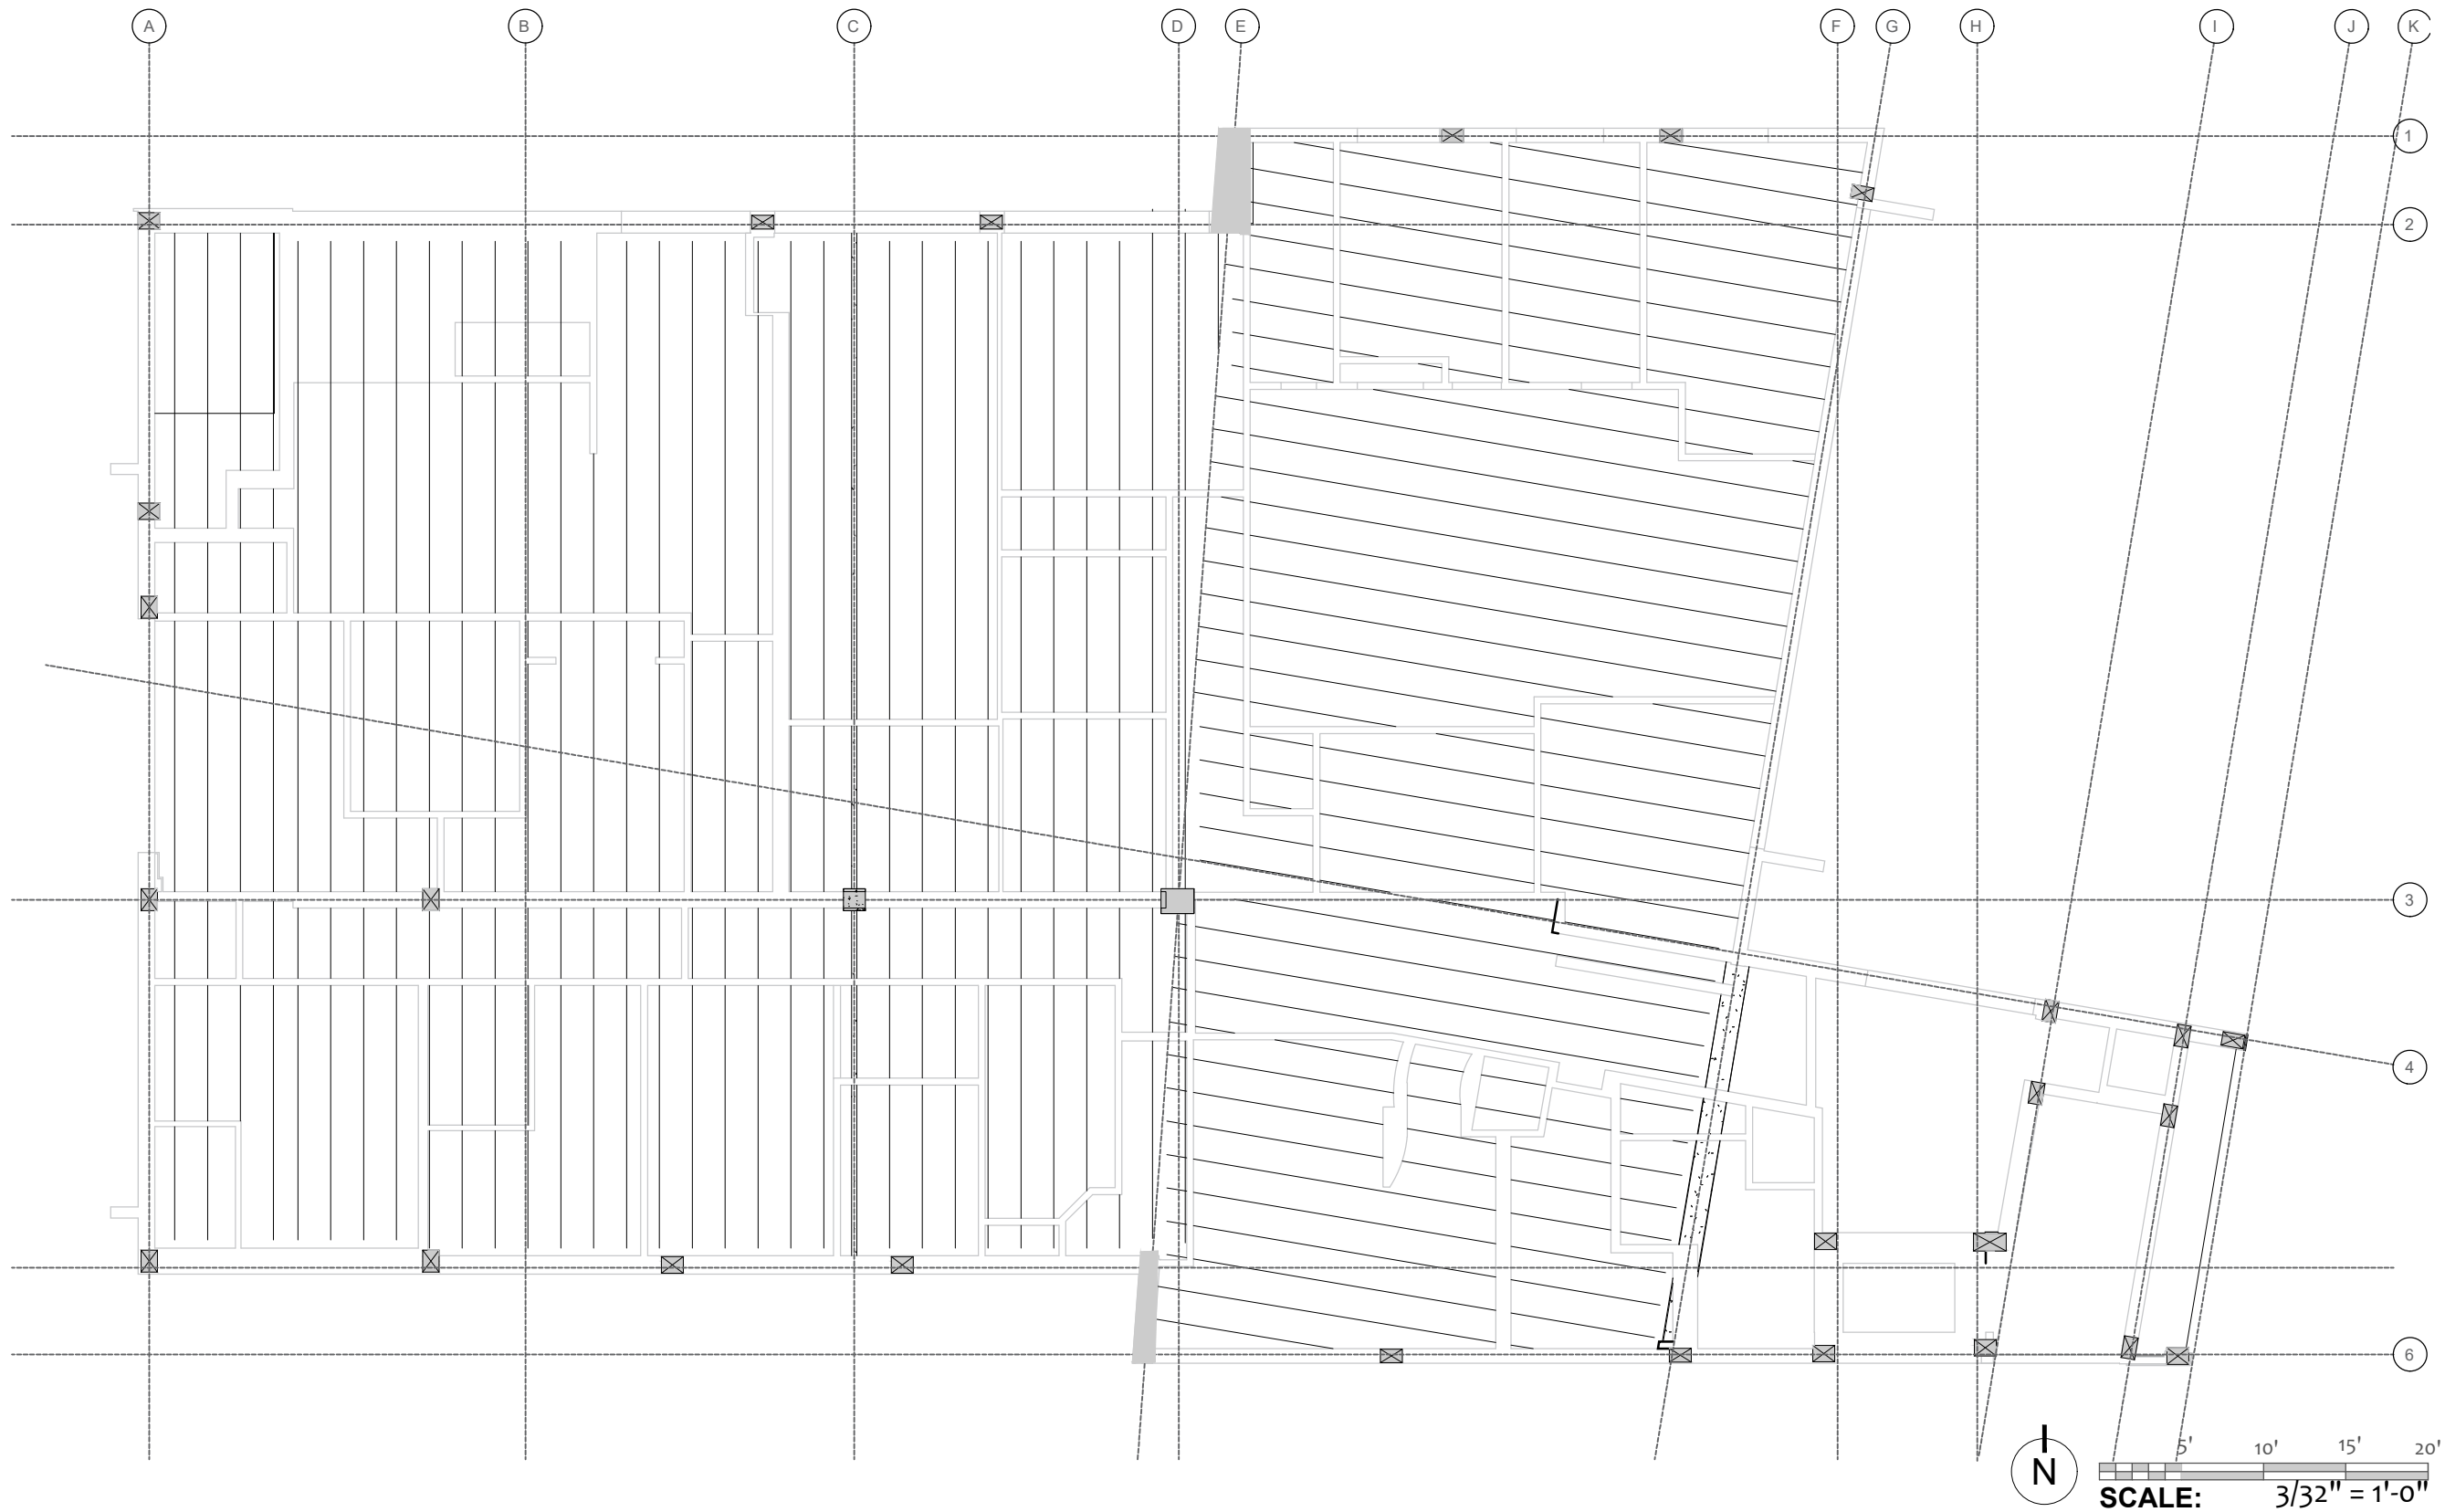

- 01 360 Vantage Point (Web Link)
- 01 Still Photo
- 01 Red Flag Notification


OWNER:

CLIENT:



Arktech Solutions LLC.
10804 Inside Loop
Orlando, FL 32825
tel: (407) 205-7787
www.ArktechSolution.com

FC NAME: ----	
FCID: N/A	
FC ADDRESS: ----- ----- -----	
FIELD SURVEYOR: ----	
PROJECT DIRECTOR: M.Vanegas	
CHECKED BY: ----	
DATE COMPLETED: 12-23-2019	
PROJECT NUMBER: ----	
SHEET: A007.2	
DRAWING NUMBER: 26	OF: 41
DRAWING NAME: FRAMING PLAN 2nd FL	

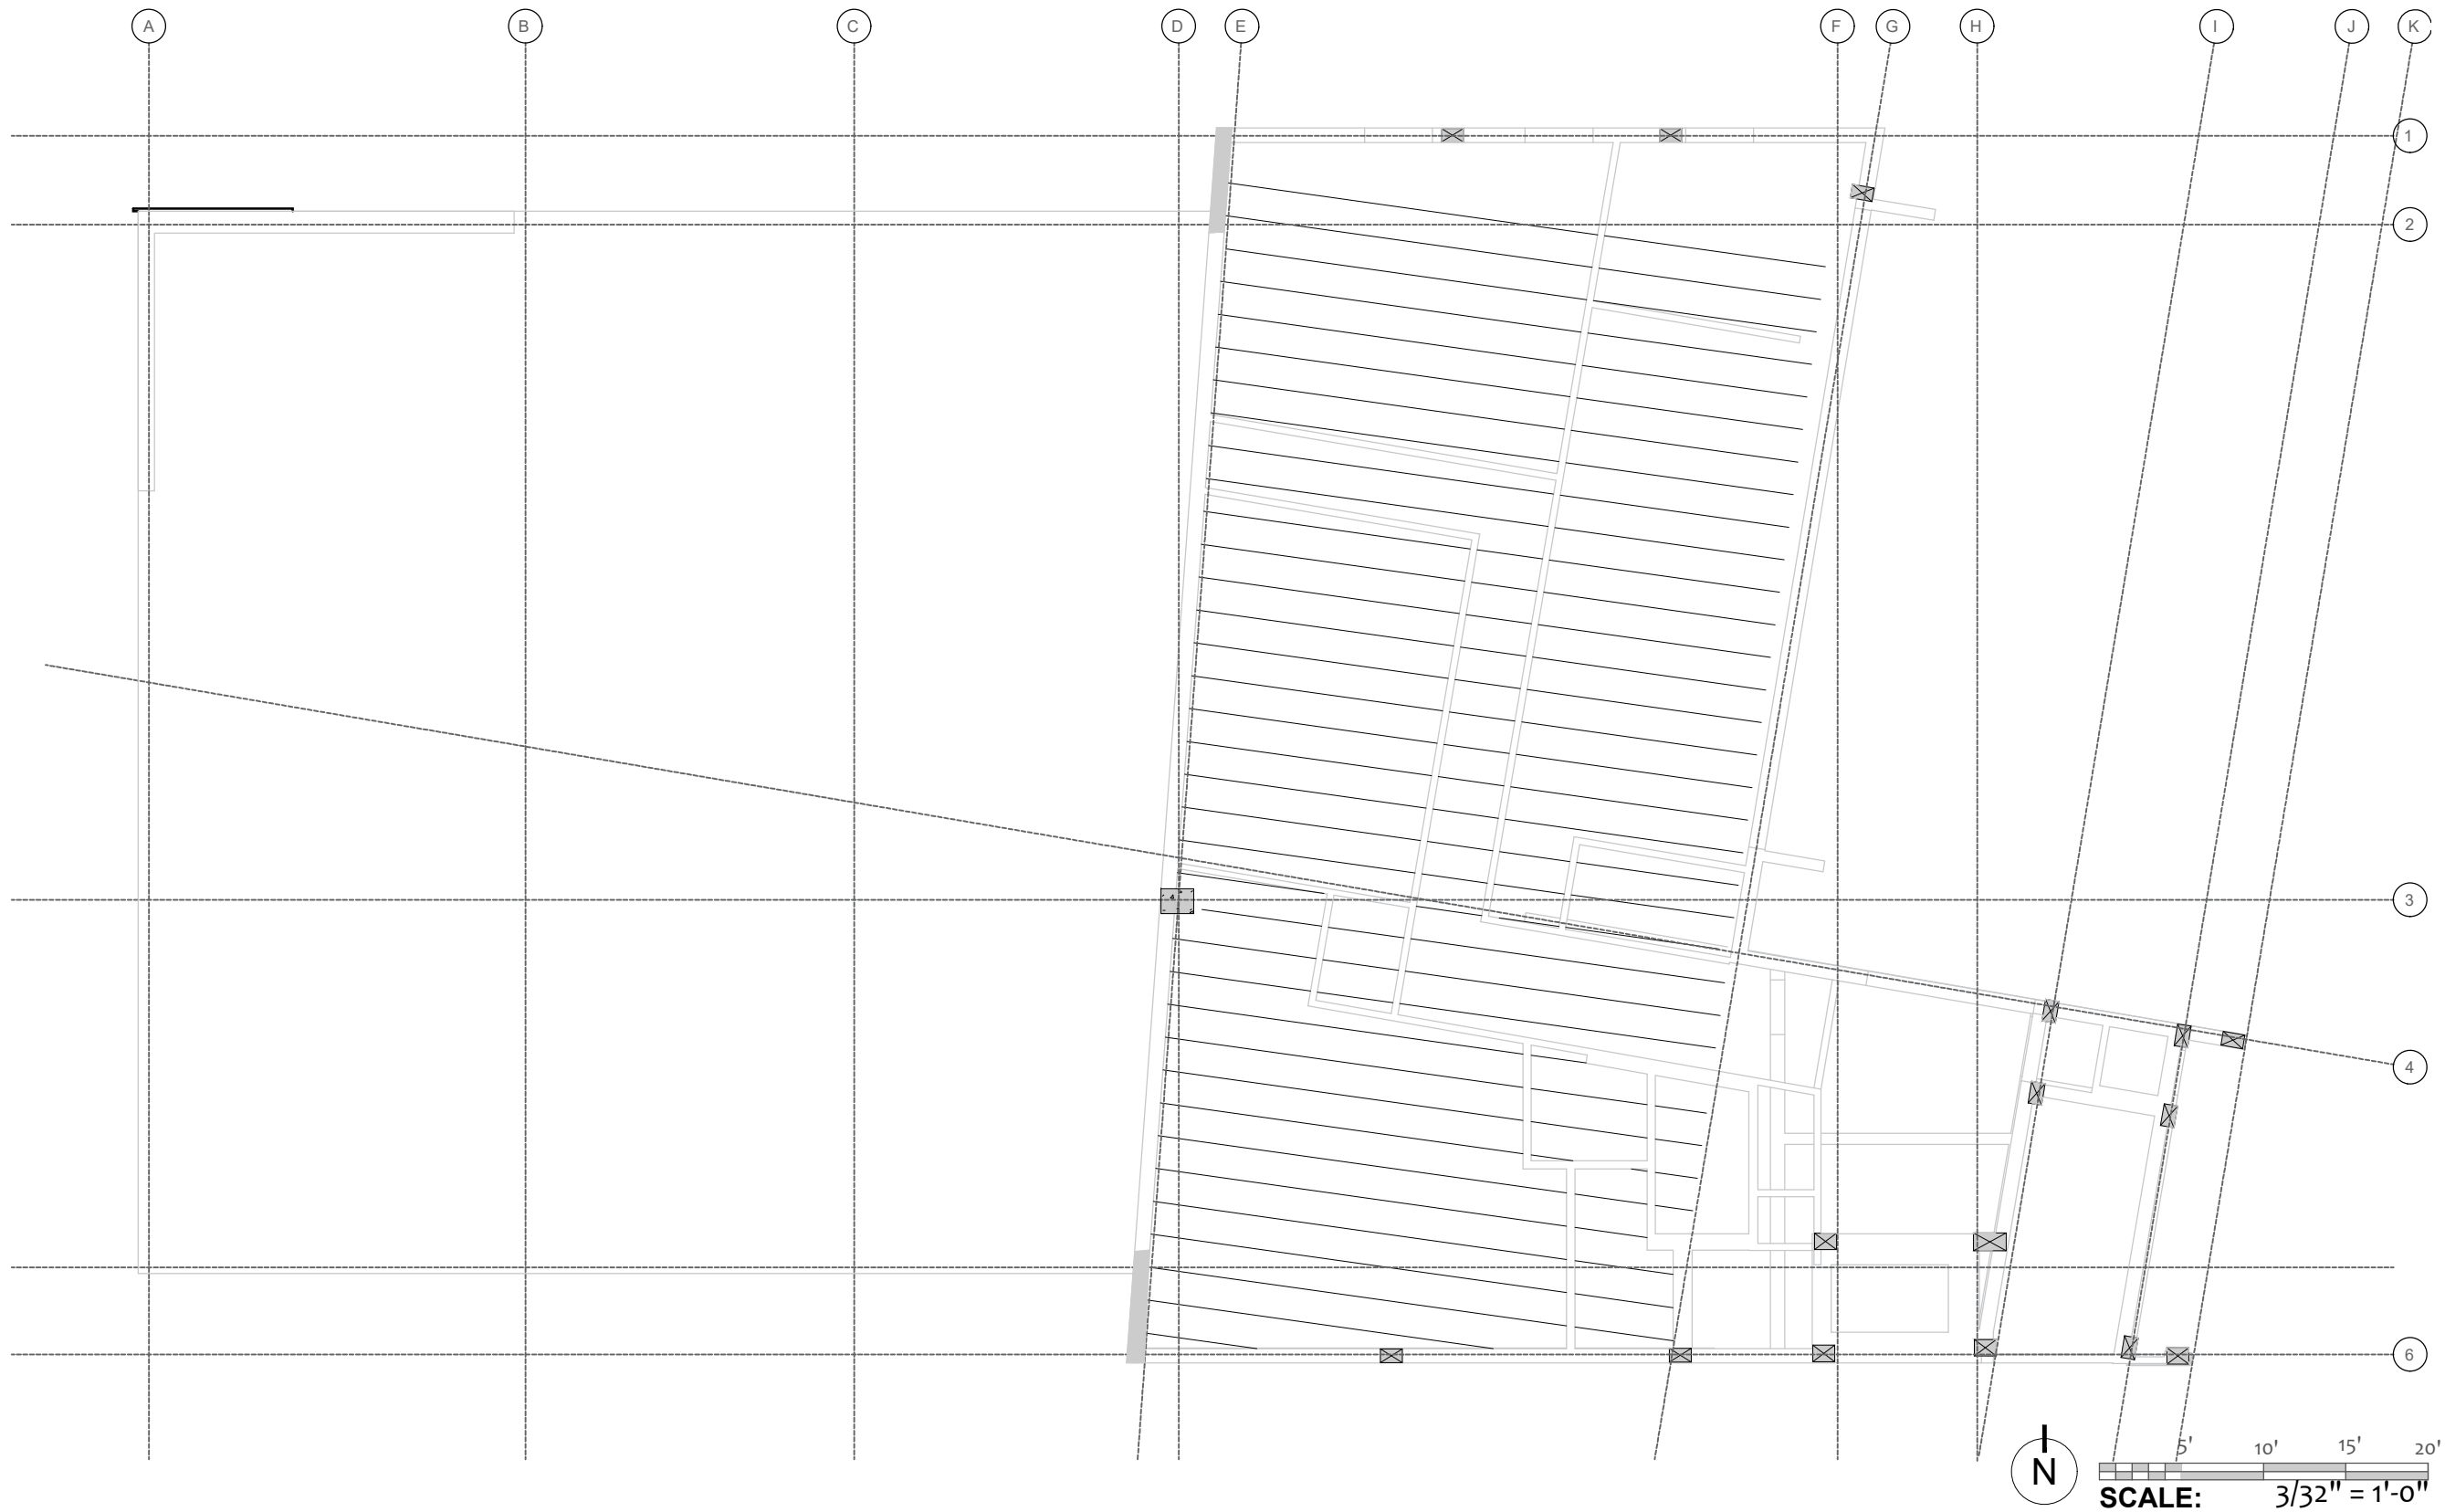

-  360 Vantage Point (Web Link)
-  Still Photo
-  Red Flag Notification


OWNER:

CLIENT:



Arktech Solutions LLC.
10804 Inside Loop
Orlando, FL 32825
tel: (407) 205-7787
www.ArktechSolution.com

FC NAME:		----
FCID:		N/A
FC ADDRESS:		----- ----- -----
FIELD SURVEYOR:		----
PROJECT DIRECTOR:		M.Vanegas
CHECKED BY:		----
DATE COMPLETED:		12-23-2019
PROJECT NUMBER:		----
SHEET:		A007.1
DRAWING NUMBER:	OF:	2741
DRAWING NAME: FRAMING PLAN 3rd FL		

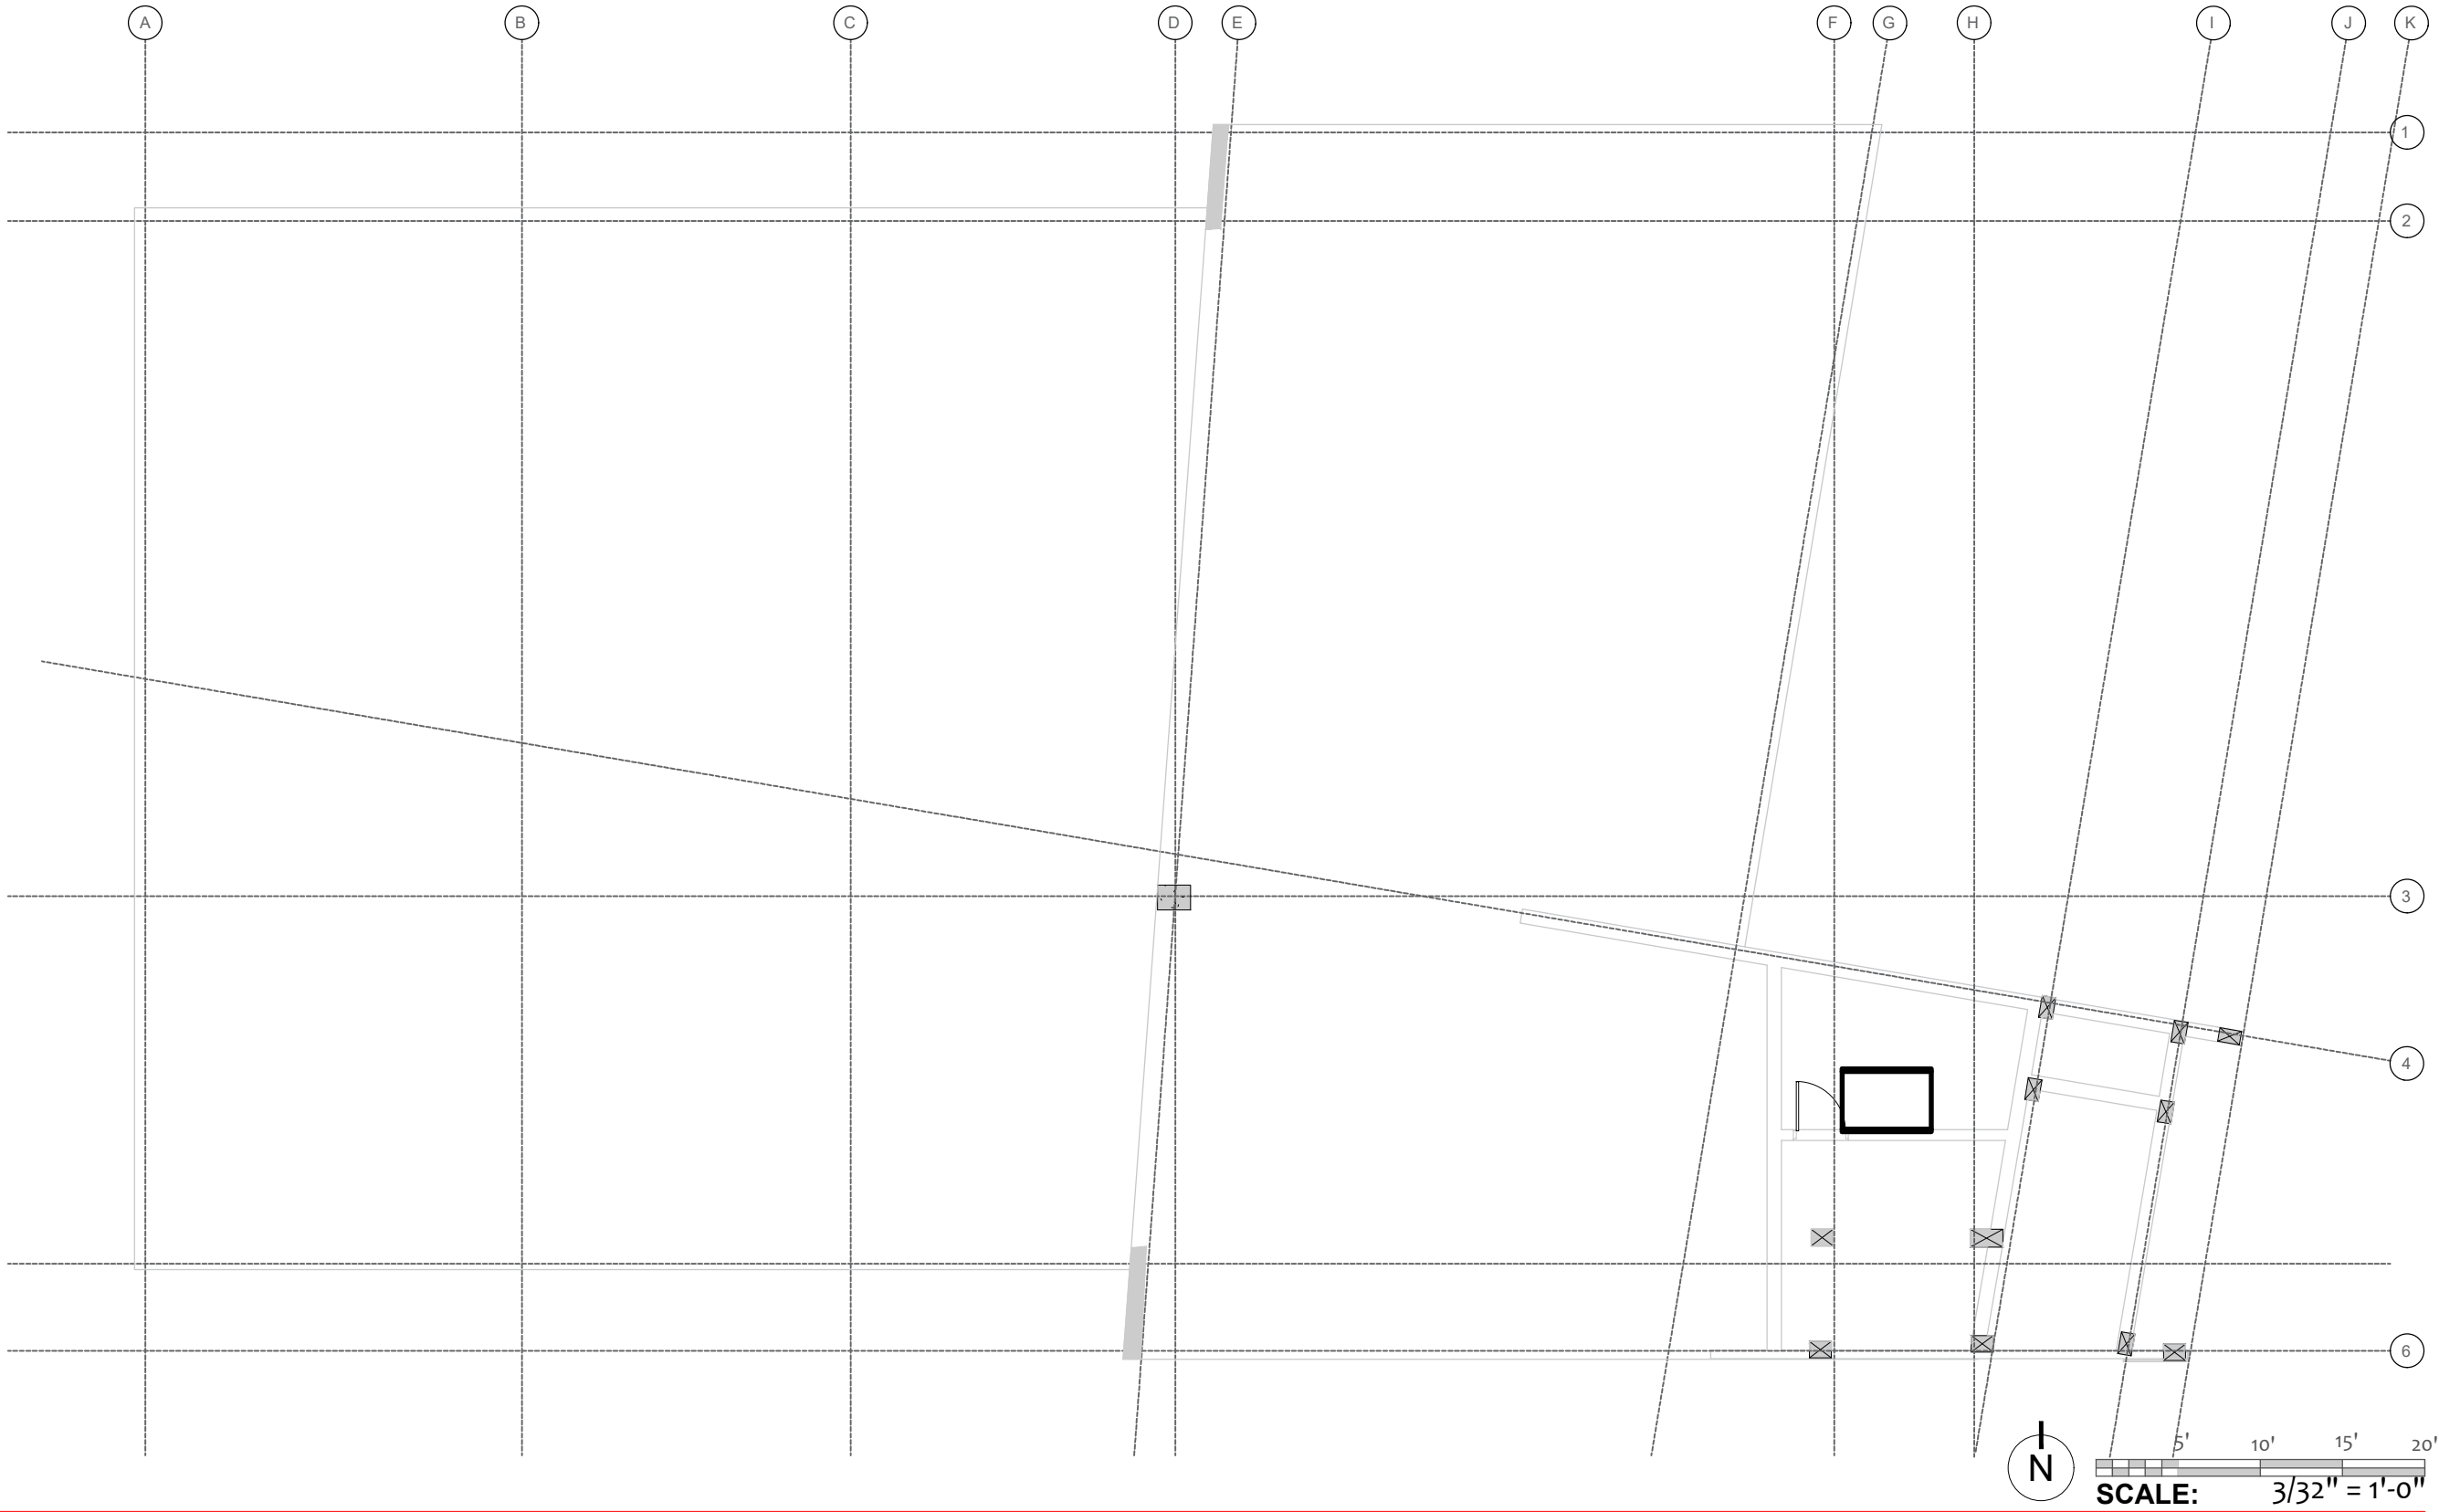

-  360 Vantage Point (Web Link)
-  Still Photo
-  Red Flag Notification


OWNER:

CLIENT:




Arktech Solutions LLC.
10804 Inside Loop
Orlando, FL 32825
tel: (407) 205-7787
www.ArktechSolution.com

FC NAME: ----	
FCID: N/A	
FC ADDRESS: ----- ----- -----	
FIELD SURVEYOR: ----	
PROJECT DIRECTOR: M.Vanegas	
CHECKED BY: ----	
DATE COMPLETED: 12-23-2019	
PROJECT NUMBER: ----	
SHEET: A007.4	
DRAWING NUMBER: 28	OF: 41
DRAWING NAME: FRAMING PLAN PENTHOUSE	

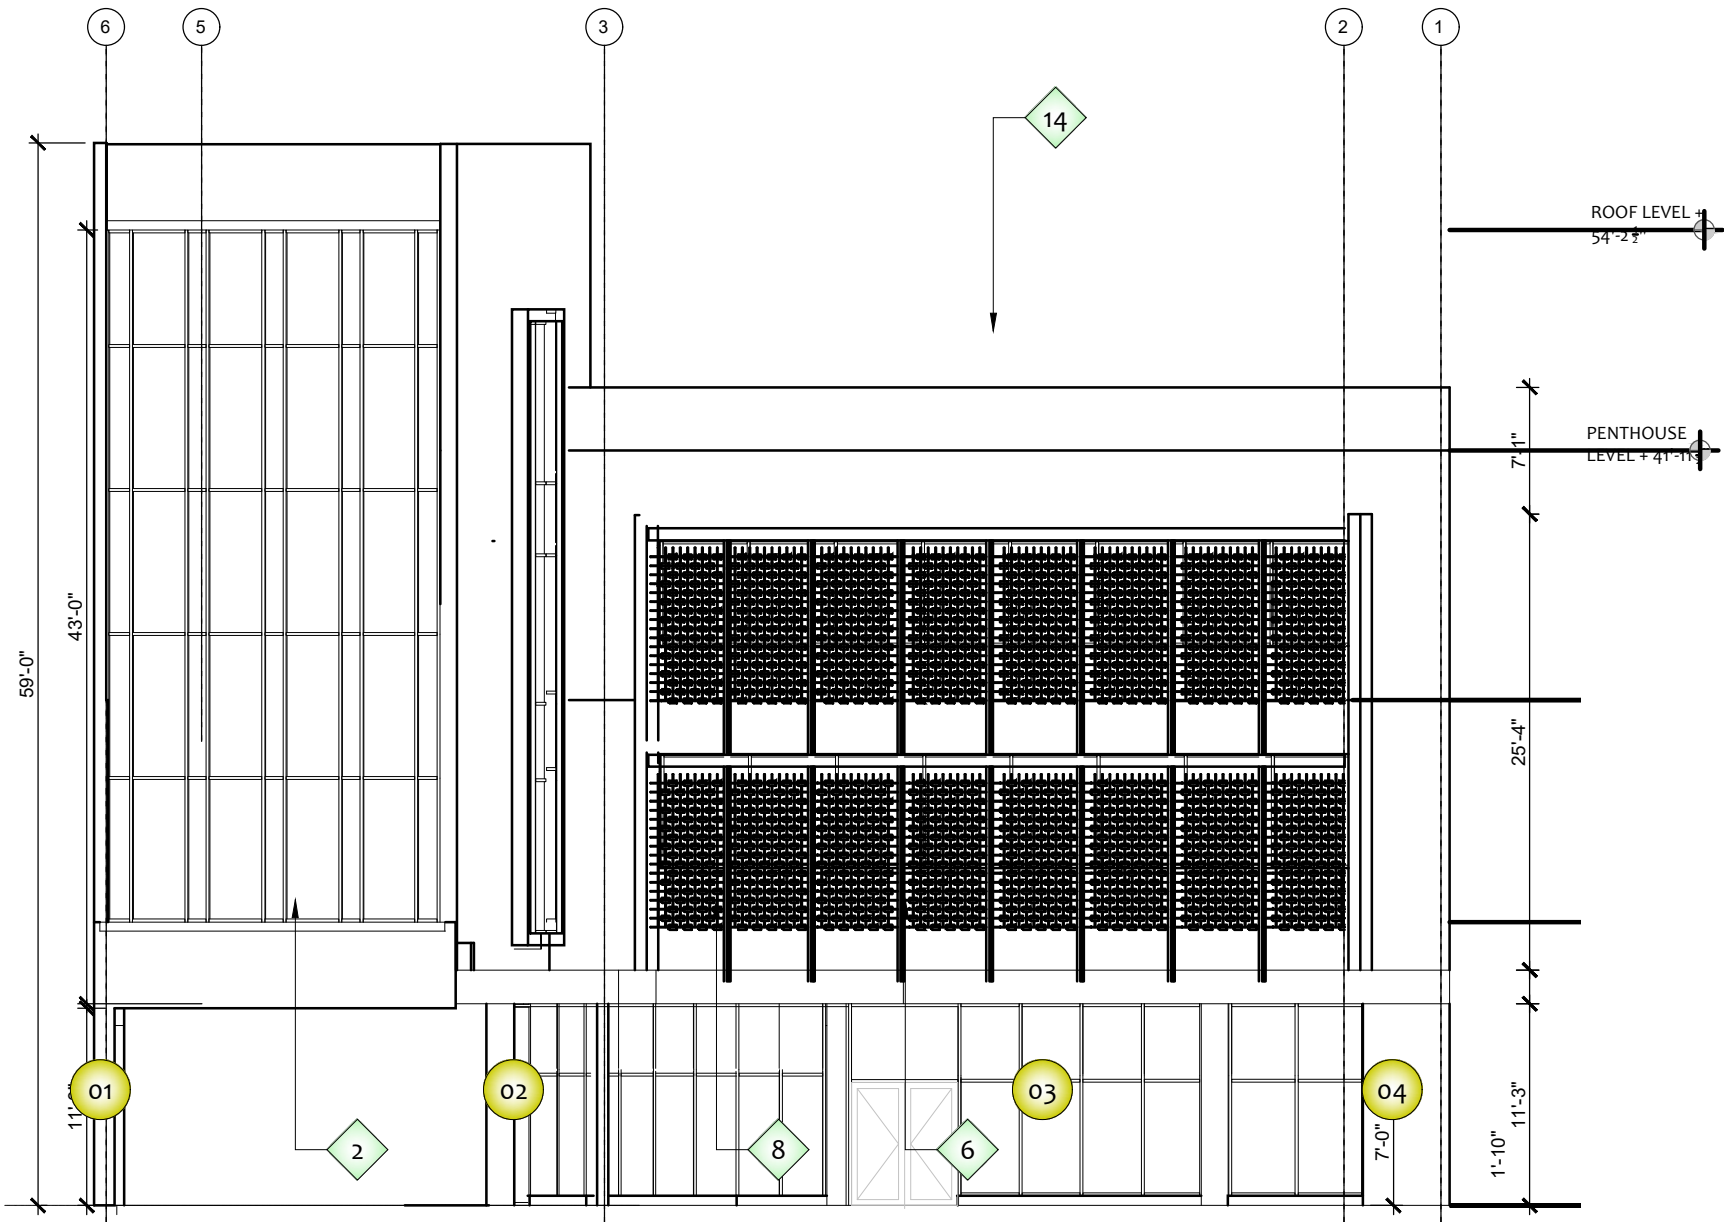


1 EAST EXTERIOR ELEVATION

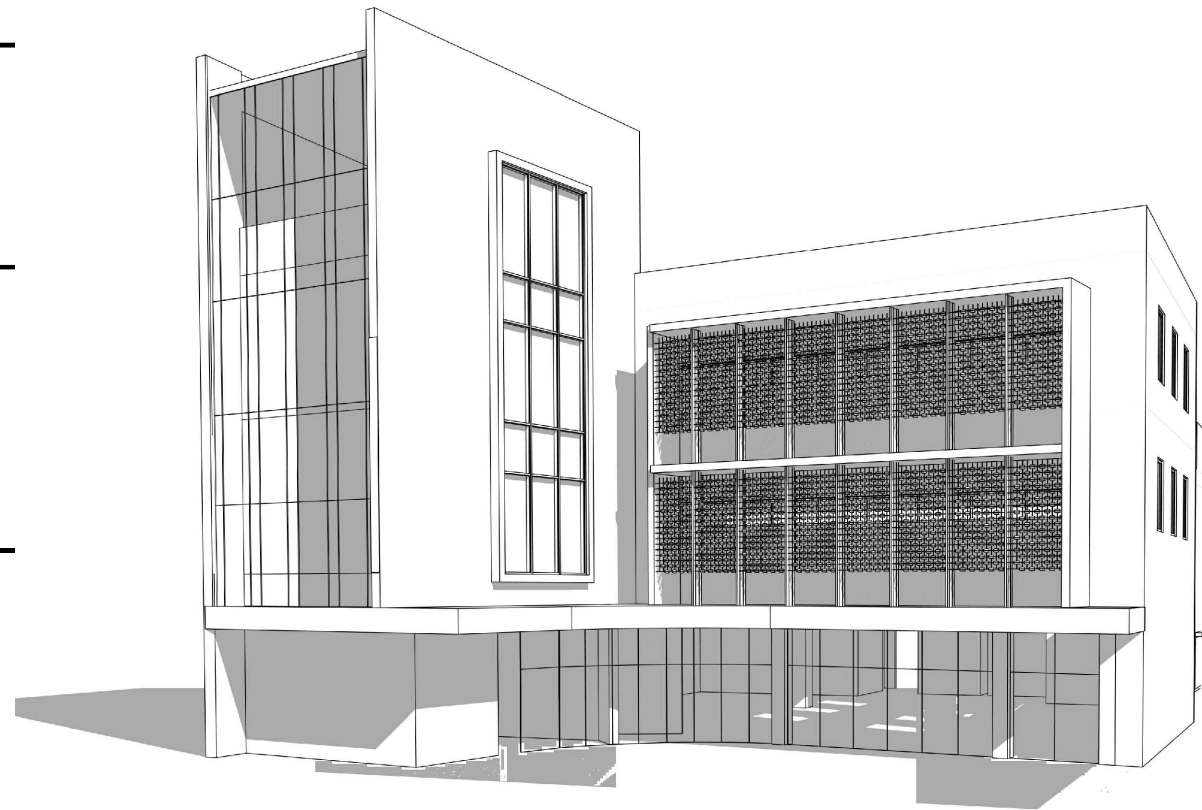

SCALE: 3/32" = 1'-0"

- | | | | | | |
|---|----------|----|------------------|----|--------------------|
| 1 | STUCCO | 6 | ENTRY DOOR | 11 | TILE |
| 2 | GRANITE | 7 | BUILDING SIGNAGE | 12 | METAL SIDING |
| 3 | BRICK | 8 | GLAZING | 13 | ROOFING - SHINGLES |
| 4 | CONCRETE | 9 | LIGHT FIXTURE | 14 | METAL CURTAIN |
| 5 | CMU | 10 | STONE | 15 | METAL GUARDRAIL |

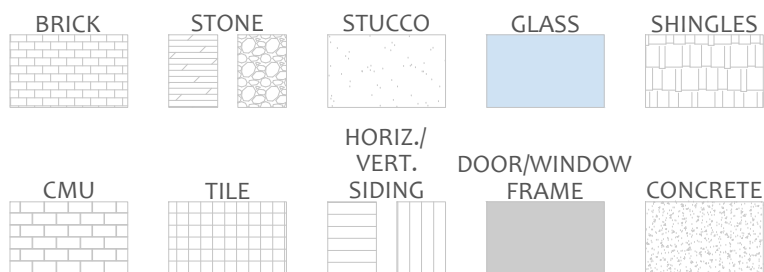

- 01 360 Vantage Point
- BUILDING SIGNAGE

OWNER:

CLIENT:



Arktech Solutions LLC.
10804 Inside Loop
Orlando, FL 32825
tel: (407) 205-7787
www.ArktechSolution.com

FC NAME:

FCID:

N/A

FC ADDRESS:

FIELD SURVEYOR:

PROJECT DIRECTOR:

M.Vanegas

CHECKED BY:

DATE COMPLETED:

12-23-2019

PROJECT NUMBER:

SHEET:

AX01

DRAWING NUMBER:

29

OF:

41



DRAWING NAME:

EXTERIOR ELEVATIONS

CLIENT:



FC NAME: ----	
FCID: N/A	
FC ADDRESS: ----- ----- -----	
FIELD SURVEYOR: -----	
PROJECT DIRECTOR: M.Vanegas	
CHECKED BY: -----	
DATE COMPLETED: 12-23-2019	
PROJECT NUMBER: -----	
SHEET: AX02	
DRAWING NUMBER: 30	OF: 41
DRAWING NAME: EXTERIOR ELEVATIONS	

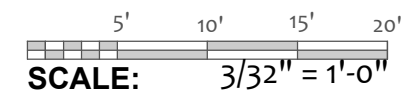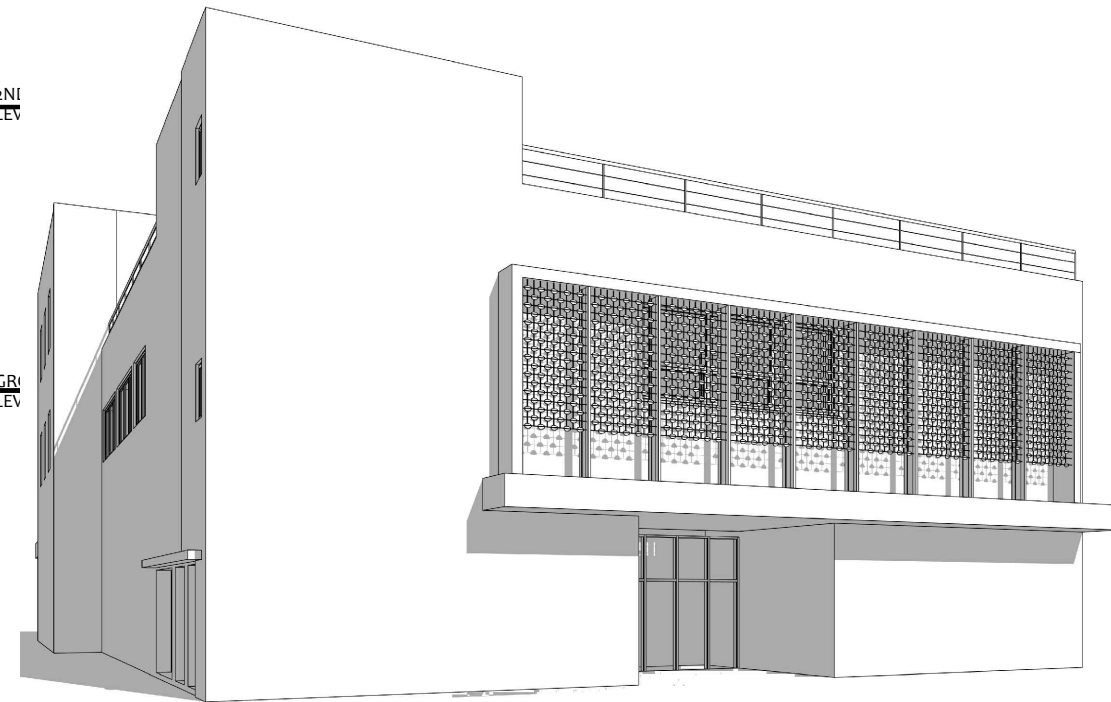

- | | | | | | |
|---|----------|----|--------------------|----|--------------------|
| 1 | STUCCO | 6 | ENTRY DOOR | 11 | TILE |
| 2 | WOOD | 7 | BUILDING SIGNAGE | 12 | METAL SIDING |
| 3 | BRICK | 8 | SIGNAGE ON GLAZING | 13 | ROOFING - SHINGLES |
| 4 | CONCRETE | 9 | LIGHT FIXTURE | 14 | METAL CURTAIN |
| 5 | CMU | 10 | STONE | 15 | METAL GUARDRAIL |

- BRICK

STONE

STUCCO

GLASS

SHINGLES

CMU


TILE

HORIZ./VERT. SIDING



DOOR/WINDOW FRAME

CONCRETE

- 01 360 Vantage Point
- BUILDING SIGNAGE

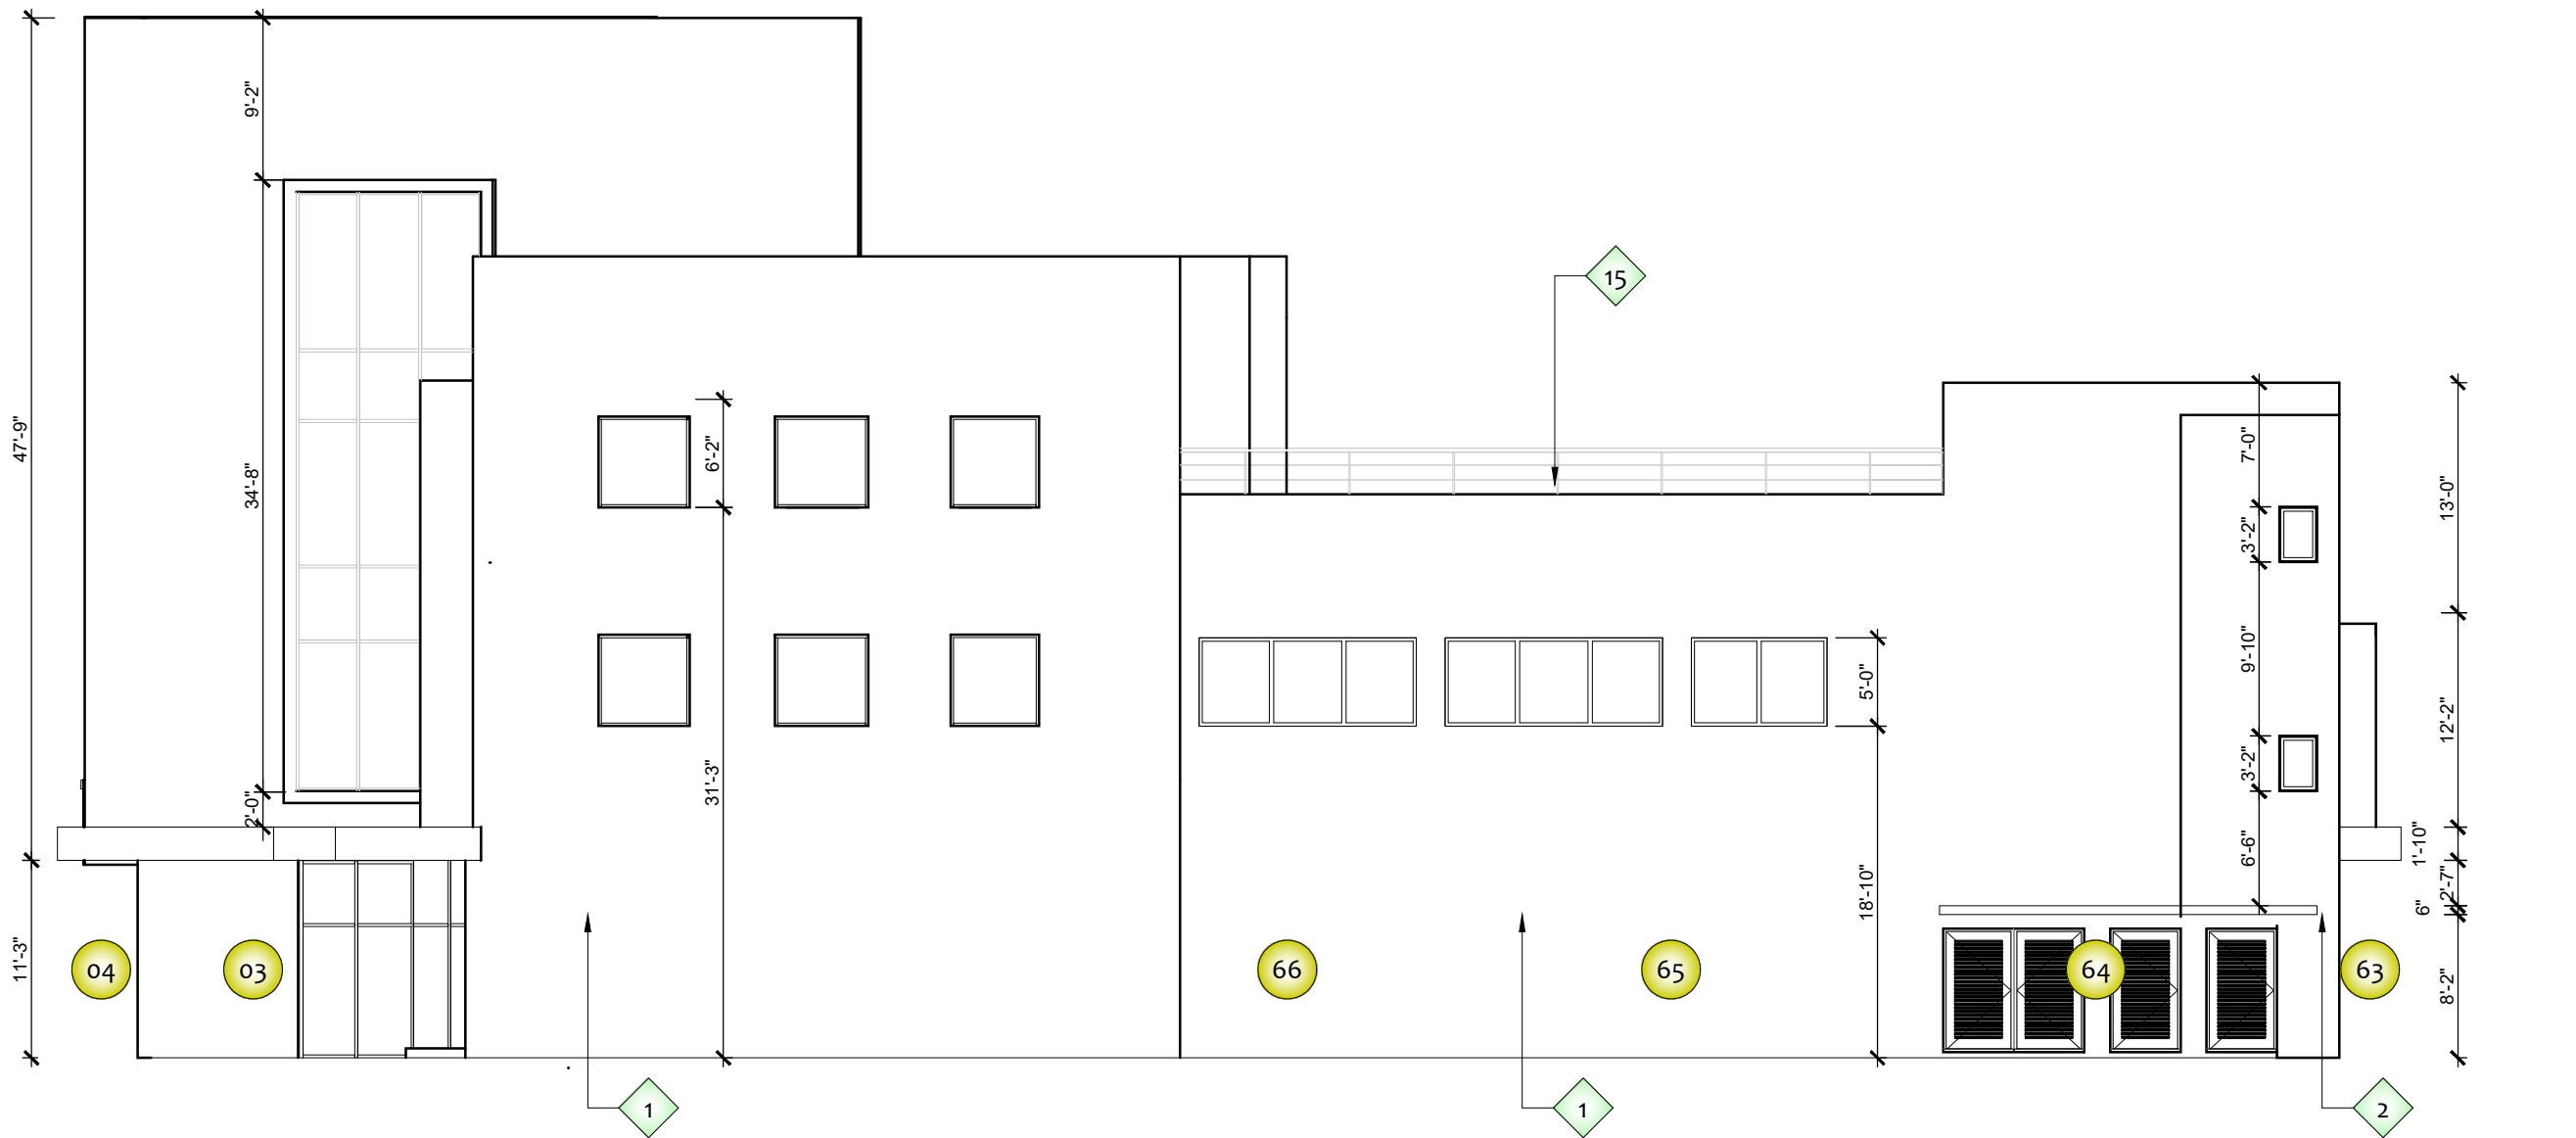

1 NORTH EXTERIOR ELEVATION

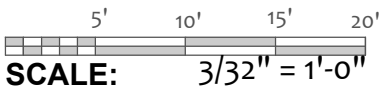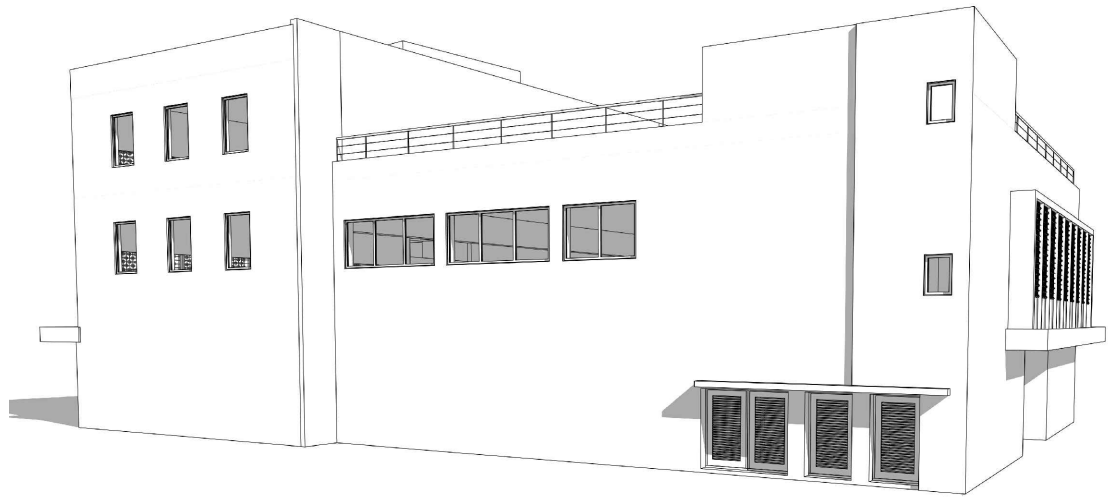

1

STUCCO

2

GRANITE

3

BRICK

4

CONCRETE

5

CMU

6

ENTRY DOOR

7

BUILDING SIGNAGE

8

SIGNAGE ON GLAZING

9

LIGHT FIXTURE

10

STONE

11

TILE

12

METAL SIDING

13

ROOFING - SHINGLES

14

METAL CURTAIN

15

METAL GUARDRAIL

BRICK

CMU

STONE

TILE

STUCCO

HORIZ./VERT. SIDING

GLASS

DOOR/WINDOW FRAME

SHINGLES

CONCRETE

01

360 Vantage Point

BUILDING SIGNAGE

BUILDING SIGNAGE


OWNER:

CLIENT:




Arktech Solutions LLC.
10804 Inside Loop
Orlando, FL 32825
tel: (407) 205-7787
www.ArktechSolution.com

FC NAME:		----
FCID:		N/A
FC ADDRESS:		----- ----- -----
FIELD SURVEYOR:		----
PROJECT DIRECTOR:		M.Vanegas
CHECKED BY:		----
DATE COMPLETED:		12-23-2019
PROJECT NUMBER:		----
SHEET:		AX03
DRAWING NUMBER:	OF:	3141
DRAWING NAME: EXTERIOR ELEVATIONS		

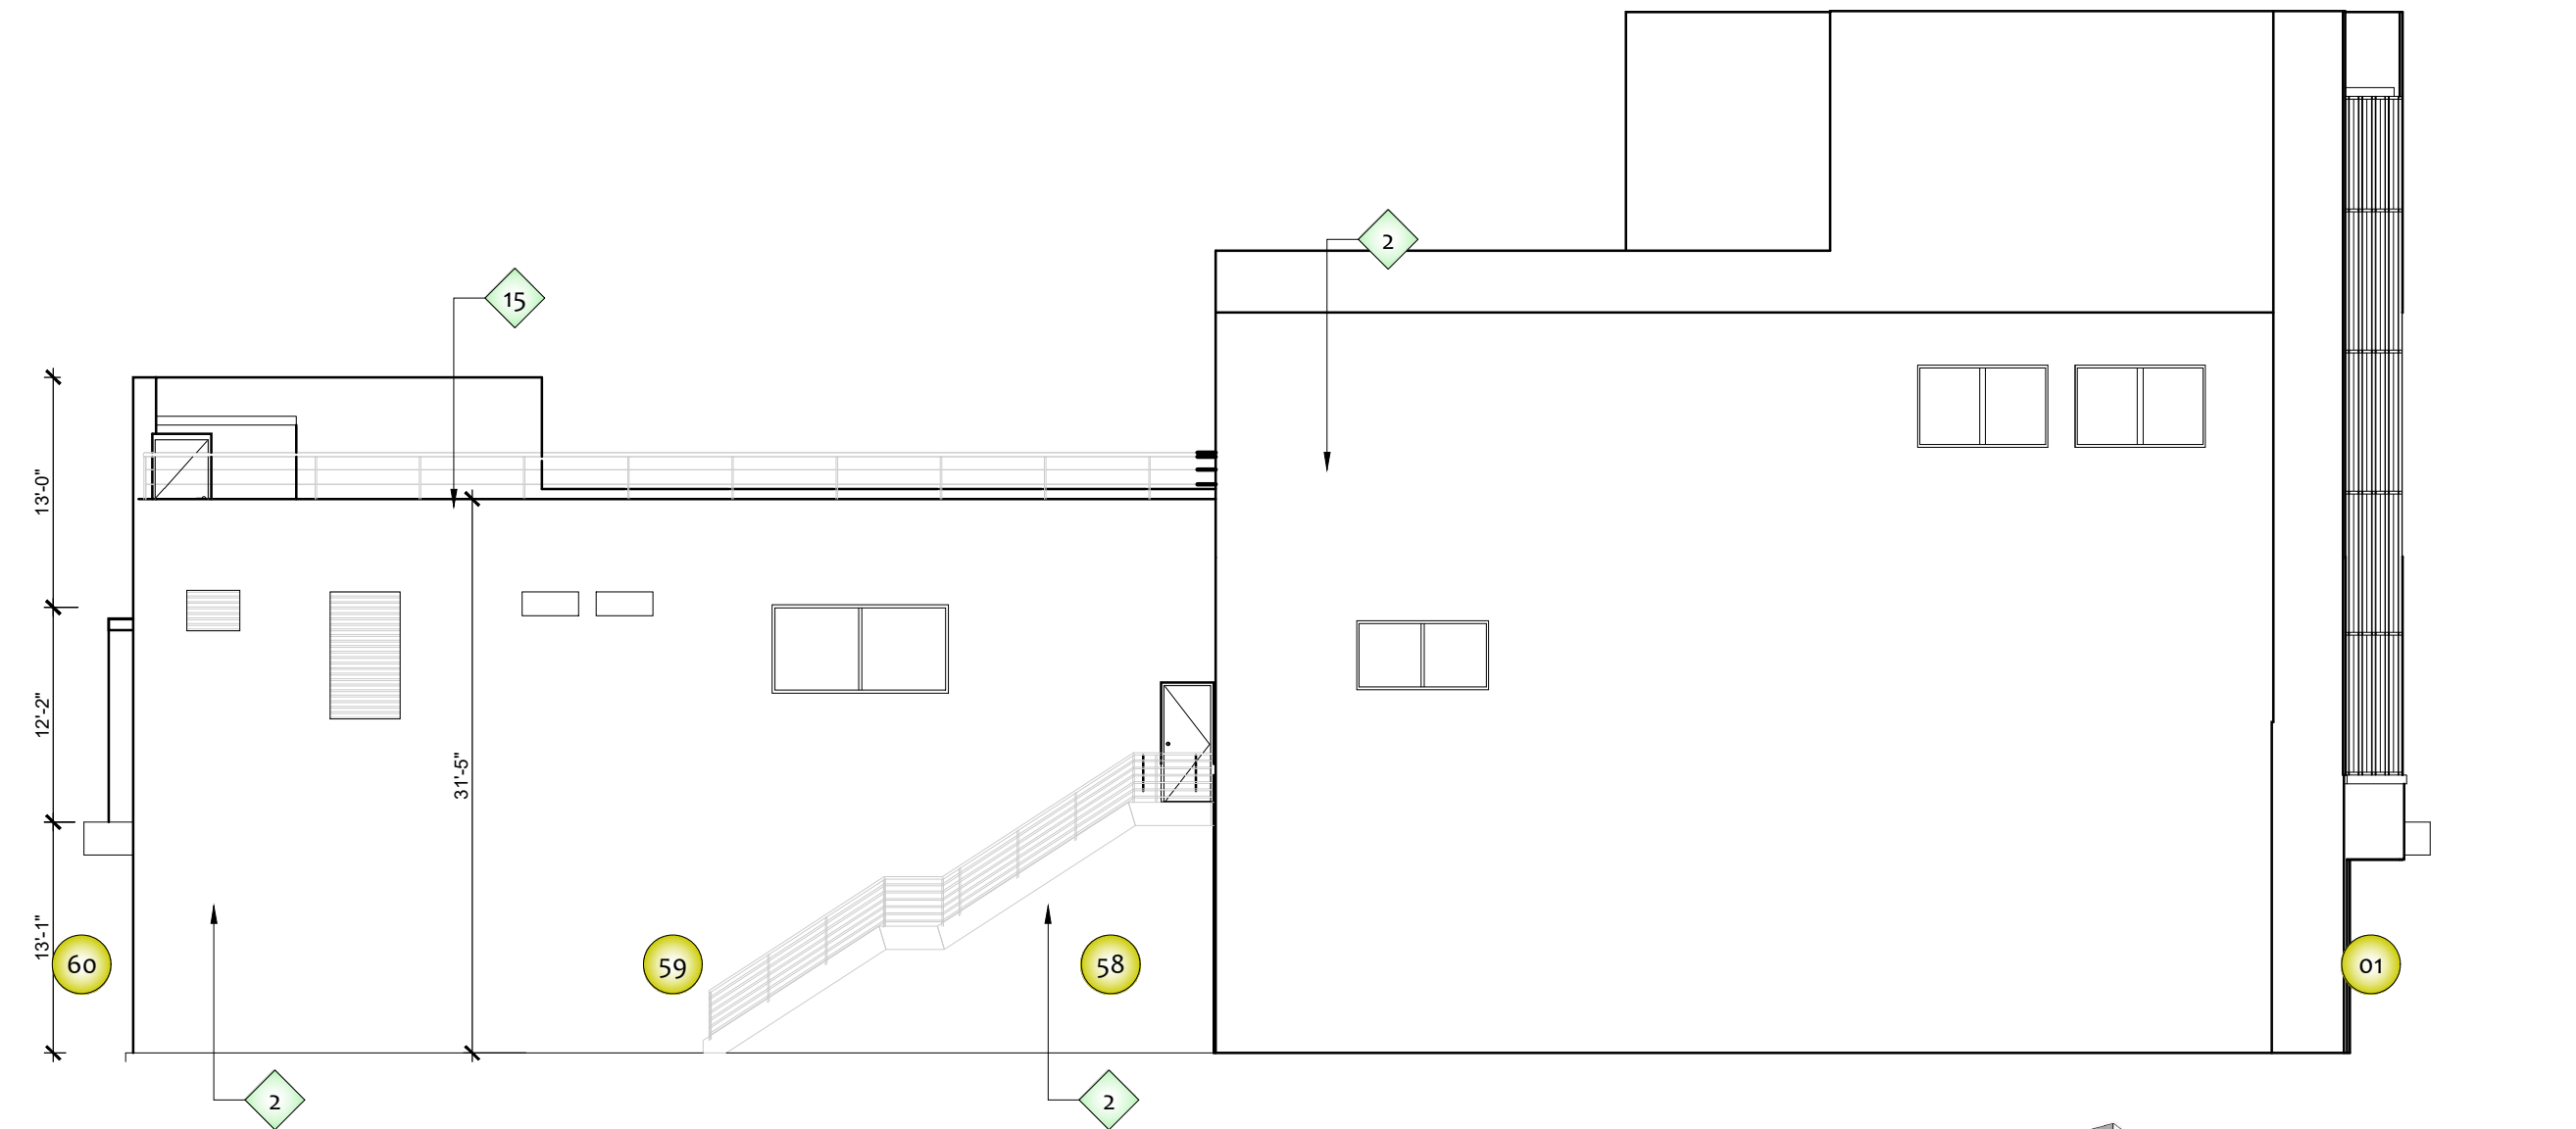


1 SOUTH EXTERIOR ELEVATION

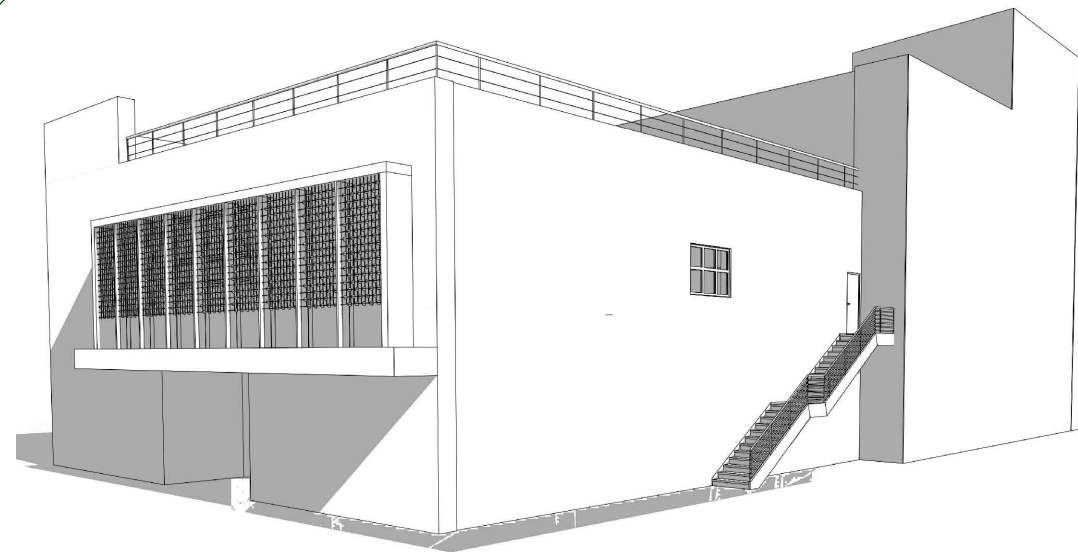

5' 10' 15' 20'
SCALE: 3/32" = 1'-0"

- | | | | | | |
|---|----------|----|--------------------|----|-------------------------------|
| 1 | STUCCO | 6 | ENTRY DOOR | 11 | TILE |
| 2 | GRANITE | 7 | BUILDING SIGNAGE | 12 | METAL SIDING |
| 3 | BRICK | 8 | SIGNAGE ON GLAZING | 13 | ROOFING - SHINGLES |
| 4 | CONCRETE | 9 | LIGHT FIXTURE | 14 | ROOFING - STANDING SEAM METAL |
| 5 | CMU | 10 | STONE | 15 | METAL GUARDRAIL |

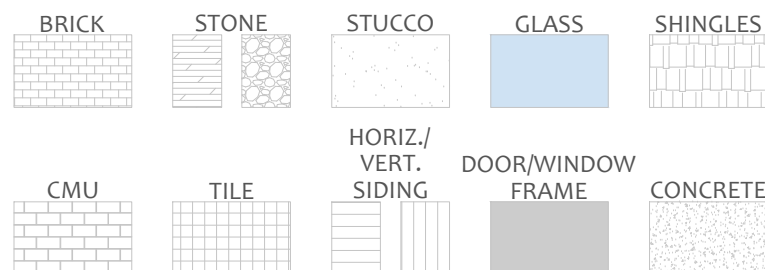

- 01 360 Vantage Point
- BUILDING SIGNAGE

OWNER:

CLIENT:




Arktech Solutions LLC.
10804 Inside Loop
Orlando, FL 32825
tel: (407) 205-7787
www.ArktechSolution.com

FC NAME:	----
FCID:	N/A
FC ADDRESS:	----- ----- -----


FIELD SURVEYOR:	----
PROJECT DIRECTOR:	M.Vanegas
CHECKED BY:	----
DATE COMPLETED:	12-23-2019

PROJECT NUMBER:	----
SHEET:	AX04
DRAWING NUMBER:	32
OF:	41

DRAWING NAME:	EXTERIOR ELEVATIONS
---------------	---------------------

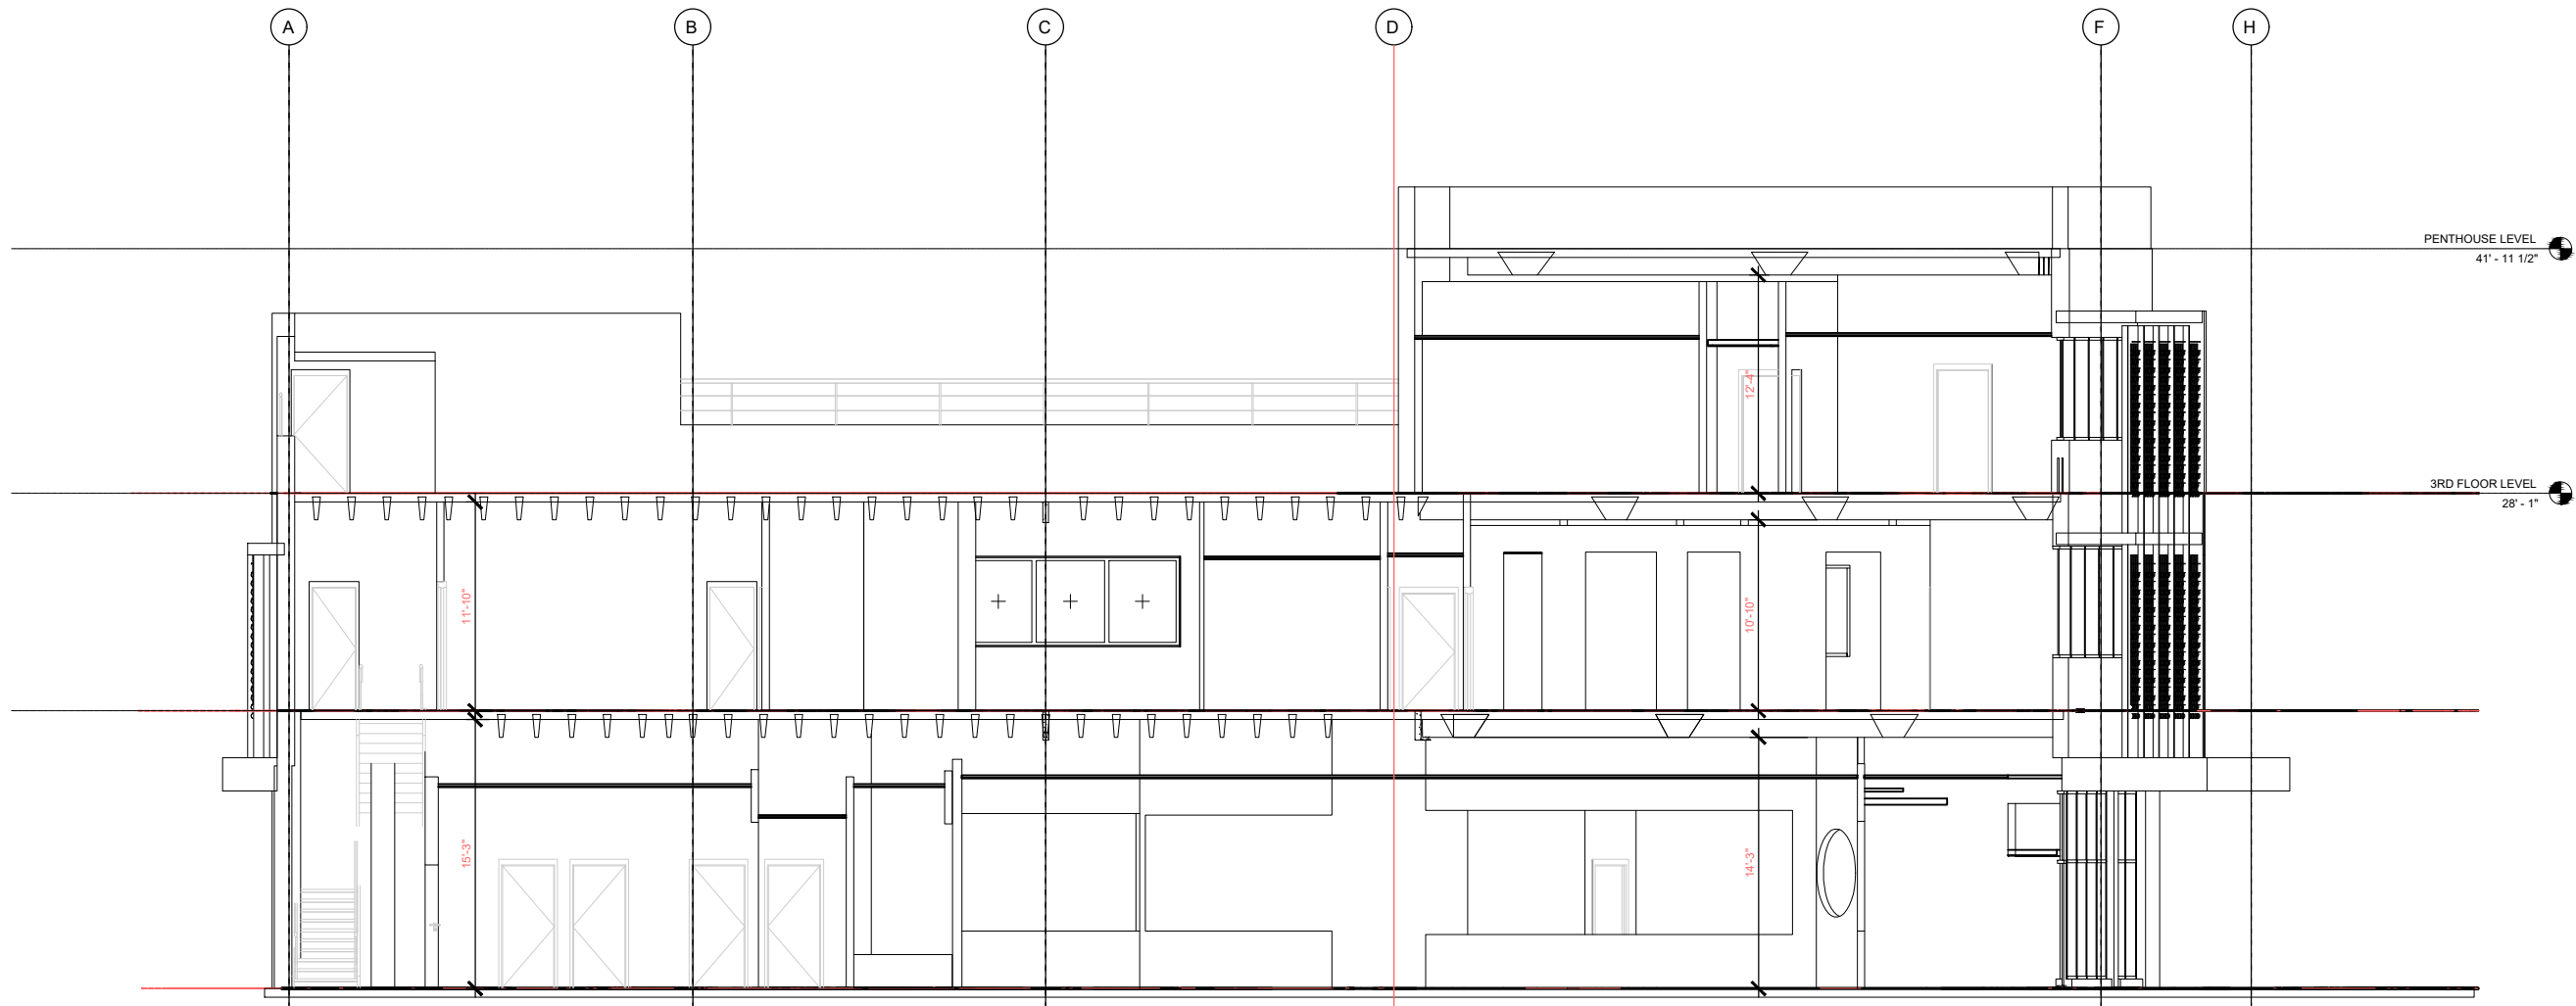

1 SECTION AX05

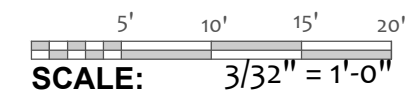

- 01 360 Vantage Point
- BUILDING SIGNAGE

OWNER:

CLIENT:




Arktech Solutions LLC.
10804 Inside Loop
Orlando, FL 32825
tel: (407) 205-7787
www.ArktechSolution.com

FC NAME:	----
FCID:	N/A
FC ADDRESS:	----- ----- -----


FIELD SURVEYOR:	----
PROJECT DIRECTOR:	M.Vanegas
CHECKED BY:	-----
DATE COMPLETED:	12-23-2019

PROJECT NUMBER:	----
SHEET:	AX05
DRAWING NUMBER:	33
OF:	41

DRAWING NAME:	SECTIONS
---------------	----------

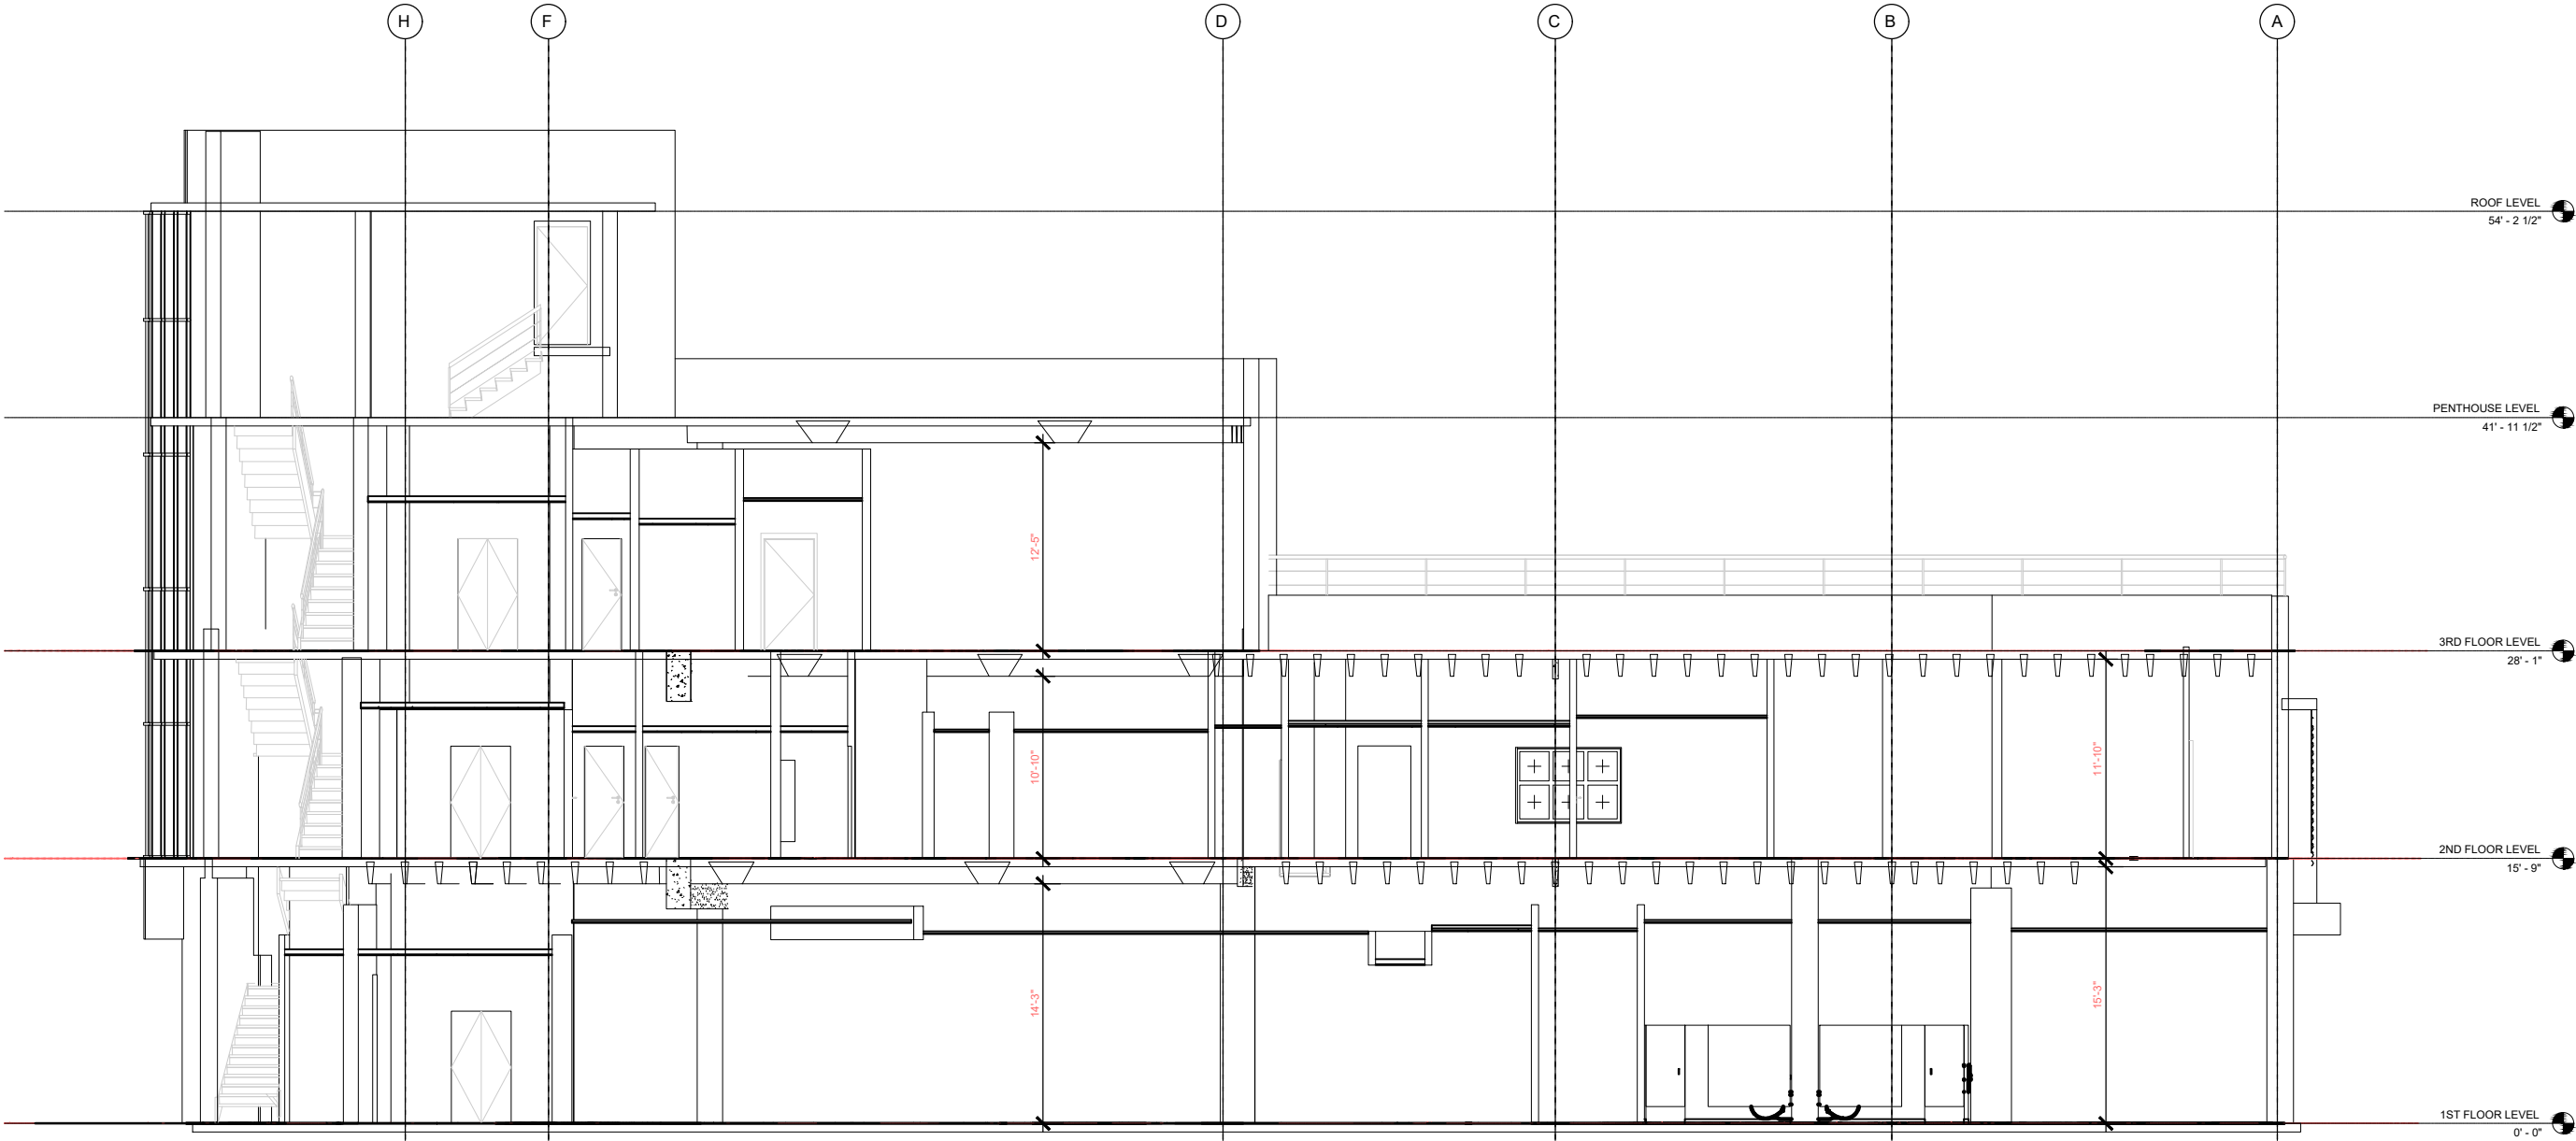

1 SECTION AX06

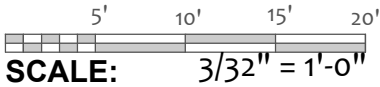

- 01 360 Vantage Point
- BUILDING SIGNAGE


OWNER:

CLIENT:




Arktech Solutions LLC.
10804 Inside Loop
Orlando, FL 32825
tel: (407) 205-7787
www.ArktechSolution.com

FC NAME: ----	
FCID: N/A	
FC ADDRESS: ----- ----- -----	
FIELD SURVEYOR: ----	
PROJECT DIRECTOR: M.Vanegas	
CHECKED BY: -----	
DATE COMPLETED: 12-23-2019	
PROJECT NUMBER: ----	
SHEET: 34	
DRAWING NUMBER: 26	OF: 41
DRAWING NAME: SECTIONS	

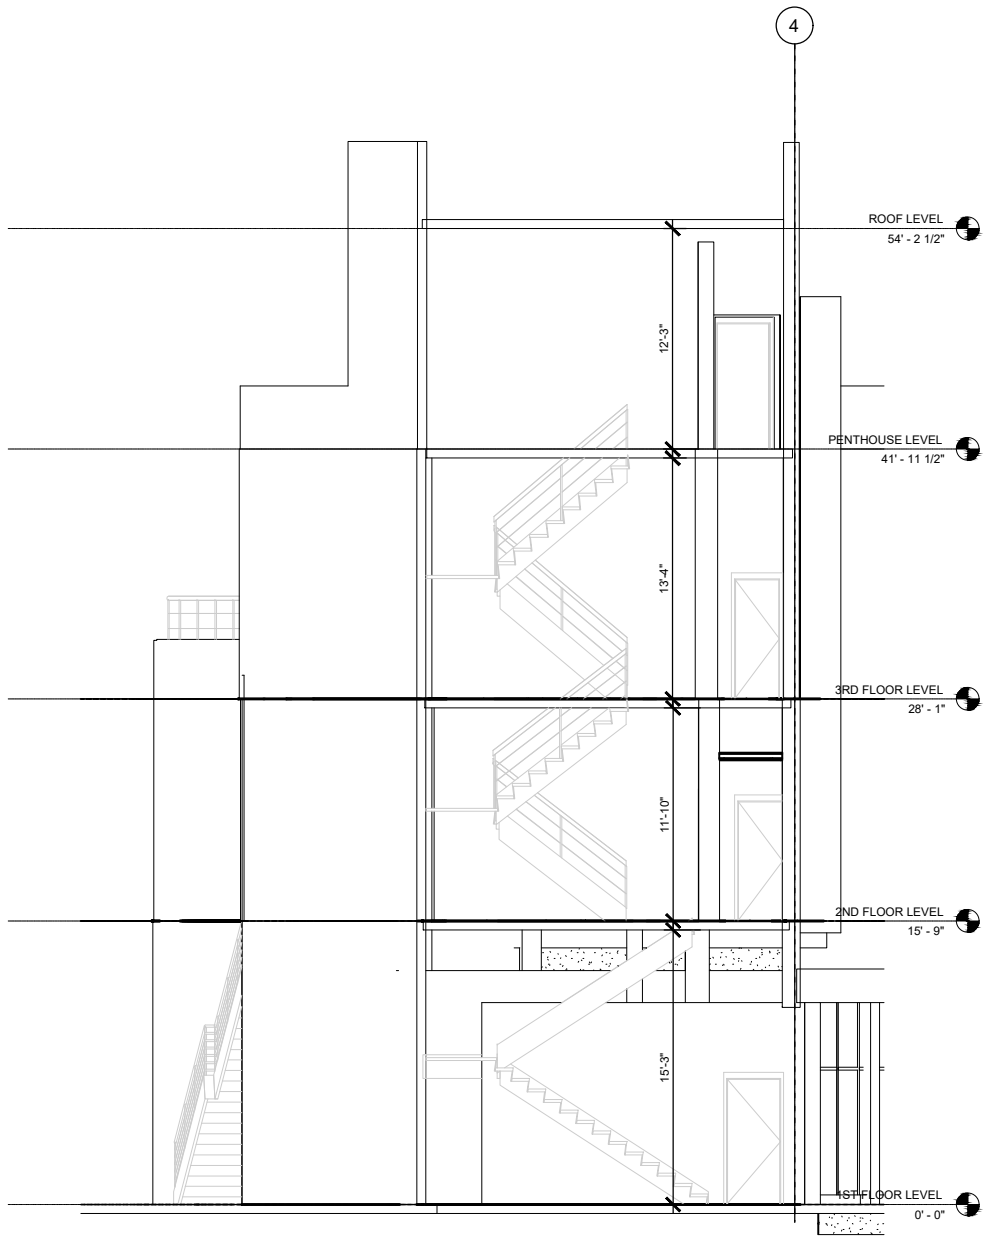

1 SECTION AX07/1

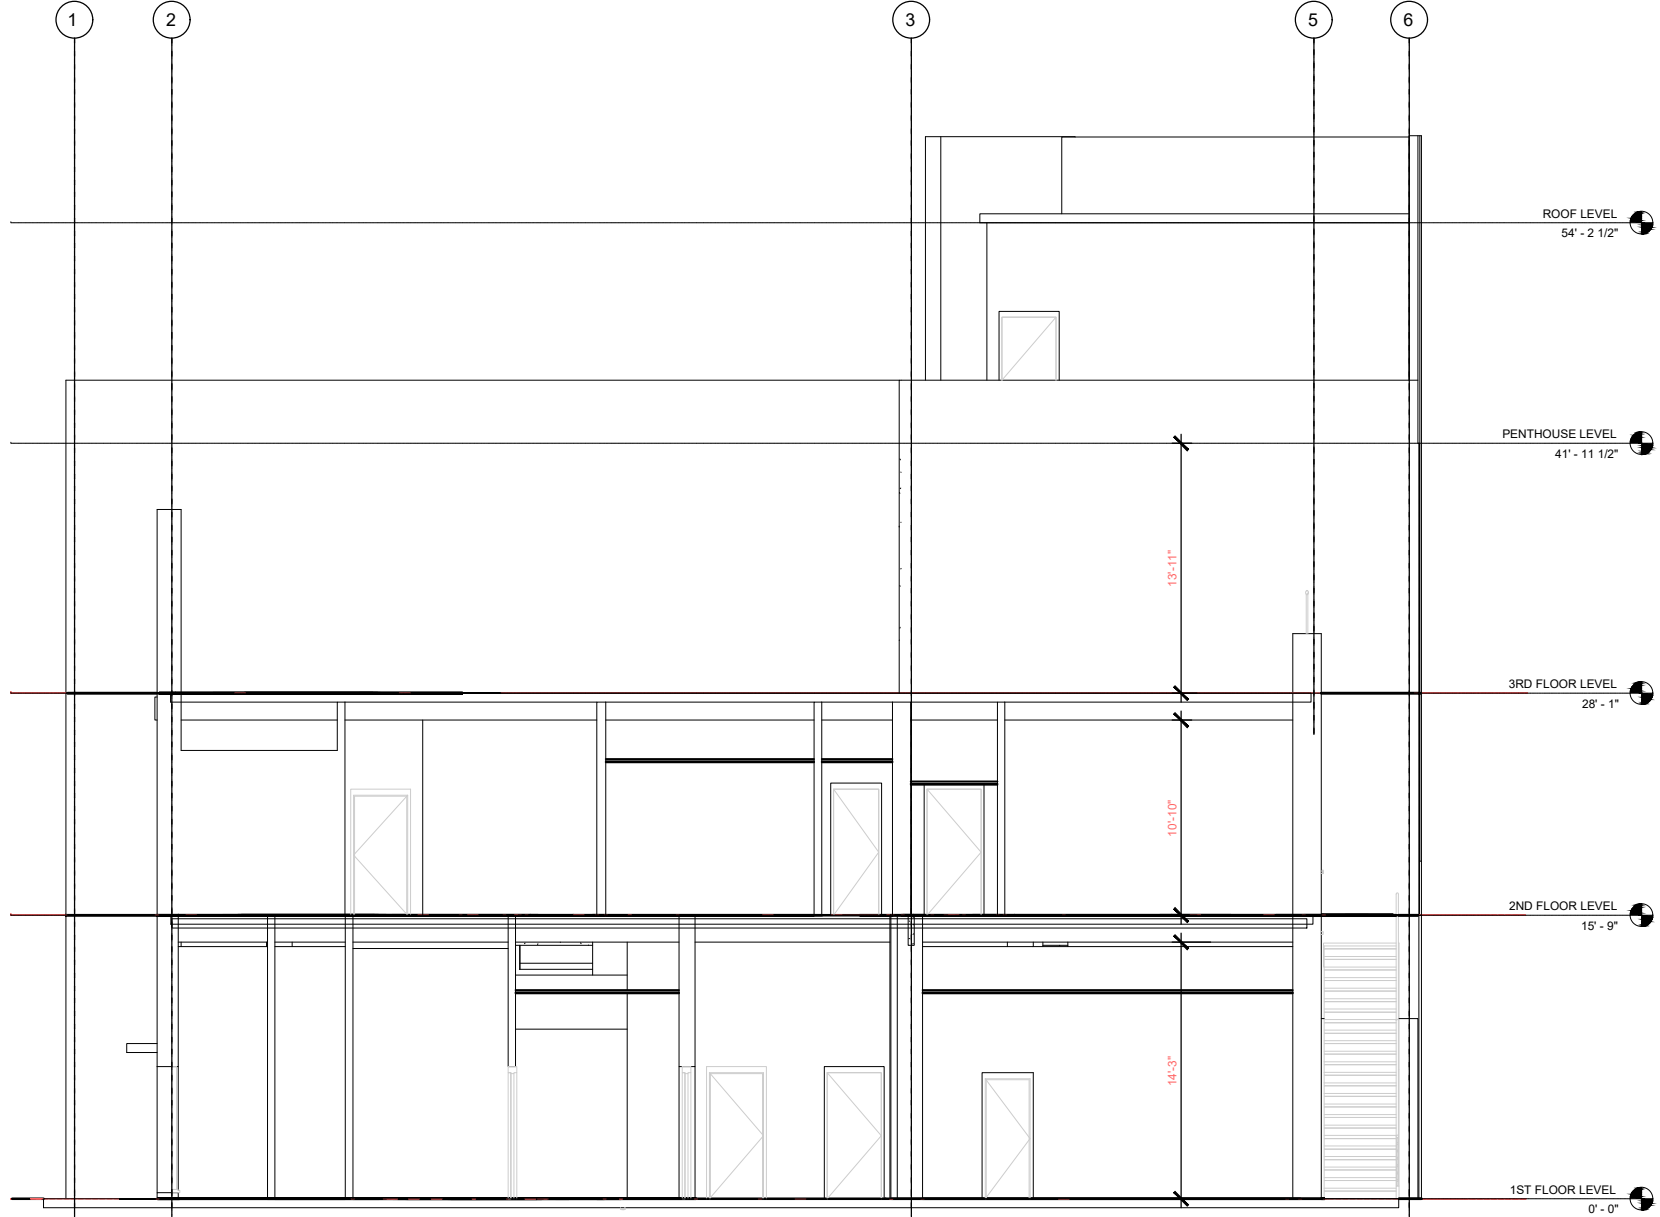

1 SECTION AX07/2

5' 10' 15' 20'
SCALE: 3/32" = 1'-0"

01 360 Vantage Point

BUILDING
SIGNAGE

OWNER:

CLIENT:



Arktech Solutions LLC.
10804 Inside Loop
Orlando, FL 32825
tel: (407) 205-7787
www.ArktechSolution.com

FC NAME:

FCID:

N/A

FC ADDRESS:

FIELD SURVEYOR:

PROJECT DIRECTOR:

M.Vanegas

CHECKED BY:

DATE COMPLETED:

12-23-2019

PROJECT NUMBER:

SHEET:

AX07

DRAWING NUMBER:


35

OF:


41

DRAWING NAME:

SECTIONS

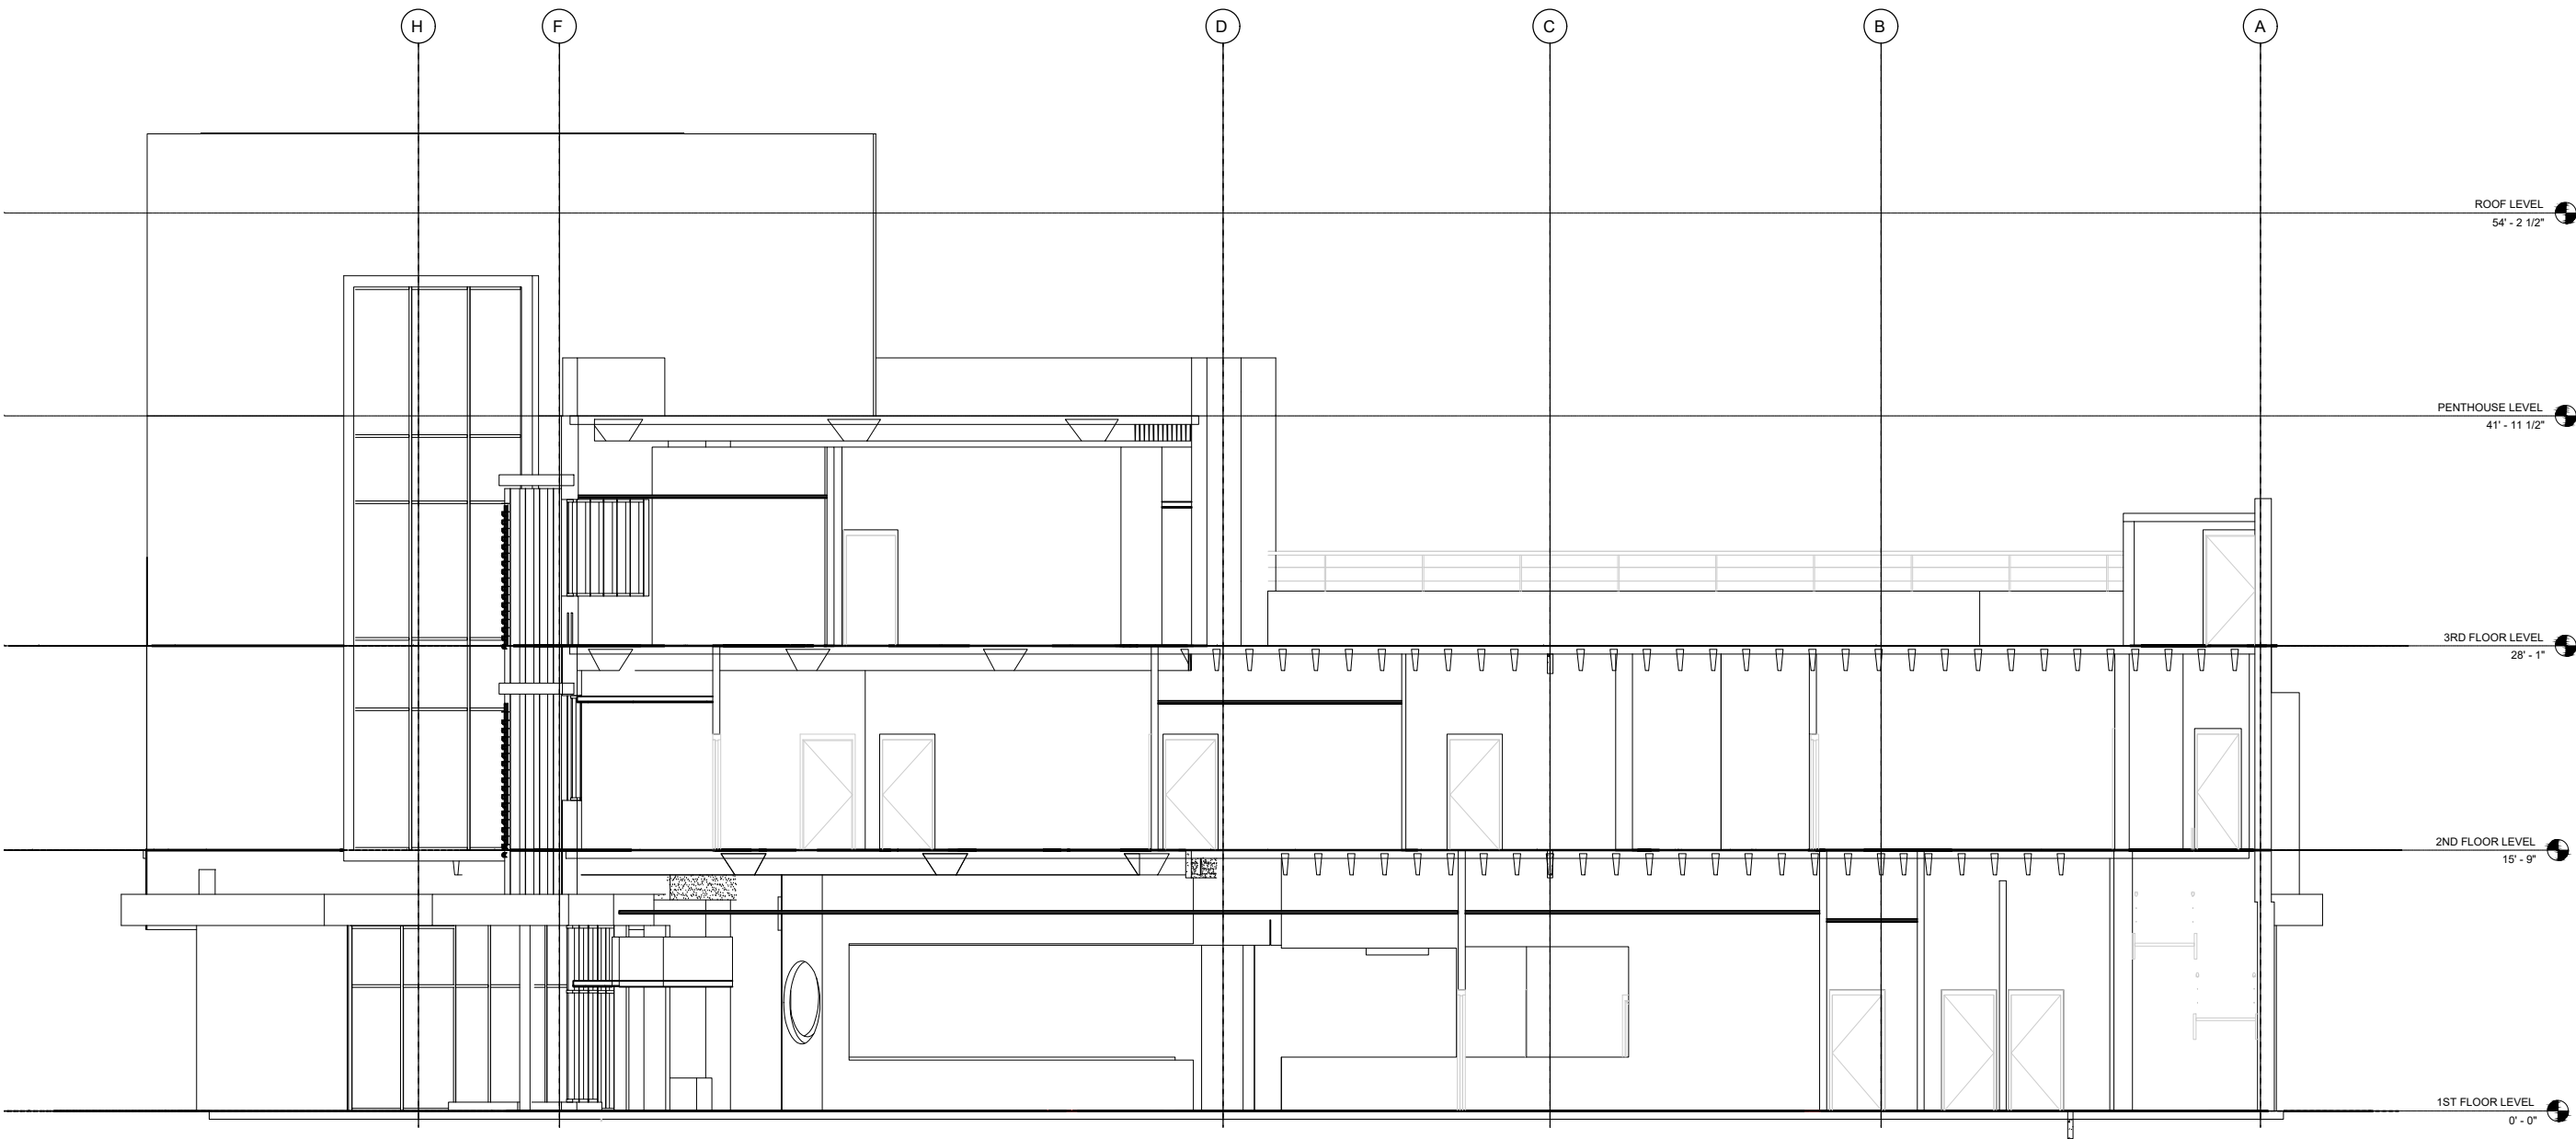

1 SECTION AX08

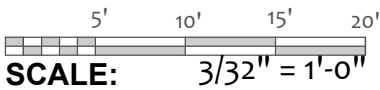

- 01 360 Vantage Point
- BUILDING SIGNAGE

OWNER:

CLIENT:



Arktech Solutions LLC.
10804 Inside Loop
Orlando, FL 32825
tel: (407) 205-7787
www.ArktechSolution.com

FC NAME:	

FCID:	
N/A	
FC ADDRESS:	

FIELD SURVEYOR:	

PROJECT DIRECTOR:	
M.Vanegas	
CHECKED BY:	

DATE COMPLETED:	
12-23-2019	
PROJECT NUMBER:	

SHEET:	
AX08	
DRAWING NUMBER:	OF:
36	41
DRAWING NAME:	
SECTIONS	

DOOR SCHEDULE															
DOOR NO.	TYPE	CLEAR OPNG WIDTH	FINISH	SIZE (WIDTH X HEIGHT)	DOOR			FRAME		HARDWARE DETAILS				THK.	REMARKS
					TYPE	MAT'L	COND.	TYPE	MAT'L	HEAD	JAMB	SILL	TYPE		
101.1	1	6'-0"	STAINED	6'-0" X 7'-0"	EXTERIOR	GLASS	BAD	H.M. WELDED	MTL						MAIN ENTRY DOOR
101.2	2	3'-0"	STAINED	3'-0" X 7'-0"	EXTERIOR	GLASS	GOOD	H.M. WELDED	MTL						
101.3	3	2'-9"	PAINT	2'-9" X 6'-8"	INTERIOR	WOOD	GOOD	WOOD	WOOD						FIRE RATED WITH PANIC HARDWARE AND CLOSER
101.4	4	3'-0"	PAINT	3'-0" X 7'-0"	INTERIOR	WOOD	GOOD	WOOD	WOOD						
101.5	5	3'-0"	PAINT	3'-0" X 6'-3"	INTERIOR	WOOD	GOOD	-	-						RESTROOM DOOR
101.6	6	2'-0"	PAINT	2'-0" X 6'-3"	INTERIOR	WOOD	GOOD	-	-						RESTROOM DOOR
101.7	7	3'-0"	STAINED	3'-0" X 7'-0"	INTERIOR	GLASS	GOOD	H.M. WELDED	MTL						
101.8	8	2'-10"	STAINED	2'-10" X 6'-7"	INTERIOR	MTL	GOOD	MTL	MTL						
101.9	9	3'-0"	PAINT	3'-0" X 7'-0"	INTERIOR	WOOD	GOOD	WOOD	WOOD						
101.10	10	3'-4"	PAINT	3'-0" X 7'-0"	INTERIOR	WOOD	GOOD	WOOD	WOOD						
101.11	11	3'-4"	STAINED	3'-4" X 6'-8"	EXTERIOR	MTL	GOOD	MTL	MTL						
101.12	12	4'-4"	STAINED	4'-4" X 6'-8"	EXTERIOR	MTL	GOOD	MTL	MTL						
101.13	13	8'-4"	STAINED	8'-4" X 6'-8"	EXTERIOR	MTL	GOOD	MTL	MTL						
101.14	14	2'-4"	PAINT	2'-6" X 7'-0"	INTERIOR	WOOD	GOOD	WOOD	WOOD						
DOOR & WINDOW SCHEDULES														SCALE: NTS	1

WINDOW SCHEDULE									
WINDOW NO.	HARD-WARE	TYPE	WINDOW SIZE	SILL HEIGHT (A.F.F.)		FRAME		GLAZING	REMARKS
					FINISH	MAT'L	SIZE		
101.A	-	A	3'-9" X 7'-6"	4"	H.M. WELDED	MTL	2"X6" TYP.	INSULATED	
101.B	-	B	7'-0" X 7'-7"	7"	H.M. WELDED	MTL	2"X4.5" TYP.	INSULATED	
101.C	-	C	7'-7" X 9'-5"	7"	H.M. WELDED	MTL	2"X4.5" TYP.	INSULATED	
101.D	-	D	9'-5" X 6'-8"	3'-3"	PAINT	WOOD	2"X4.5" TYP.	INSULATED	
101.E	-	E	9'-7" X 6'-8"	3'-3"	H.M. WELDED	MTL	2"X4.5" TYP.	INSULATED	
101.F	-	F	7'-8" X 7'-0"	0"	H.M. WELDED	MTL	2"X4.5" TYP.	INSULATED	
DOOR & WINDOW SCHEDULES									
									SCALE: NTS
2									

OWNER:

CLIENT:



Arktech Solutions LLC.
10804 Inside Loop
Orlando, FL 32825
tel: (407) 205-7787
www.ArktechSolution.com

FC NAME:

FCID:
N/A

FC ADDRESS:

FIELD SURVEYOR:

PROJECT DIRECTOR:
M.Vanegas

CHECKED BY:

DATE COMPLETED:
12-23-2019

PROJECT NUMBER:

SHEET:
A008.1

DRAWING NUMBER:
37

OF:
41

DRAWING NAME:
D&W SCHEDULE 1st FL

DOOR SCHEDULE															
DOOR NO.	TYPE	CLEAR OPNG WIDTH	FINISH	SIZE (WIDTH X HEIGHT)	DOOR			FRAME		HARDWARE DETAILS				THK.	REMARKS
					TYPE	MAT'L	COND.	TYPE	MAT'L	HEAD	JAMB	SILL	TYPE		
201.1	15	2'-6"	PAINT	2'-6" X 6'-8"	INTERIOR	WOOD	GOOD	WOOD	WOOD						
201.2	3	2'-9"	PAINT	2'-9" X 6'-8"	INTERIOR	WOOD	GOOD	WOOD	WOOD						
201.3	16	3'-2"	PAINT	3'-2" X 6'-8"	INTERIOR	WOOD	GOOD	WOOD	WOOD						
201.4	17	2'-4"	PAINT	2'-4" X 6'-8"	INTERIOR	WOOD	GOOD	WOOD	WOOD						
201.5	18	2'-0"	PAINT	2'-0" X 5'-11"	INTERIOR	WOOD	GOOD	WOOD	WOOD						RESTROOM DOOR
201.6	19	2'-0"	PAINT	2'-0" X 6'-8"	INTERIOR	WOOD	GOOD	WOOD	WOOD						RESTROOM DOOR
201.7	20	2'-6"	PAINT	2'-6" X 5'-11"	INTERIOR	WOOD	GOOD	WOOD	WOOD						RESTROOM DOOR
201.8	21	3'-0"	PAINT	3'-0" X 6'-9"	INTERIOR	WOOD	GOOD	WOOD	WOOD						
201.9	22	4'-7"	PAINT	4'-7" X 6'90"	INTERIOR	WOOD	GOOD	WOOD	WOOD						
201.10	23	3'-0"	PAINT	3'-0" X 6'-8"	INTERIOR	WOOD	GOOD	WOOD	WOOD						
201.11	24	3'-4"	STAINED	3'-4" X 6'-8"	EXTERIOR	MTL	GOOD	MTL	MTL						FIRE RATED WITH PANIC HARDWARE AND CLOSER
201.12	25	2'-6"	PAINT	2'-6" X 6'-7"	INTERIOR	WOOD	GOOD	WOOD	WOOD						
201.13	26	6'-0"	PAINT	6'-0" X 6'-8"	INTERIOR	WOOD	GOOD	WOOD	WOOD						
201.14	27	2'-8"	PAINT	2'-8" X 6'-9"	INTERIOR	WOOD	GOOD	WOOD	WOOD						
201.15	28	3'-2"	PAINT	3'-2" X 6'-9"	INTERIOR	WOOD	GOOD	WOOD	WOOD						
201.16	29	2'-6"	PAINT	2'-6" X 6'-9"	INTERIOR	WOOD	GOOD	WOOD	WOOD						
201.17	30	3'-1"	PAINT	3'-1" X 6'-8"	INTERIOR	WOOD	GOOD	WOOD	WOOD						
DOOR & WINDOW SCHEDULES														SCALE: NTS	1

WINDOW SCHEDULE									
WINDOW NO.	HARD-WARE	TYPE	WINDOW SIZE	SILL HEIGHT (A.F.F.)		FRAME		GLAZING	REMARKS
					FINISH	MAT'L	SIZE		
201.A	-	A	3'-3" X19'-1"	7'-3"	H.M. WELDED	MTL	2"X6" TYP.	INSULATED	
201.B	-	B	4'-0" X 8'-7"	1'-4"	H.M. WELDED	MTL	2"X6" TYP.	INSULATED	
201.C	-	C	3'-0" X 15'-0"	6'-4"	H.M. WELDED	MTL	2"X6" TYP.	INSULATED	
201.D	-	D	14'-1" X 8'-10"	3'-0"	H.M. WELDED	MTL	2"X6" TYP.	INSULATED	
201.E	-	E	9'-0" X 8'-4"	3'-2"	H.M. WELDED	MTL	2"X6" TYP.	INSULATED	
201.F	-	F	13'-3" X 8'-4"	3'-1"	H.M. WELDED	MTL	2"X6" TYP.	INSULATED	
201.G	-	G	13'-1" X 8'-4"	3'-2"	H.M. WELDED	MTL	2"X6" TYP.	INSULATED	
201.H	-	H	5'-0" X 8'-0"	3'-1"	H.M. WELDED	MTL	2"X6" TYP.	INSULATED	
DOOR & WINDOW SCHEDULES									
								SCALE: NTS	2

OWNER:

CLIENT:



Arktech Solutions LLC.
10804 Inside Loop
Orlando, FL 32825
tel: (407) 205-7787
www.ArktechSolution.com

FC NAME:

FCID:
N/A

FC ADDRESS:

FIELD SURVEYOR:

PROJECT DIRECTOR:
M.Vanegas

CHECKED BY:

DATE COMPLETED:
12-23-2019

PROJECT NUMBER:

SHEET:
A008.2

DRAWING NUMBER:
38

OF:
41

DRAWING NAME:
D&W SCHEDULE 2nd FL

WINDOW SCHEDULE									
WINDOW NO.	HARD-WARE	TYPE	WINDOW SIZE	SILL HEIGHT (A.F.F.)		FRAME		GLAZING	REMARKS
					FINISH	MAT'L	SIZE		
201.I	-	I	4'-7" X9'-0"	3'-1"	H.M. WELDED	MTL	2"X6" TYP.	INSULATED	
201.J	-	J	4'-10" X 9'-0"	3'-1"	H.M. WELDED	MTL	2"X6" TYP.	INSULATED	
201.K	-	K	3'-4" X 10'-11"	2'-0"	H.M. WELDED	MTL	2"X6" TYP.	INSULATED	
201.L	-	L	1'-0" X 7'-6"	4"	H.M. WELDED	MTL	2"X6" TYP.	INSULATED	
201.M	-	M	2'-11" X 14'-10"	4"	H.M. WELDED	MTL	2"X6" TYP.	INSULATED	
201.N	-	N	1'-0" X 22'-4"	4"	H.M. WELDED	MTL	2"X6" TYP.	INSULATED	
201.O	-	O	2'-11" X 22'-4"	4"	H.M. WELDED	MTL	2"X6" TYP.	INSULATED	
201.P	-	P	1'-0" X 29'-7"	4"	H.M. WELDED	MTL	2"X6" TYP.	INSULATED	
201.Q	-	Q	2'-11" X 37'-2"	4"	H.M. WELDED	MTL	2"X6" TYP.	INSULATED	
201.R	-	R	1'-0" X 37'-0"	4"	H.M. WELDED	MTL	2"X6" TYP.	INSULATED	
201.S	-	S	7'-6" X 6'-11"	3'-0"	H.M. WELDED	MTL	2"X6" TYP.	INSULATED	
201.T	-	T	7'-10" X 2'-10"	3"	H.M. WELDED	MTL	2"X6" TYP.	INSULATED	
201.U	-	U	2'-10" X 5'-2"	3'-3"	H.M. WELDED	MTL	2"X6" TYP.	INSULATED	
201.V	-	V	4'-0" X 6'-6"	3'-7"	H.M. WELDED	MTL	2"X6" TYP.	INSULATED	
					DOOR & WINDOW SCHEDULES				SCALE: NTS
									2



OWNER:

CLIENT:



Arktech Solutions LLC.
10804 Inside Loop
Orlando, FL 32825
tel: (407) 205-7787
www.ArktechSolution.com

FC NAME:	----
FCID:	N/A
FC ADDRESS:	----- ----- -----
FIELD SURVEYOR:	----
PROJECT DIRECTOR:	M.Vanegas
CHECKED BY:	-----
DATE COMPLETED:	12-23-2019
PROJECT NUMBER:	----
SHEET:	A008.3
DRAWING NUMBER:	39
OF:	41
DRAWING NAME:	D&W SCHEDULE 2nd FL

DOOR SCHEDULE															
DOOR NO.	TYPE	CLEAR OPNG WIDTH	FINISH	SIZE (WIDTH X HEIGHT)	DOOR			FRAME		HARDWARE DETAILS				THK.	REMARKS
					TYPE	MAT'L	COND.	TYPE	MAT'L	HEAD	JAMB	SILL	TYPE		
301.1	31	2'-9"	PAINT	2'-9" X 6'-9"	INTERIOR	WOOD	GOOD	WOOD	WOOD						
301.2	29	2'-6"	PAINT	2'-9" X 6'-9"	INTERIOR	WOOD	GOOD	WOOD	WOOD						
301.3	32	3'-4"	PAINT	3'-4" X 6'-9"	INTERIOR	WOOD	GOOD	WOOD	WOOD						FIRE RATED WITH PANIC HARDWARE AND CLOSER
301.4	23	3'-0"	PAINT	3'-0" X 6'-8"	INTERIOR	WOOD	GOOD	WOOD	WOOD						
301.5	17	2'-4"	PAINT	2'-4" X 6'-8"	INTERIOR	WOOD	GOOD	WOOD	WOOD						
301.6	33	3'-3"	STAINED	3'-3" X 6'-5"	EXTERIOR	MTL	GOOD	MTL	MTL						
301.7	34	3'-2"	PAINT	3'-2" X 6'-7"	EXTERIOR	MTL	GOOD	MTL	MTL						
301.8	35	4'-0"	PAINT	4'-0" X 6'-8"	INTERIOR	WOOD	GOOD	WOOD	WOOD						BI-FOLD DOOR
DOOR & WINDOW SCHEDULES															SCALE: NTS
1															

WINDOW SCHEDULE									
WINDOW NO.	HARD-WARE	TYPE	WINDOW SIZE	SILL HEIGHT (A.F.F.)		FRAME		GLAZING	REMARKS
					FINISH	MAT'L	SIZE		
301.A	-	A	7'-6" X7'-9"	3'-1"	H.M. WELDED	MTL	2"X6" TYP.	INSULATED	
301.B	-	B	7'-5" X 7'-9"	3'-1"	H.M. WELDED	MTL	2"X6" TYP.	INSULATED	
301.C	-	C	13'-1" X 7'-10"	3'-1"	H.M. WELDED	MTL	2"X6" TYP.	INSULATED	
301.D	-	D	5'-11" X 7'-9"	3'-1"	H.M. WELDED	MTL	2"X6" TYP.	INSULATED	
201.E	-	E	2'-11" X 7'-9"	3'-1"	H.M. WELDED	MTL	2"X6" TYP.	INSULATED	
201.F	-	F	5'-0" X 7'-9"	3'-1"	H.M. WELDED	MTL	2"X6" TYP.	INSULATED	
201.G	-	G	39'-6" X 8'-10"	3'-1"	H.M. WELDED	MTL	2"X6" TYP.	INSULATED	
DOOR & WINDOW SCHEDULES									
									SCALE: NTS
2									

OWNER:

CLIENT:



Arktech Solutions LLC.
10804 Inside Loop
Orlando, FL 32825
tel: (407) 205-7787
www.ArktechSolution.com

FC NAME:	----
FCID:	N/A
FC ADDRESS:	----- ----- -----

FIELD SURVEYOR:	----
PROJECT DIRECTOR:	M.Vanegas
CHECKED BY:	-----
DATE COMPLETED:	12-23-2019

PROJECT NUMBER:	----
SHEET:	A008.4
DRAWING NUMBER:	40
OF:	41

DRAWING NAME:	D&W SCHEDULE 3rd FL
---------------	---------------------

DOOR SCHEDULE															
DOOR NO.	TYPE	CLEAR OPNG WIDTH	FINISH	SIZE (WIDTH X HEIGHT)	DOOR			FRAME		HARDWARE DETAILS				THK.	REMARKS
					TYPE	MAT'L	COND.	TYPE	MAT'L	HEAD	JAMB	SILL	TYPE		
401.1	31	2'-9"	PAINT	2'-9" X 6'-9"	INTERIOR	WOOD	GOOD	WOOD	WOOD						
401.2	32	3'-4"	PAINT	3'-4" X 6'-9"	INTERIOR	WOOD	GOOD	WOOD	WOOD						
401.3	36	3'-4"	PAINT	3'-4" X 6'-8"	INTERIOR	WOOD	GOOD	WOOD	WOOD						
401.4	37	3'-4"	STAINED	3'-4" X 6'-9"	EXTERIOR	MTL	GOOD	MTL	MTL						FIRE RATED WITH PANIC HARDWARE AND CLOSER
DOOR & WINDOW SCHEDULES														SCALE: NTS	1

OWNER:

CLIENT:



Arktech Solutions LLC.
10804 Inside Loop
Orlando, FL 32825
tel: (407) 205-7787
www.ArktechSolution.com

FC NAME:	----
FCID:	N/A
FC ADDRESS:	----- ----- -----

FIELD SURVEYOR:	----
PROJECT DIRECTOR:	M.Vanegas
CHECKED BY:	-----
DATE COMPLETED:	12-23-2019

PROJECT NUMBER:	----
SHEET:	A008.5
DRAWING NUMBER:	41
OF:	41

DRAWING NAME:	D&W SCHEDULE PH FL
---------------	--------------------