


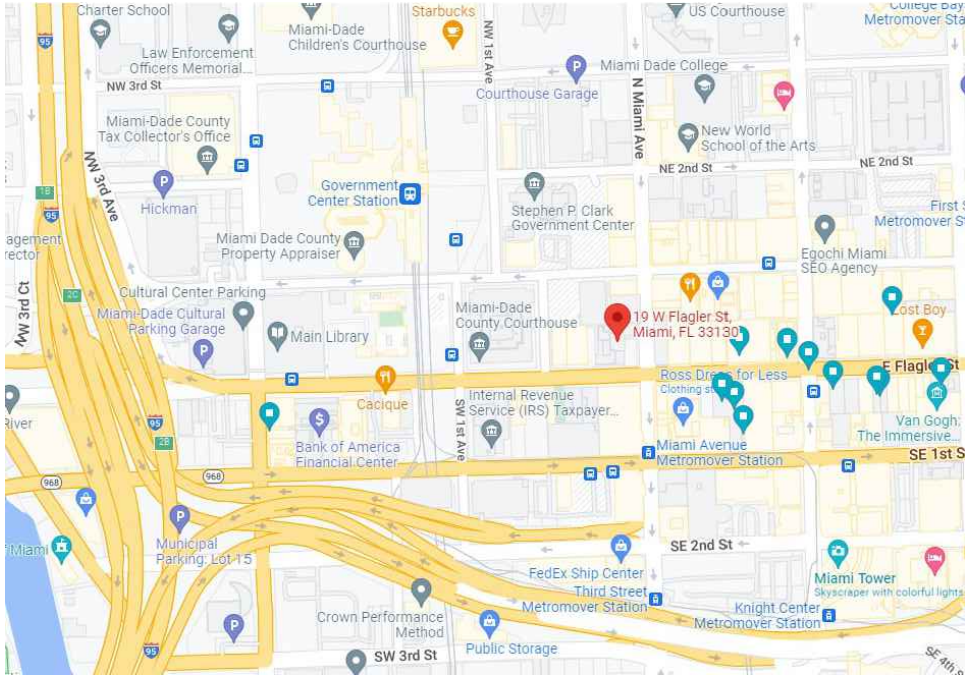

Area Map



Aerial Photograph



Existing Site Photograph



360 Photo / As-Built Survey

Project Name

----

Address

----

----

----

Project Total S.F.

183,857

**Arktech Solutions LLC**  
10804 Inside Loop  
Orlando, FL 32825  
O. 407.205.7787  
P 214 606 5281  
[www.arktechsolution.com](http://www.arktechsolution.com)



SCALE:

NTS


OWNER:

CLIENT:



Arktech Solutions LLC.  
10804 Inside Loop  
Orlando, FL 32825  
tel: (407) 205-7787  
[www.ArktechSolution.com](http://www.ArktechSolution.com)

|                                        |           |
|----------------------------------------|-----------|
| FC NAME:<br>----                       |           |
| FCID:<br>N/A                           |           |
| FC ADDRESS:<br>-----<br>-----<br>----- |           |
| FIELD SURVEYOR:<br>----                |           |
| PROJECT DIRECTOR:<br>M.Vanegas         |           |
| CHECKED BY:<br>----                    |           |
| DATE COMPLETED:<br>10/17/2022          |           |
| PROJECT NUMBER:<br>22916               |           |
| SHEET:<br>SP01                         |           |
| DRAWING NUMBER:<br>2                   | OF:<br>36 |
| DRAWING NAME:<br>SITE PLAN             |           |

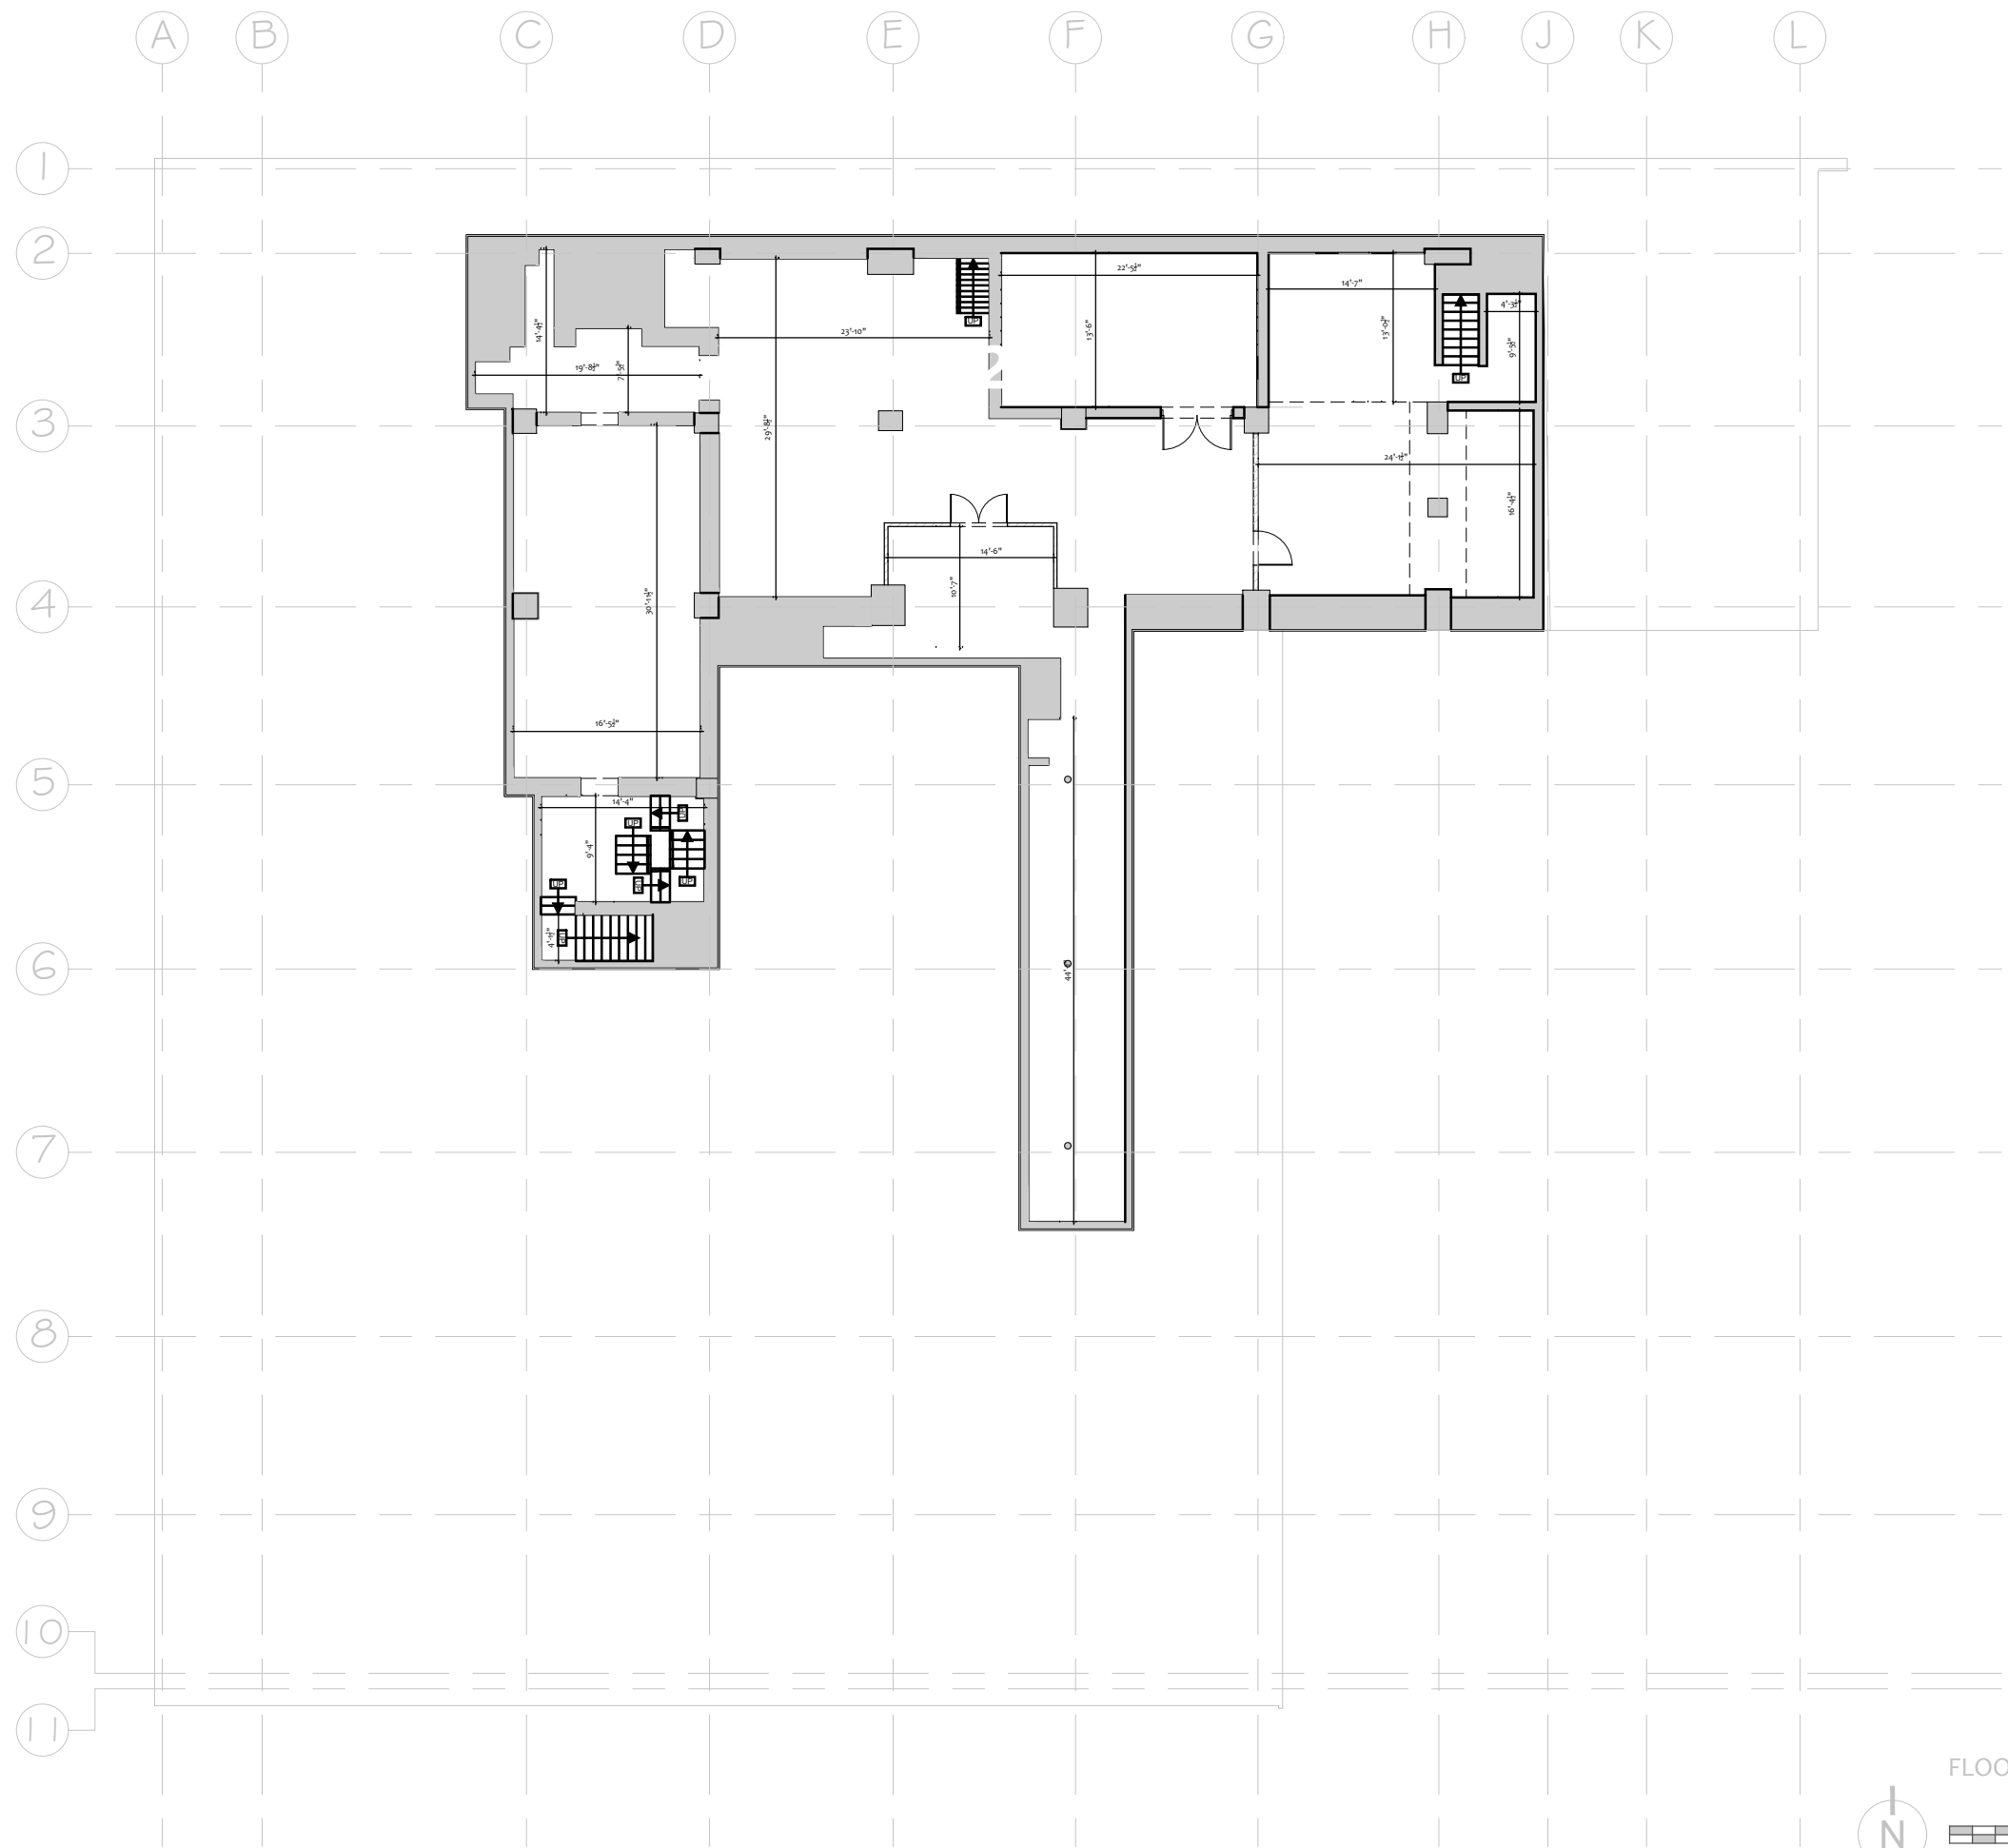

FLOOR GROSS SF: 4,324

SCALE: 1/16" = 1'-0"

OWNER:

CLIENT:




Arktech Solutions LLC.  
10804 Inside Loop  
Orlando, FL 32825  
tel: (407) 205-7787  
[www.ArktechSolution.com](http://www.ArktechSolution.com)

|             |                         |
|-------------|-------------------------|
| FC NAME:    | ----                    |
| FCID:       | N/A                     |
| FC ADDRESS: | -----<br>-----<br>----- |

|                   |            |
|-------------------|------------|
| FIELD SURVEYOR:   | ----       |
| PROJECT DIRECTOR: | M.Vanegas  |
| CHECKED BY:       | ----       |
| DATE COMPLETED:   | 10/17/2022 |

|                 |        |
|-----------------|--------|
| PROJECT NUMBER: | 22916  |
| SHEET:          | A001.1 |
| DRAWING NUMBER: | 3      |
| OF:             | 36     |

|               |                     |
|---------------|---------------------|
| DRAWING NAME: | Basement Floor Plan |
|---------------|---------------------|

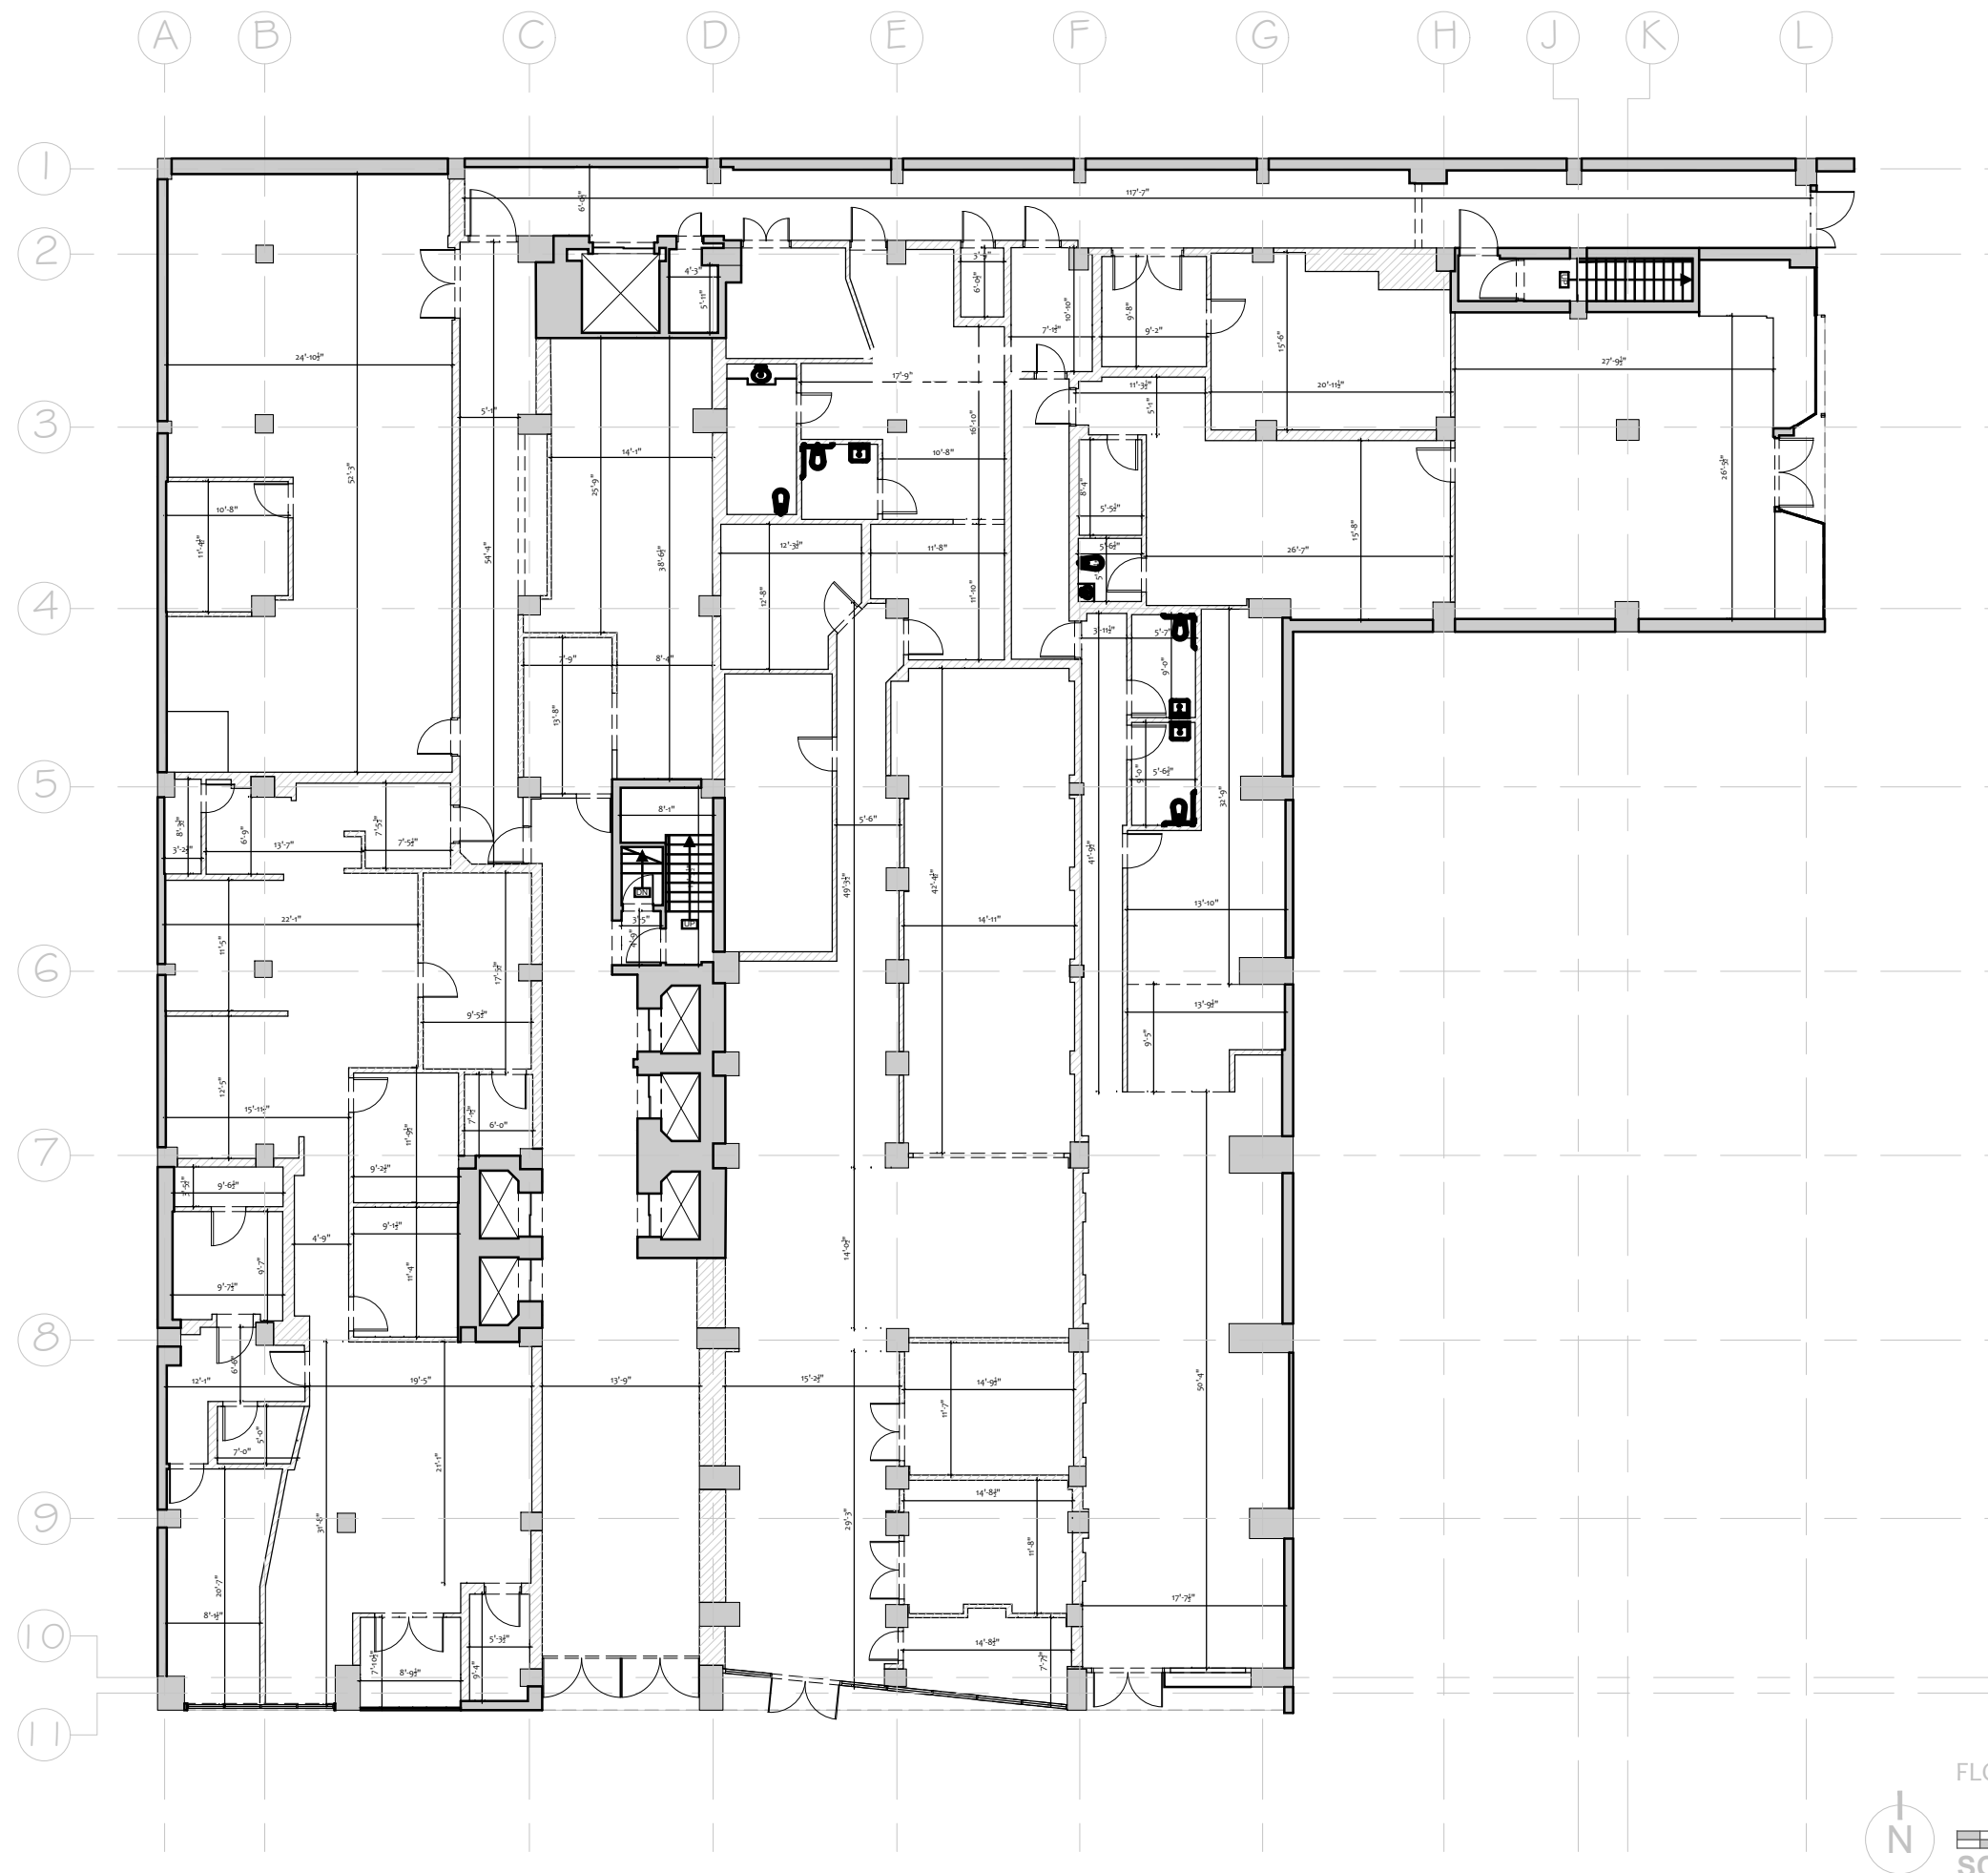

OWNER:

CLIENT:



**Arktech Solutions LLC.**  
10804 Inside Loop  
Orlando, FL 32825  
tel: (407) 205-7787  
[www.ArktechSolution.com](http://www.ArktechSolution.com)



|             |                                                       |
|-------------|-------------------------------------------------------|
| FC NAME:    | 100-000-000-000                                       |
| FCID:       | N/A                                                   |
| FC ADDRESS: | 100-000-000-000<br>100-000-000-000<br>100-000-000-000 |

|                                    |
|------------------------------------|
| FIELD SURVEYOR:<br><br>-----       |
| PROJECT DIRECTOR:<br><br>M.Vanegas |
| CHECKED BY:<br><br>-----           |
| DATE COMPLETED:<br><br>10/17/2022  |

|                              |               |
|------------------------------|---------------|
| PROJECT NUMBER:<br><br>22916 |               |
| SHEET:<br><br>A001.2         |               |
| DRAWING NUMBER:<br><br>4     | OF:<br><br>36 |

DRAWING NAME:

1st Floor Plan

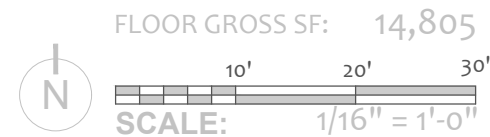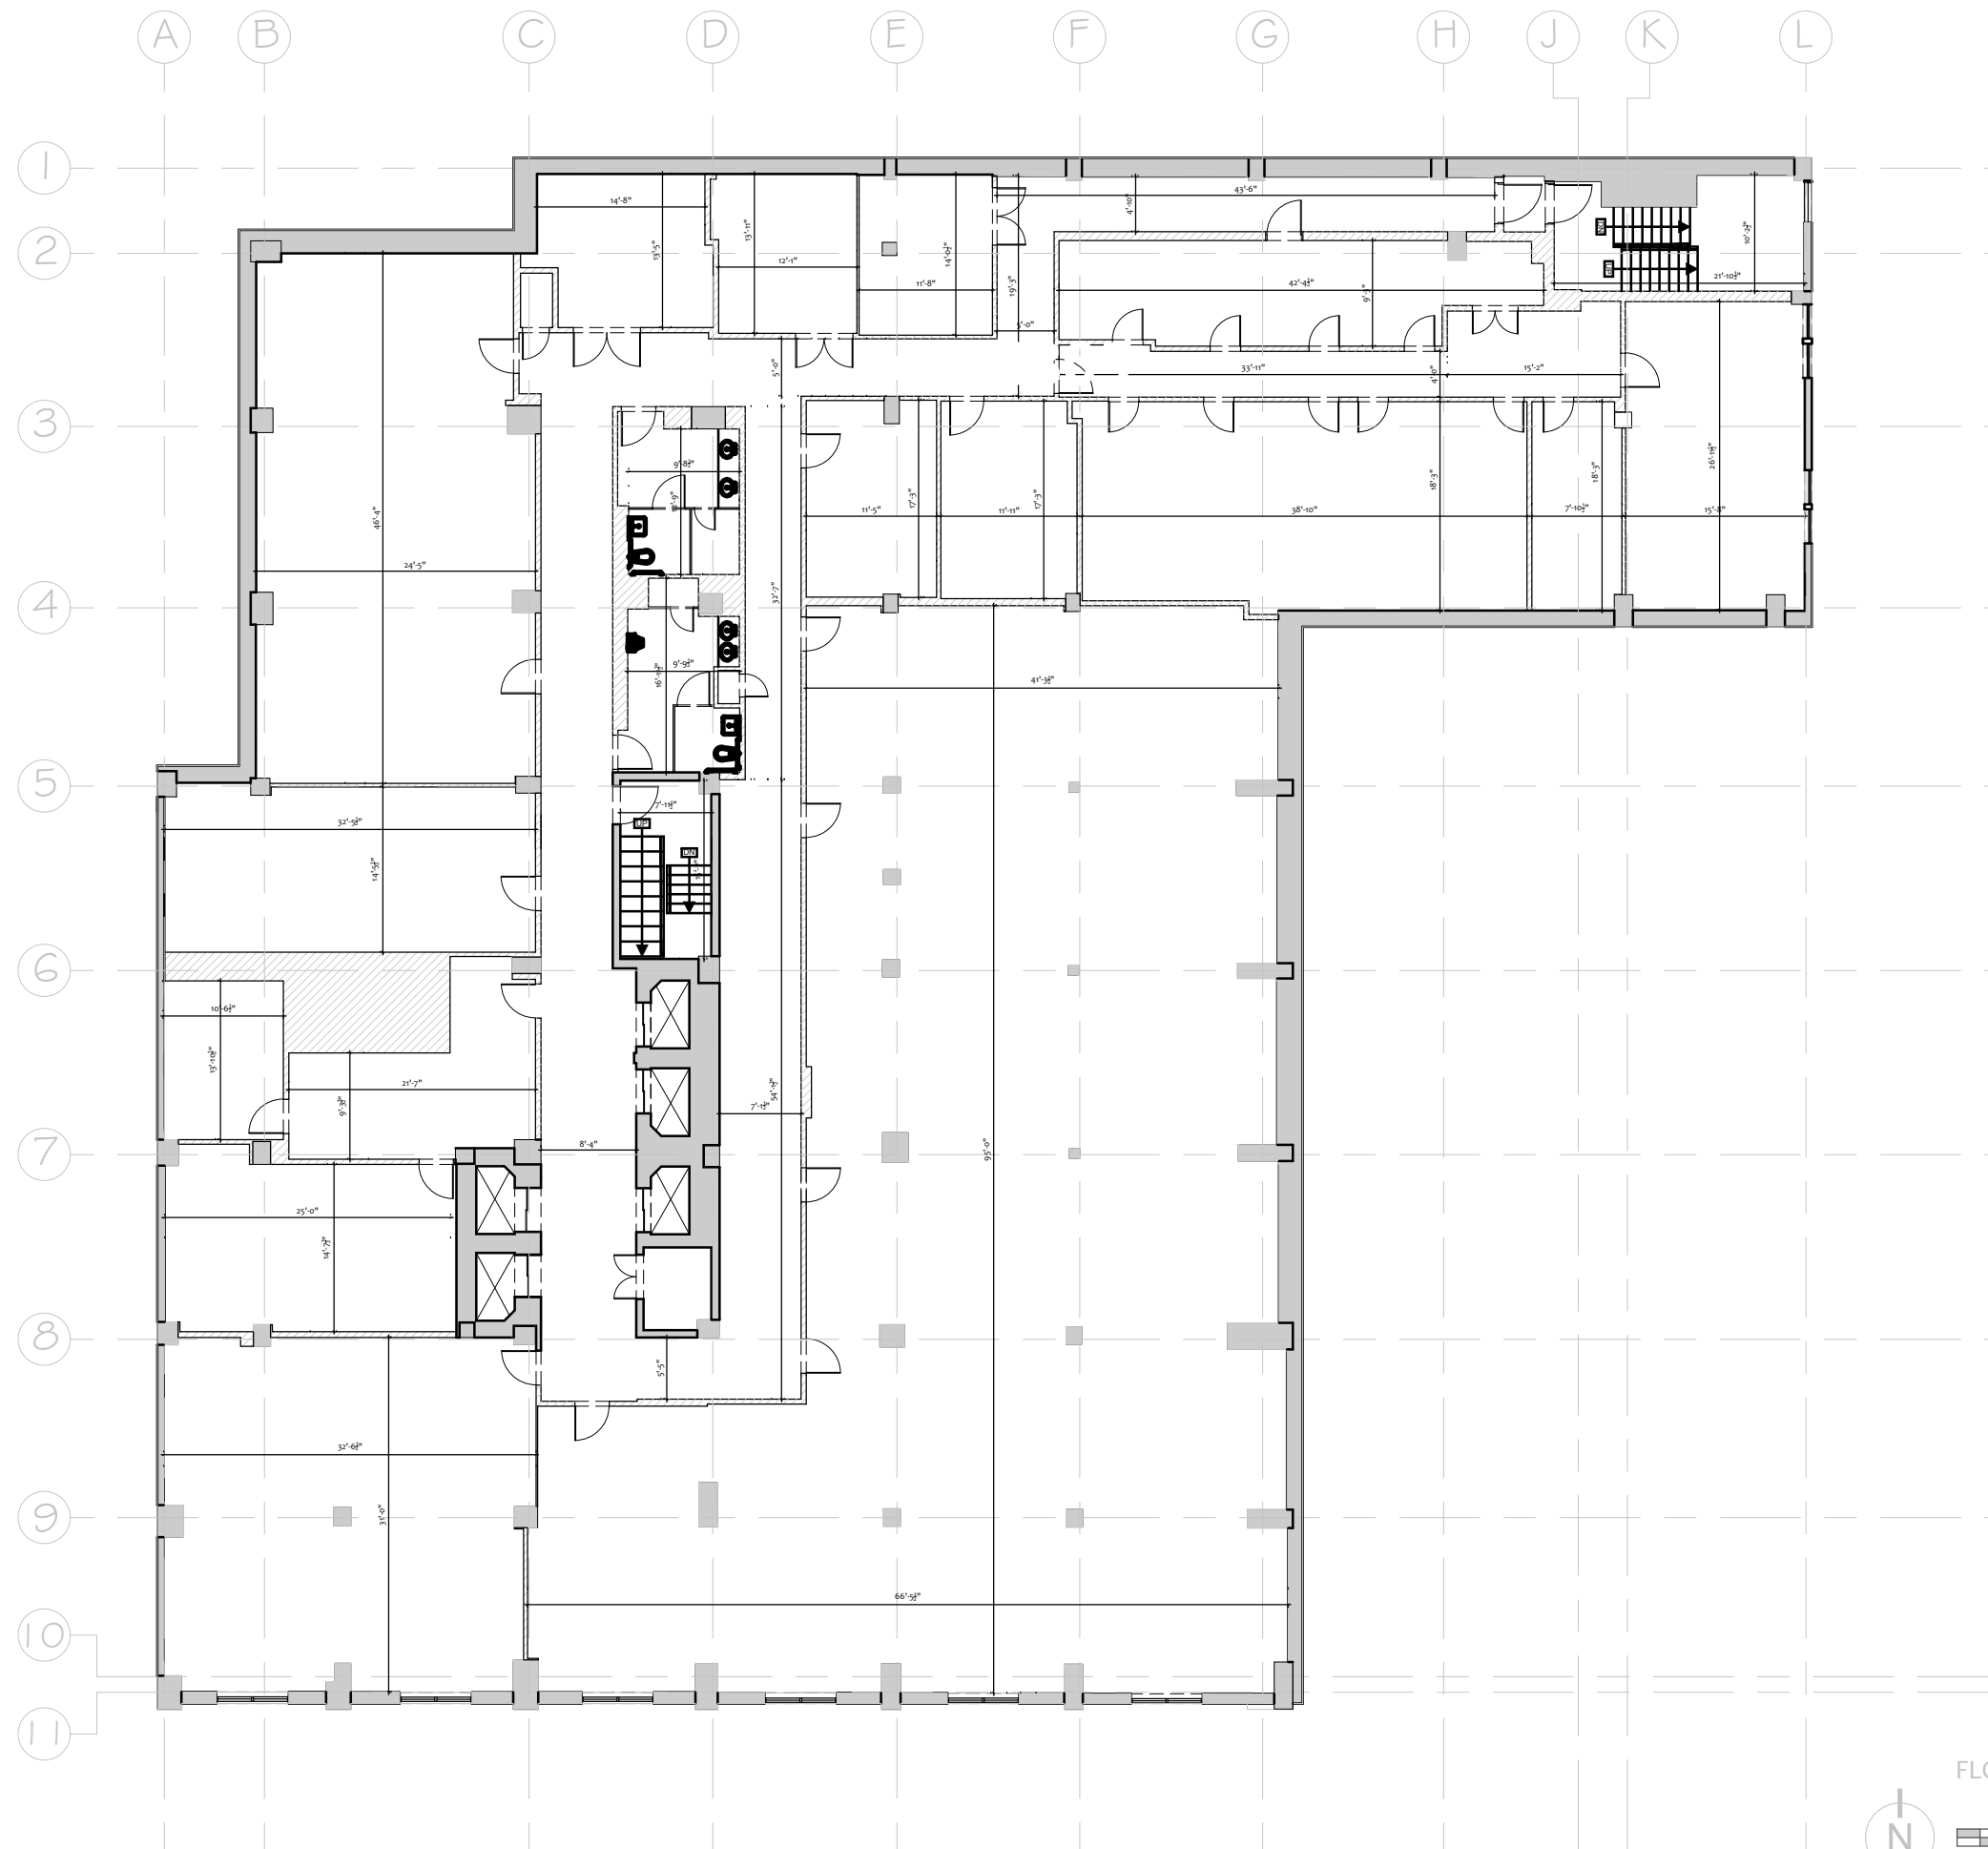

OWNER:

CLIENT:





Arktech Solutions LLC.  
10804 Inside Loop  
Orlando, FL 32825  
tel: (407) 205-7787  
[www.ArktechSolution.com](http://www.ArktechSolution.com)

|             |                         |
|-------------|-------------------------|
| FC NAME:    | ----                    |
| FCID:       | N/A                     |
| FC ADDRESS: | -----<br>-----<br>----- |

|                   |            |
|-------------------|------------|
| FIELD SURVEYOR:   | ----       |
| PROJECT DIRECTOR: | M.Vanegas  |
| CHECKED BY:       | -----      |
| DATE COMPLETED:   | 10/17/2022 |

|                 |        |
|-----------------|--------|
| PROJECT NUMBER: | 22916  |
| SHEET:          | A001.3 |
| DRAWING NUMBER: | 5      |
| OF:             | 36     |

|               |                      |
|---------------|----------------------|
| DRAWING NAME: | Mezzanine Floor Plan |
|---------------|----------------------|

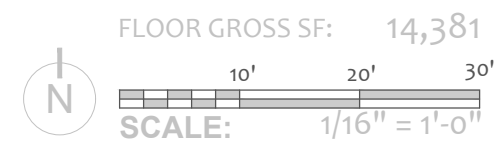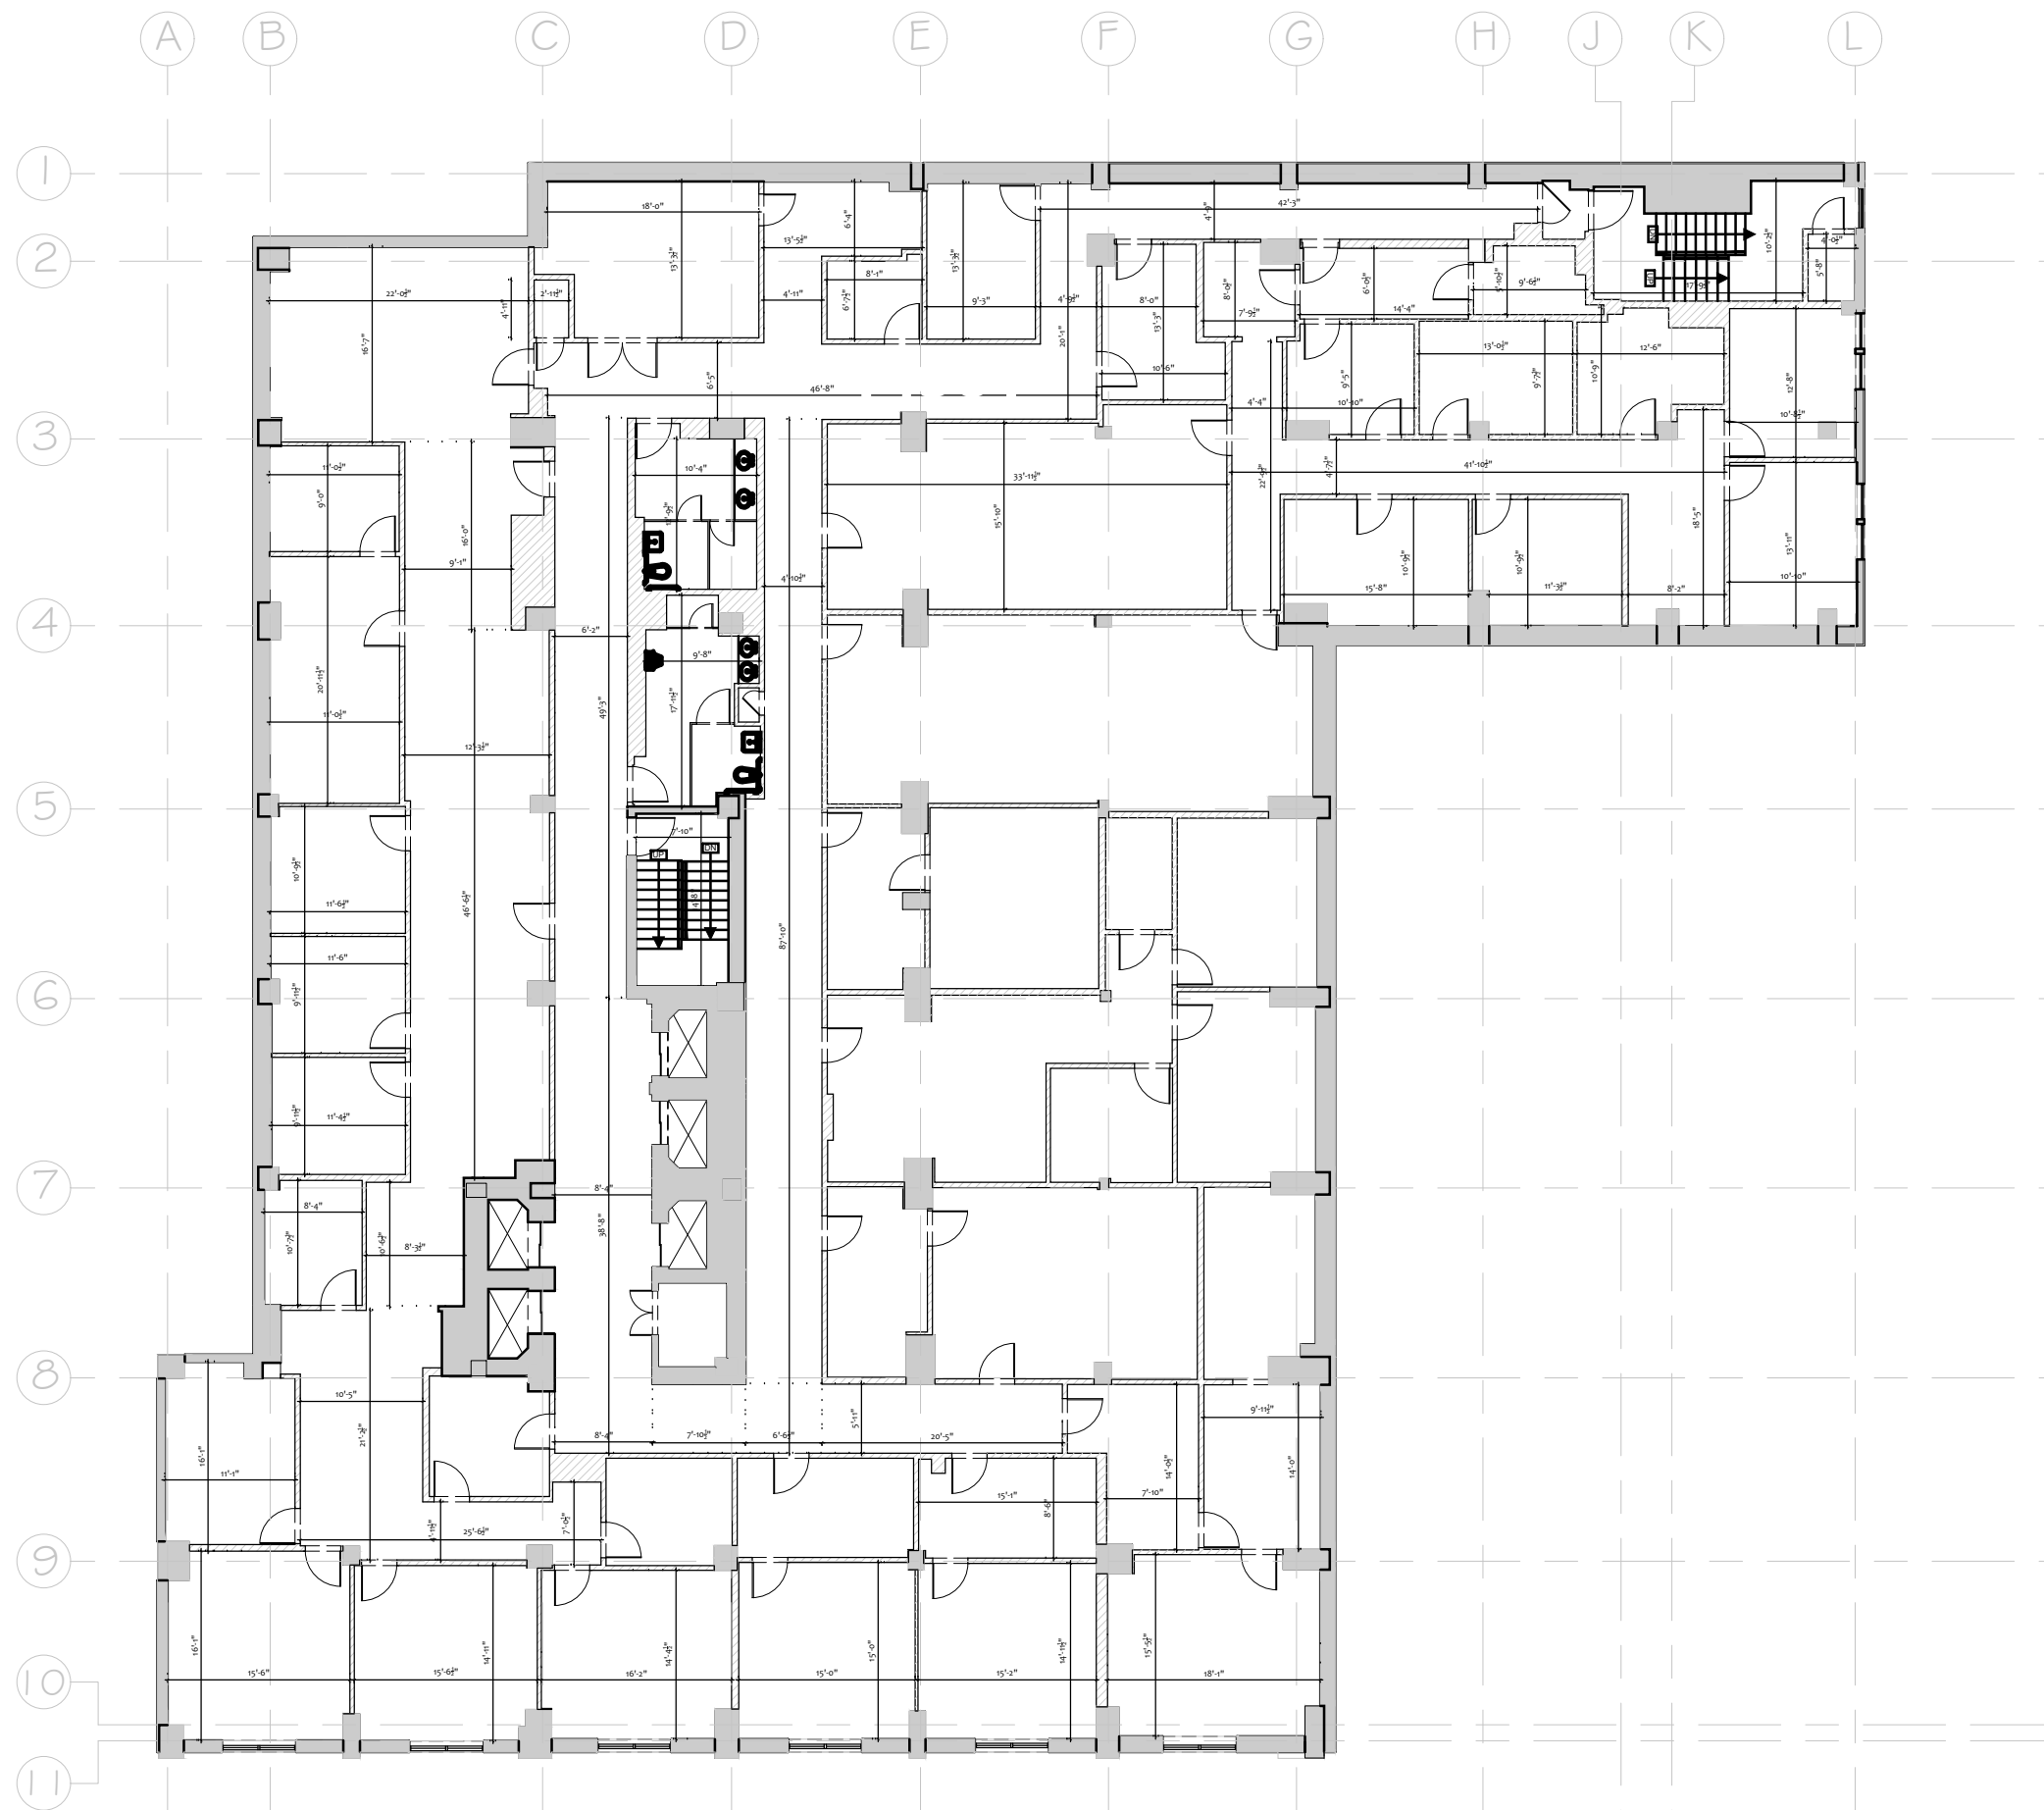

OWNER:

CLIENT:




Arktech Solutions LLC.  
10804 Inside Loop  
Orlando, FL 32825  
tel: (407) 205-7787  
[www.ArktechSolution.com](http://www.ArktechSolution.com)

|             |                         |
|-------------|-------------------------|
| FC NAME:    | ----                    |
| FCID:       | N/A                     |
| FC ADDRESS: | -----<br>-----<br>----- |



|                   |            |
|-------------------|------------|
| FIELD SURVEYOR:   | ----       |
| PROJECT DIRECTOR: | M.Vanegas  |
| CHECKED BY:       | ----       |
| DATE COMPLETED:   | 10/17/2022 |

|                 |        |
|-----------------|--------|
| PROJECT NUMBER: | 22916  |
| SHEET:          | A001.4 |
| DRAWING NUMBER: | 6      |
| OF:             | 36     |

|               |                |
|---------------|----------------|
| DRAWING NAME: | 2nd Floor Plan |
|---------------|----------------|

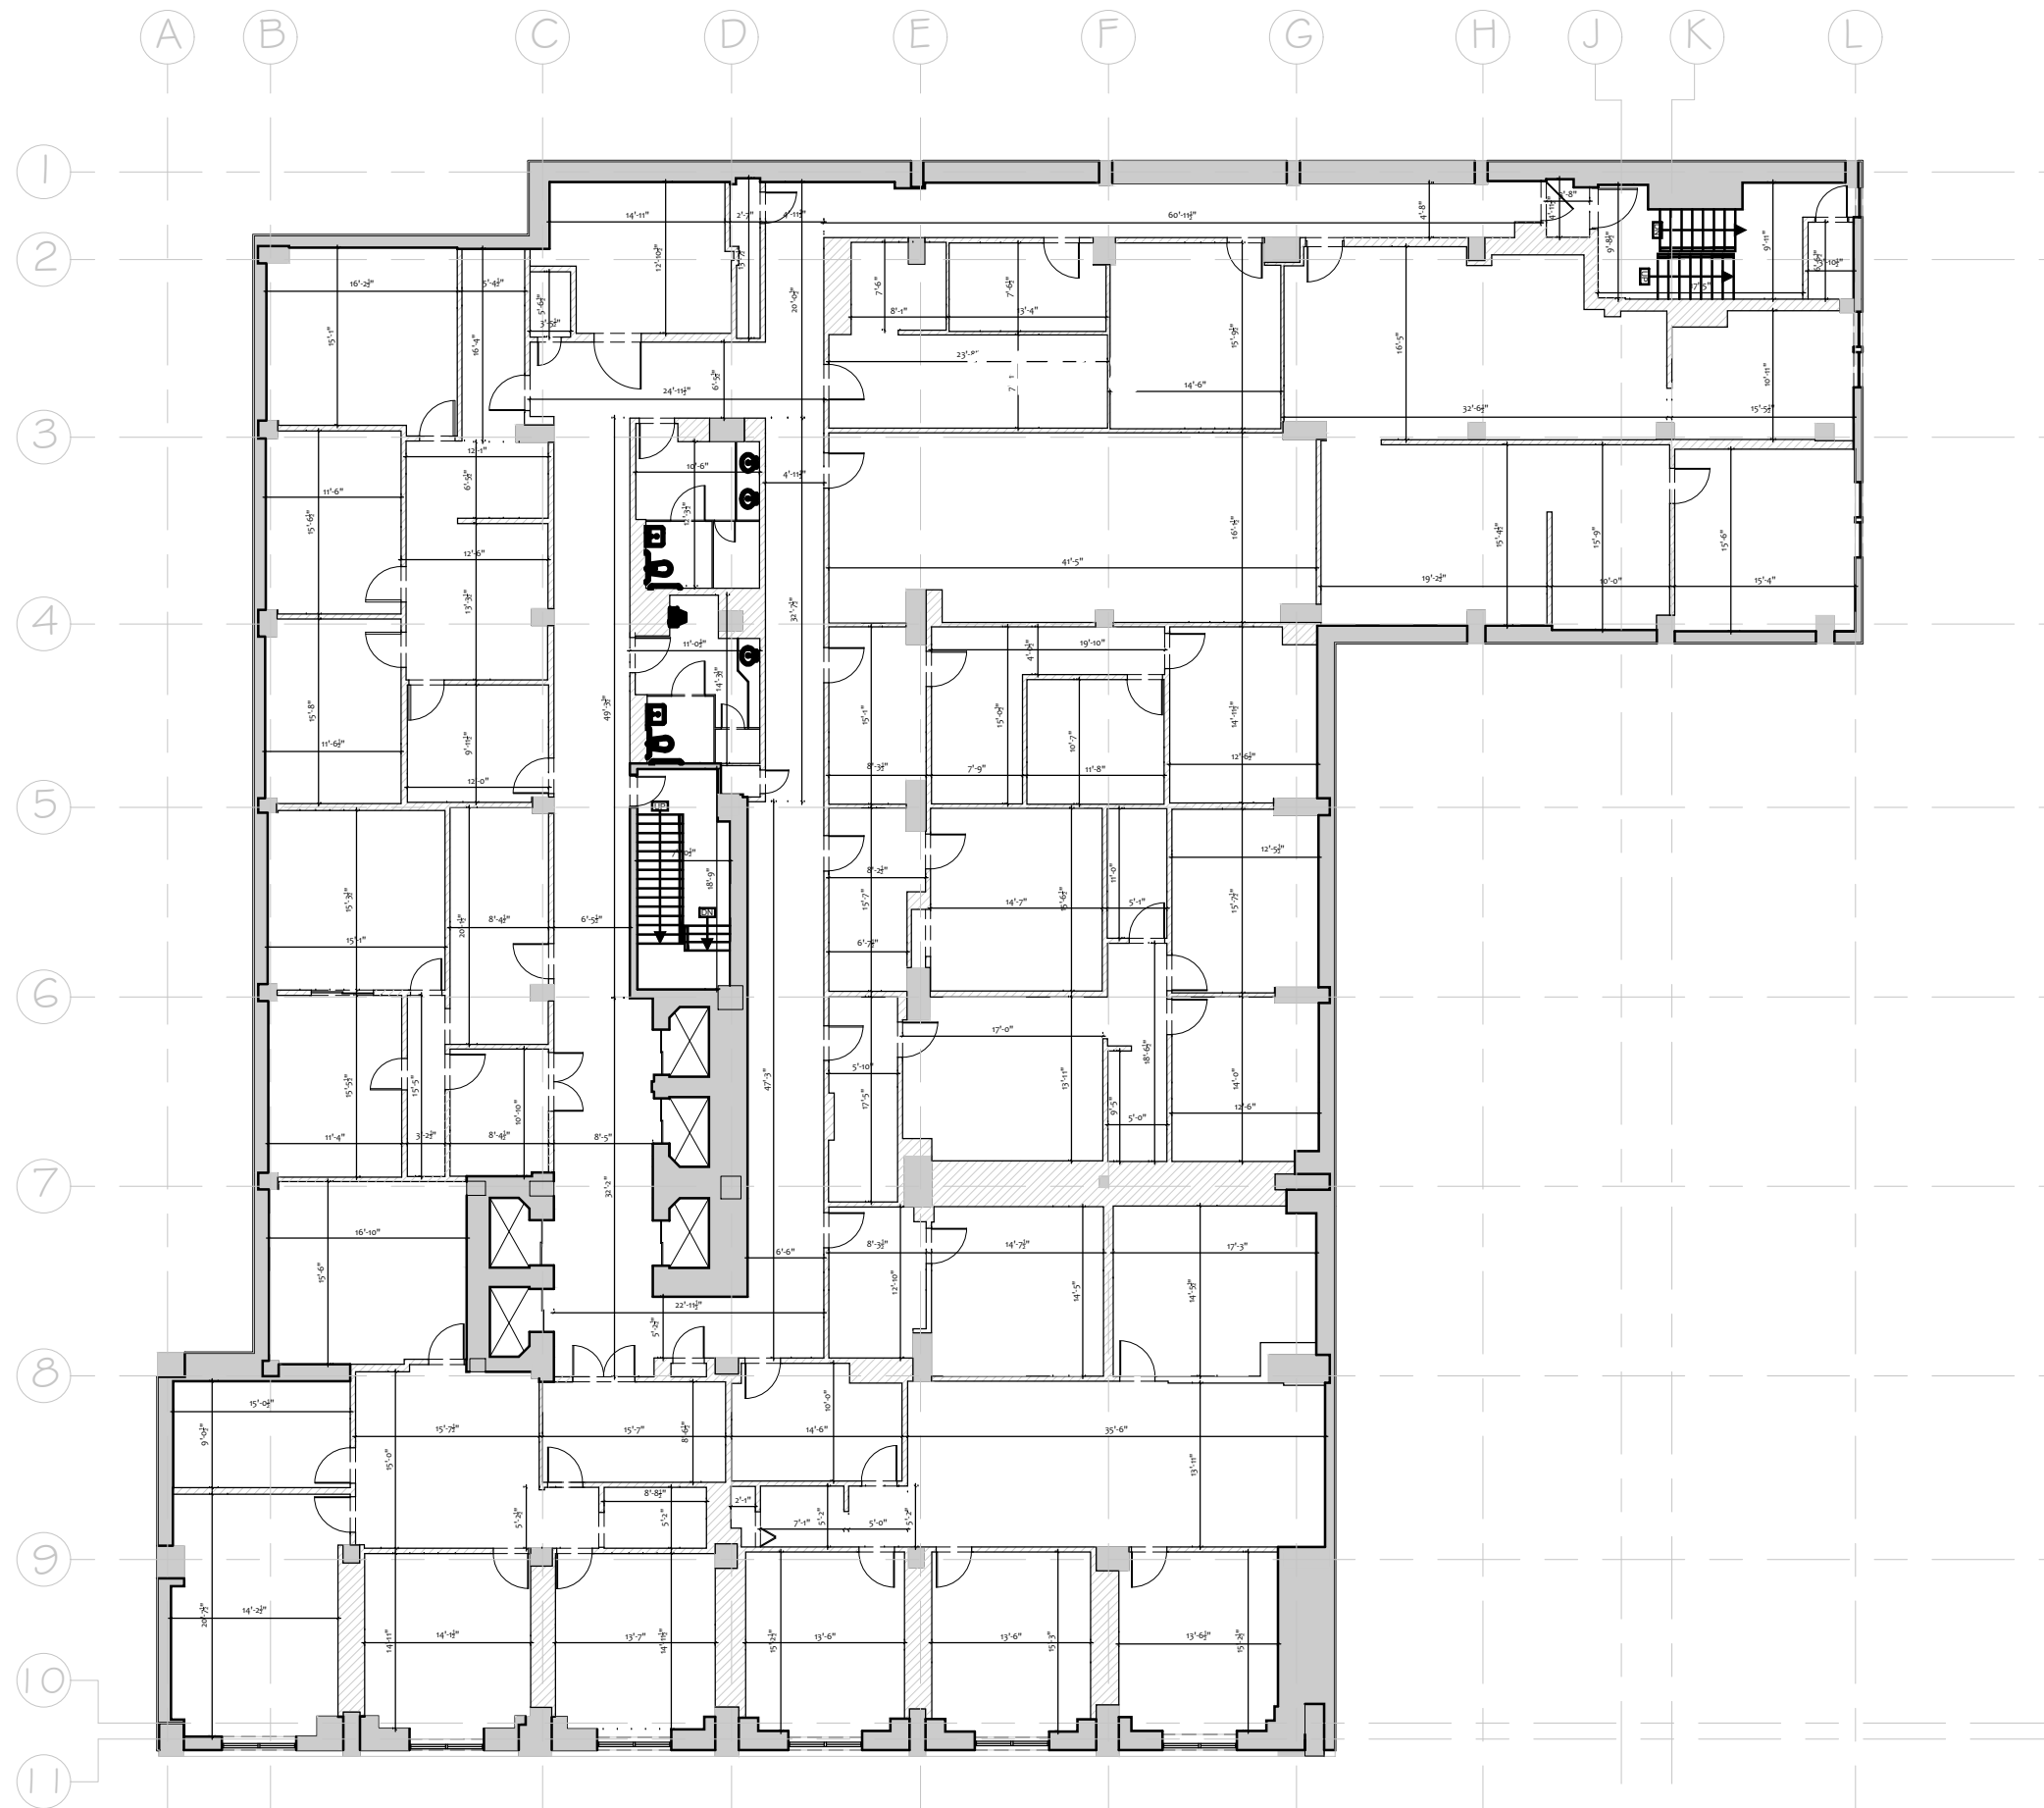



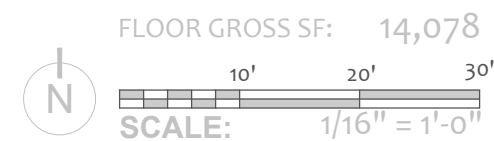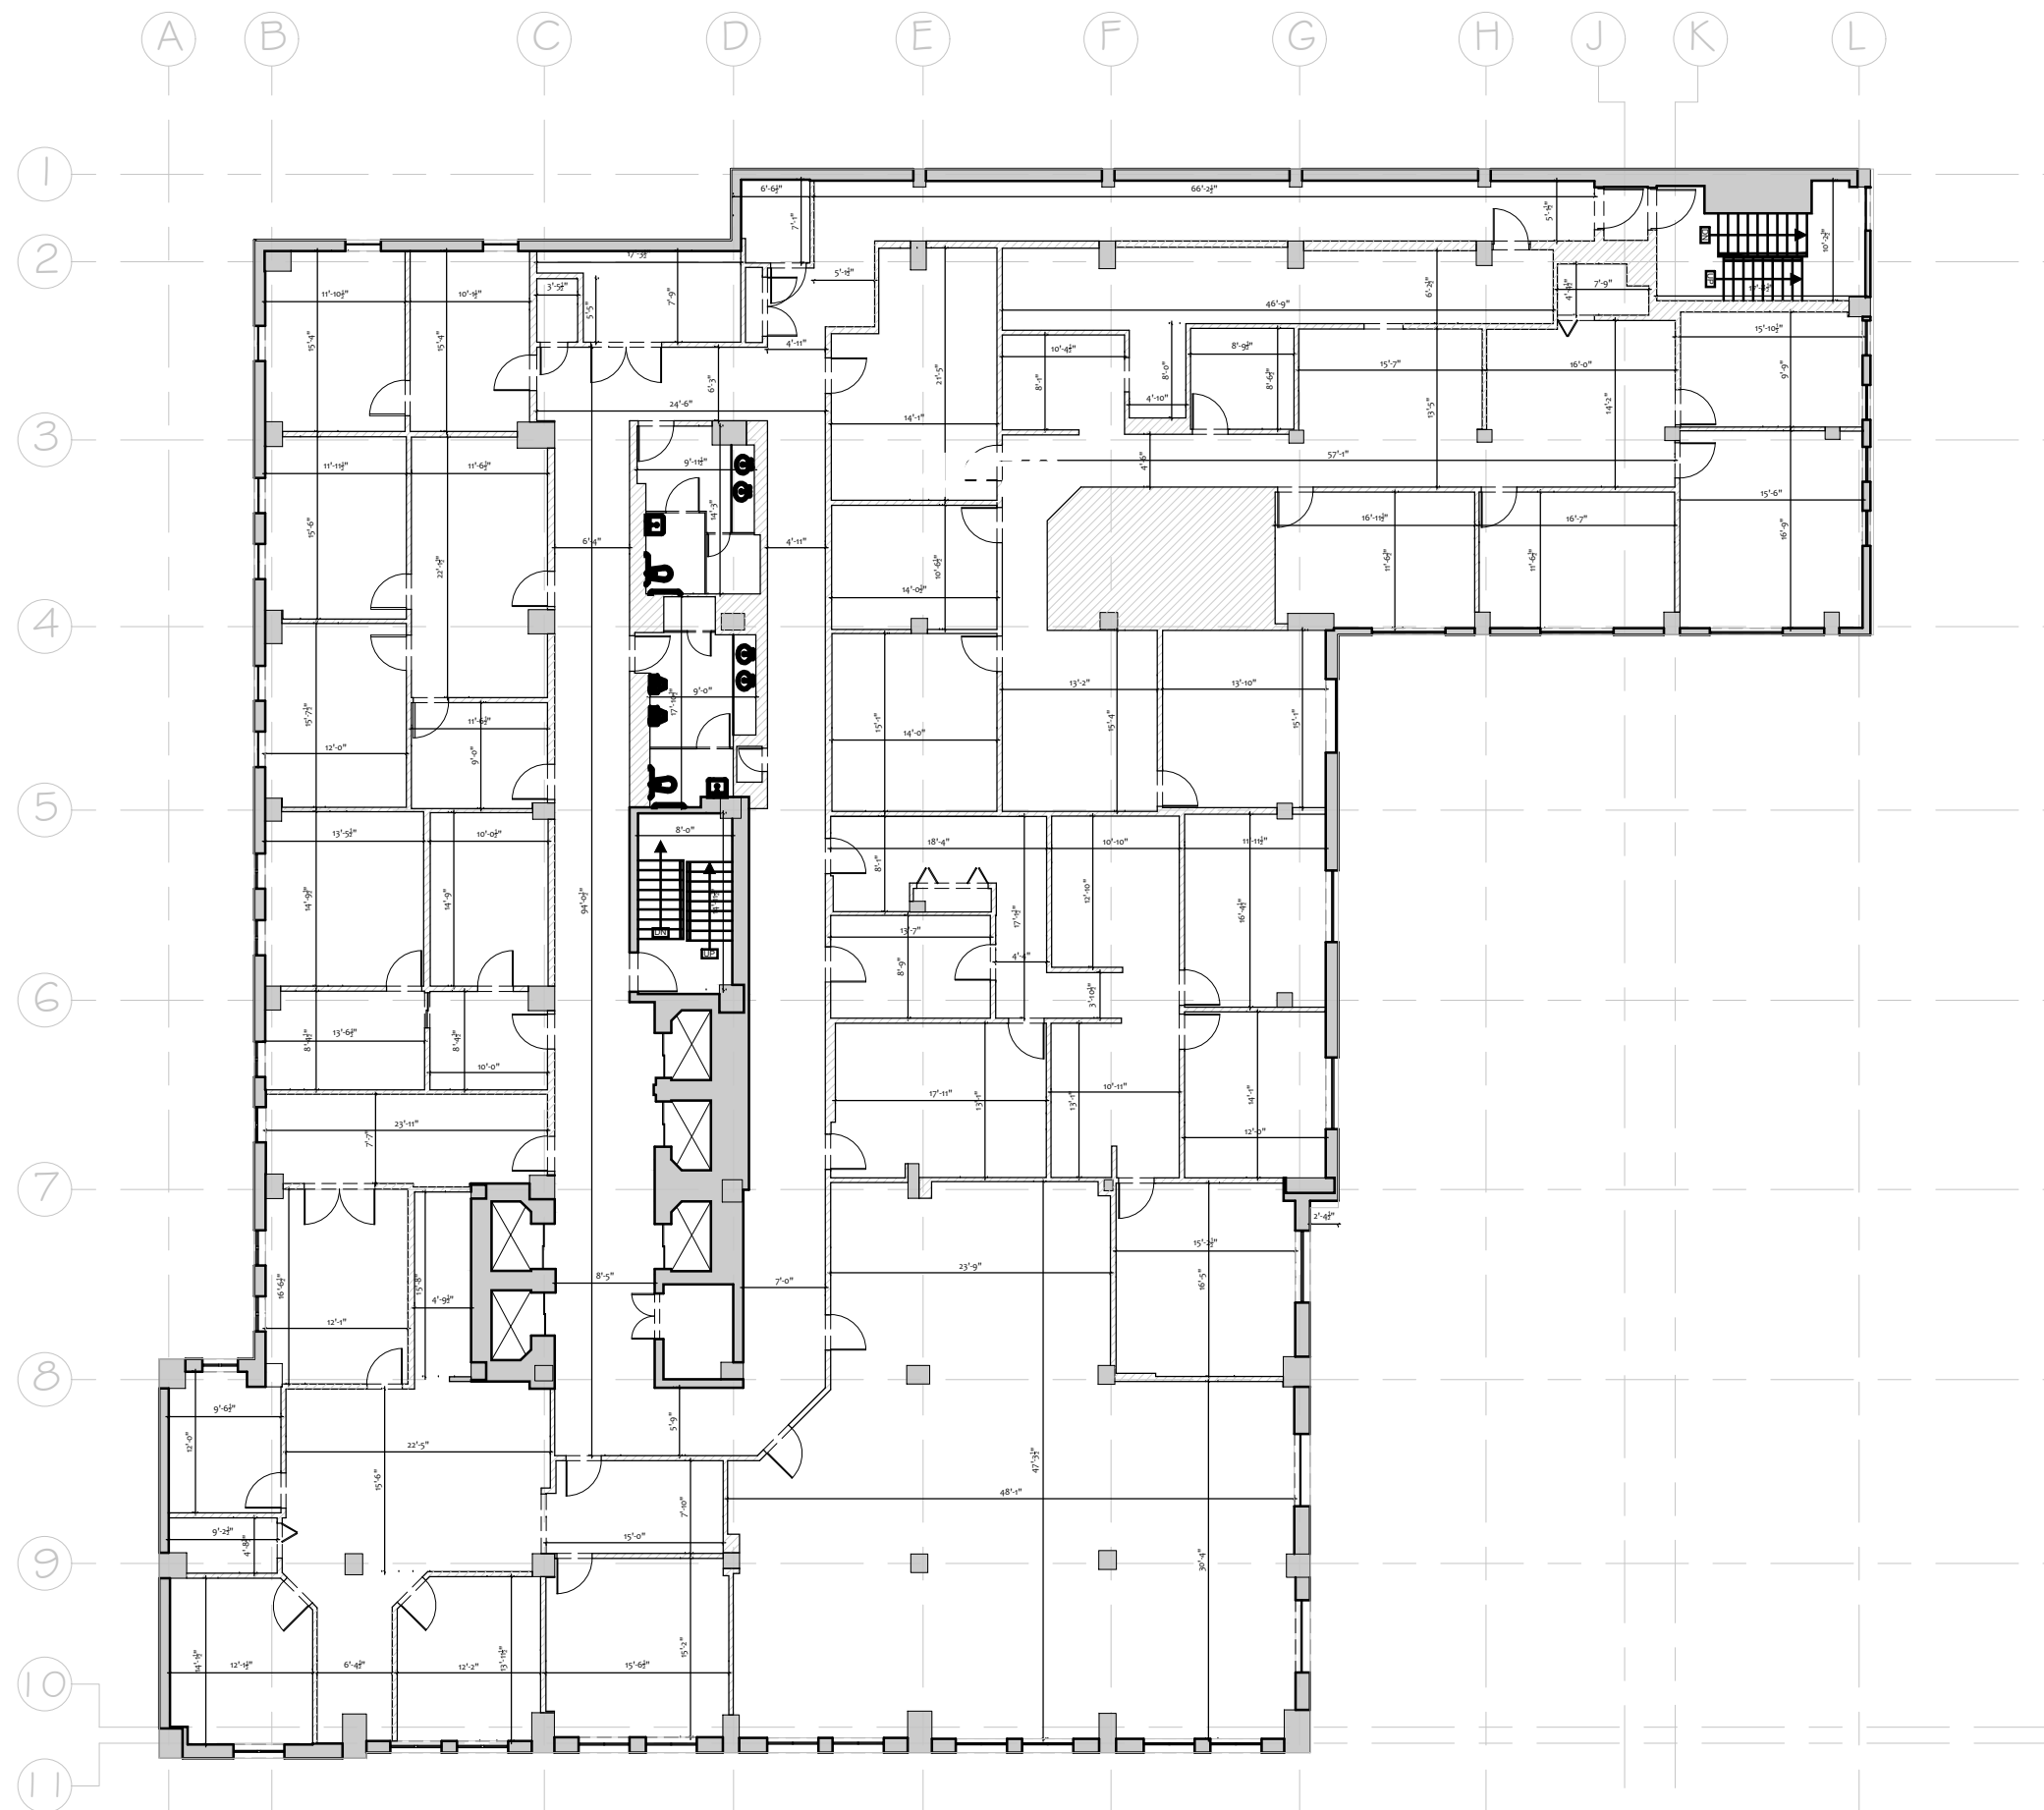

OWNER:

CLIENT:





Arktech Solutions LLC.  
10804 Inside Loop  
Orlando, FL 32825  
tel: (407) 205-7787  
[www.ArktechSolution.com](http://www.ArktechSolution.com)

|             |                         |
|-------------|-------------------------|
| FC NAME:    | ----                    |
| FCID:       | N/A                     |
| FC ADDRESS: | -----<br>-----<br>----- |

|                   |            |
|-------------------|------------|
| FIELD SURVEYOR:   | ----       |
| PROJECT DIRECTOR: | M.Vanegas  |
| CHECKED BY:       | -----      |
| DATE COMPLETED:   | 10/17/2022 |

|                 |        |
|-----------------|--------|
| PROJECT NUMBER: | 22916  |
| SHEET:          | A001.7 |
| DRAWING NUMBER: | 9      |
| OF:             | 36     |

|               |                |
|---------------|----------------|
| DRAWING NAME: | 5th Floor Plan |
|---------------|----------------|

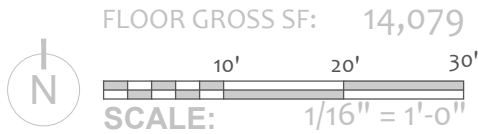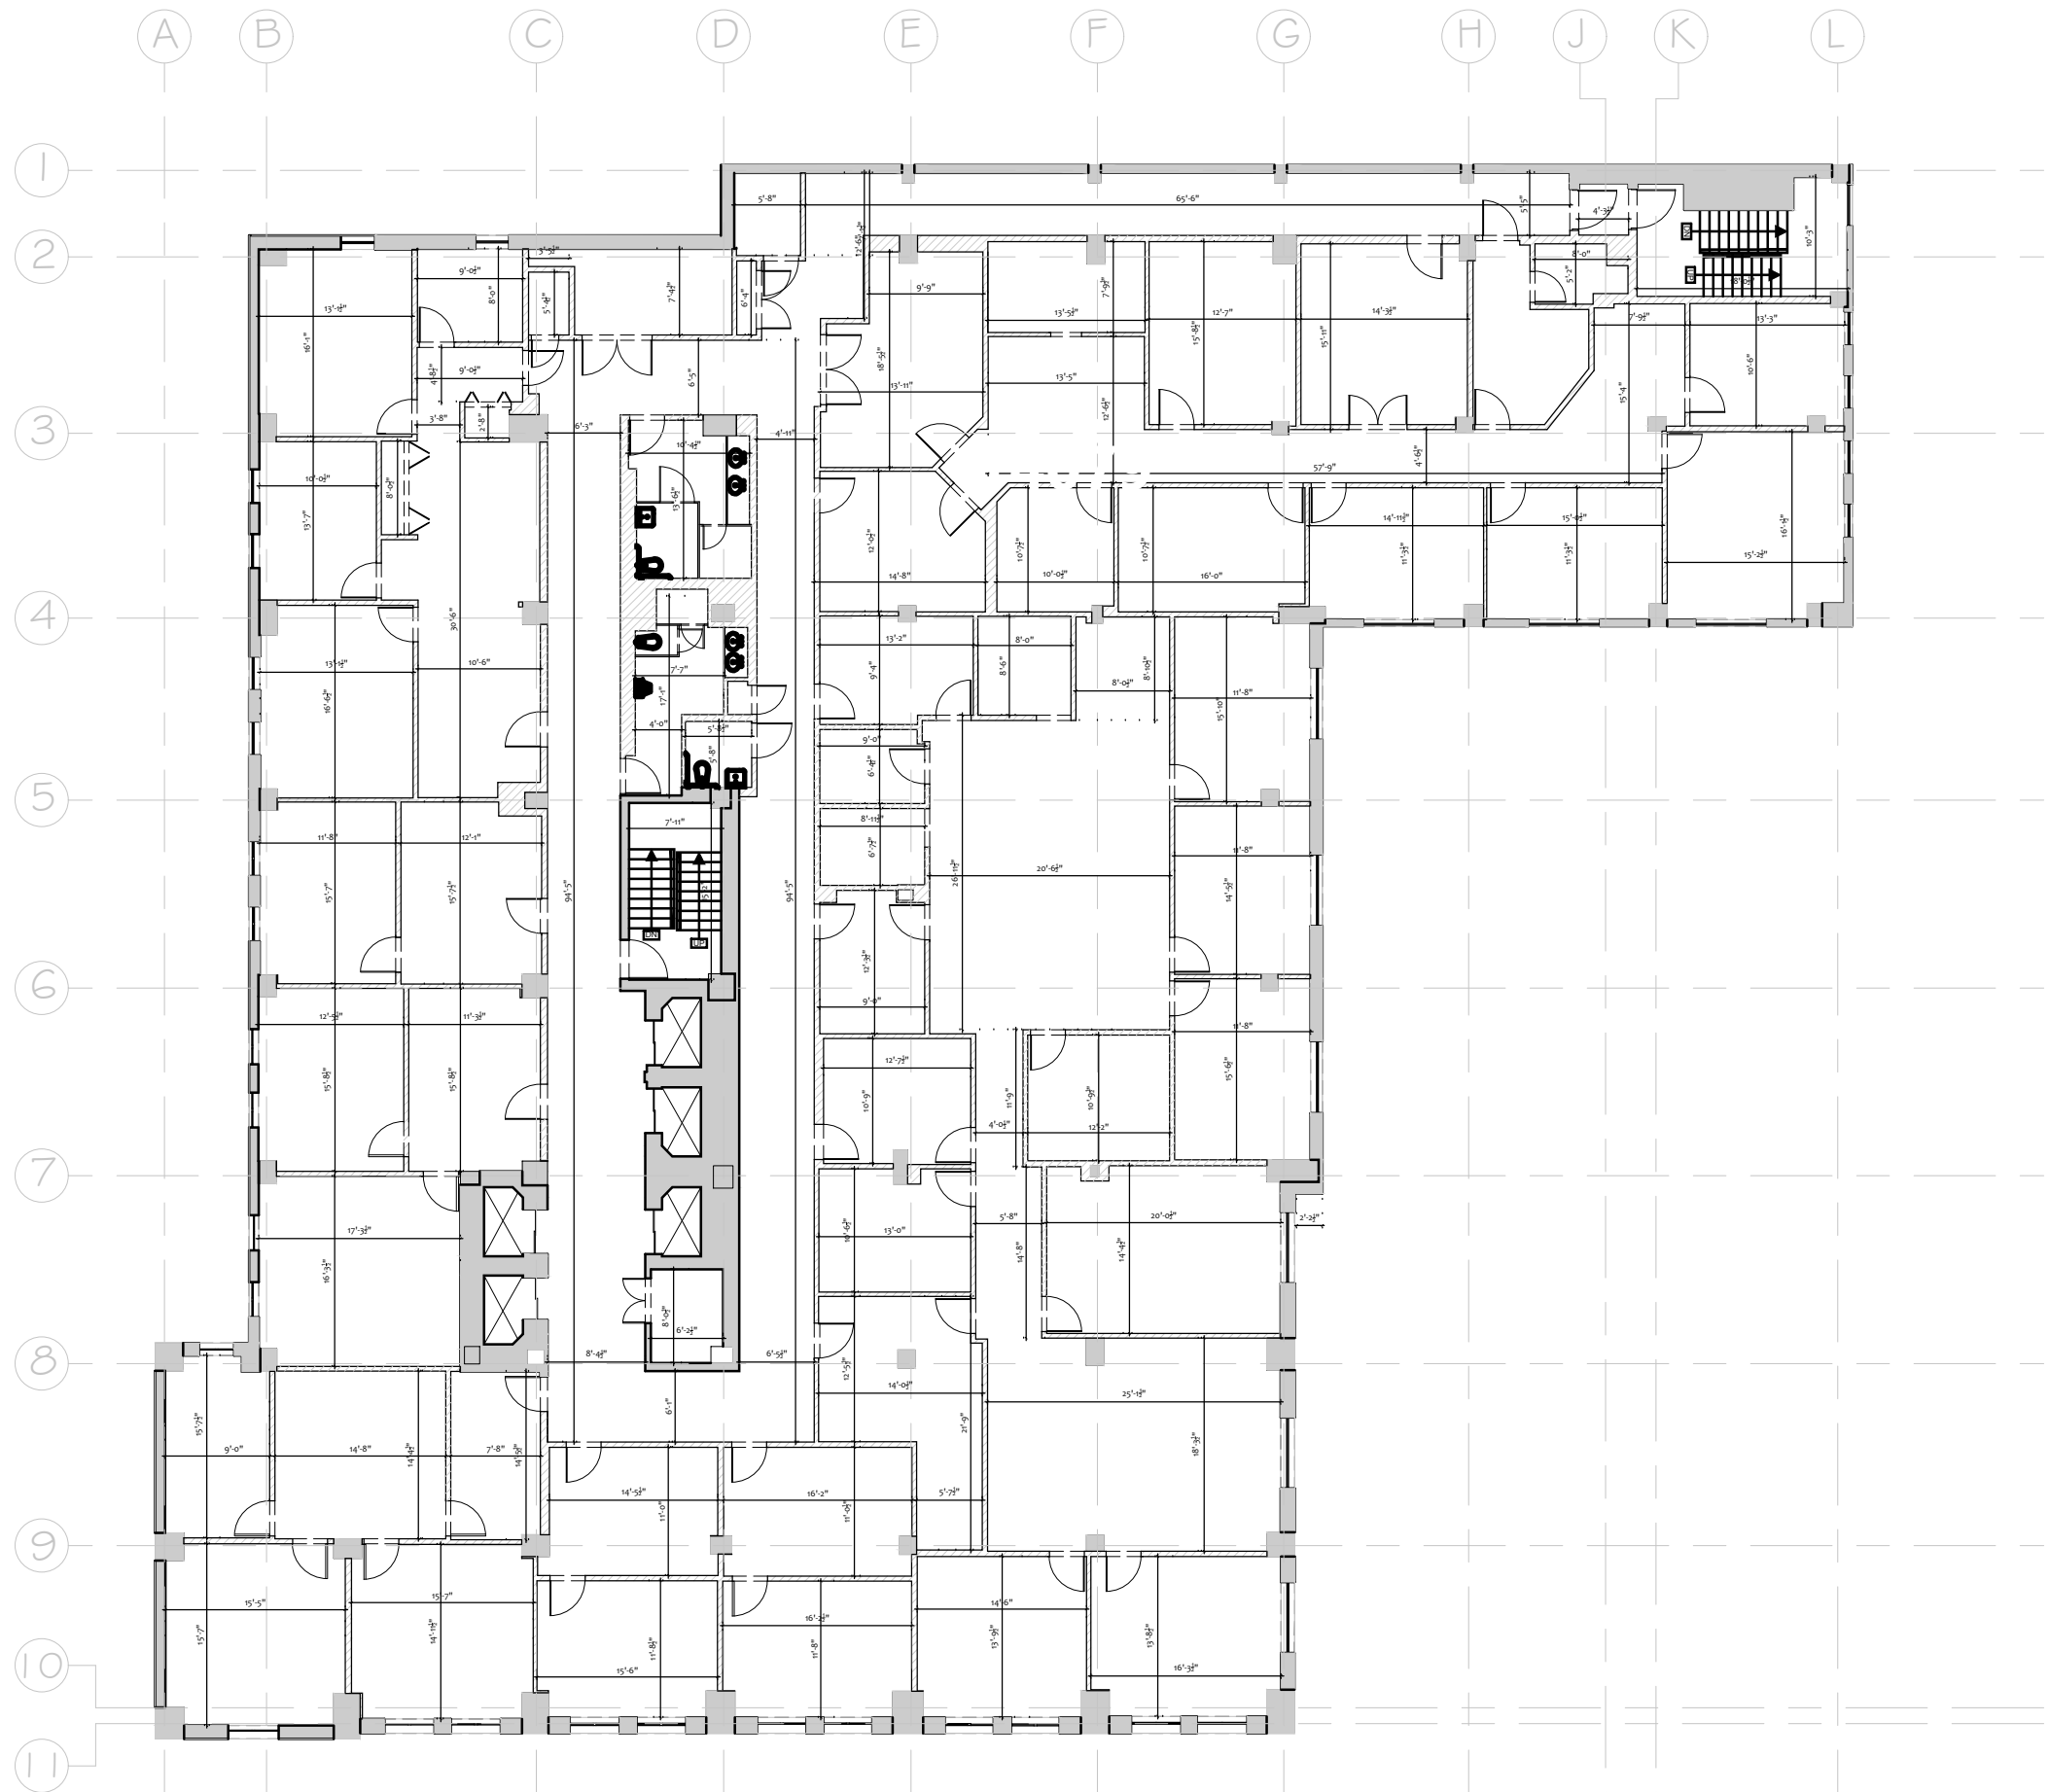

OWNER:

CLIENT:





Arktech Solutions LLC.  
10804 Inside Loop  
Orlando, FL 32825  
tel: (407) 205-7787  
[www.ArktechSolution.com](http://www.ArktechSolution.com)

|             |                         |
|-------------|-------------------------|
| FC NAME:    | ----                    |
| FCID:       | N/A                     |
| FC ADDRESS: | -----<br>-----<br>----- |

|                   |            |
|-------------------|------------|
| FIELD SURVEYOR:   | ----       |
| PROJECT DIRECTOR: | M.Vanegas  |
| CHECKED BY:       | -----      |
| DATE COMPLETED:   | 10/17/2022 |

|                 |        |
|-----------------|--------|
| PROJECT NUMBER: | 22916  |
| SHEET:          | A001.8 |
| DRAWING NUMBER: | 10     |
| OF:             | 36     |

|               |                |
|---------------|----------------|
| DRAWING NAME: | 6th Floor Plan |
|---------------|----------------|

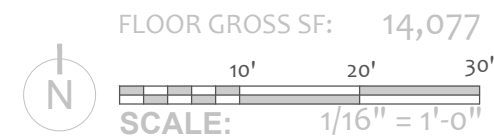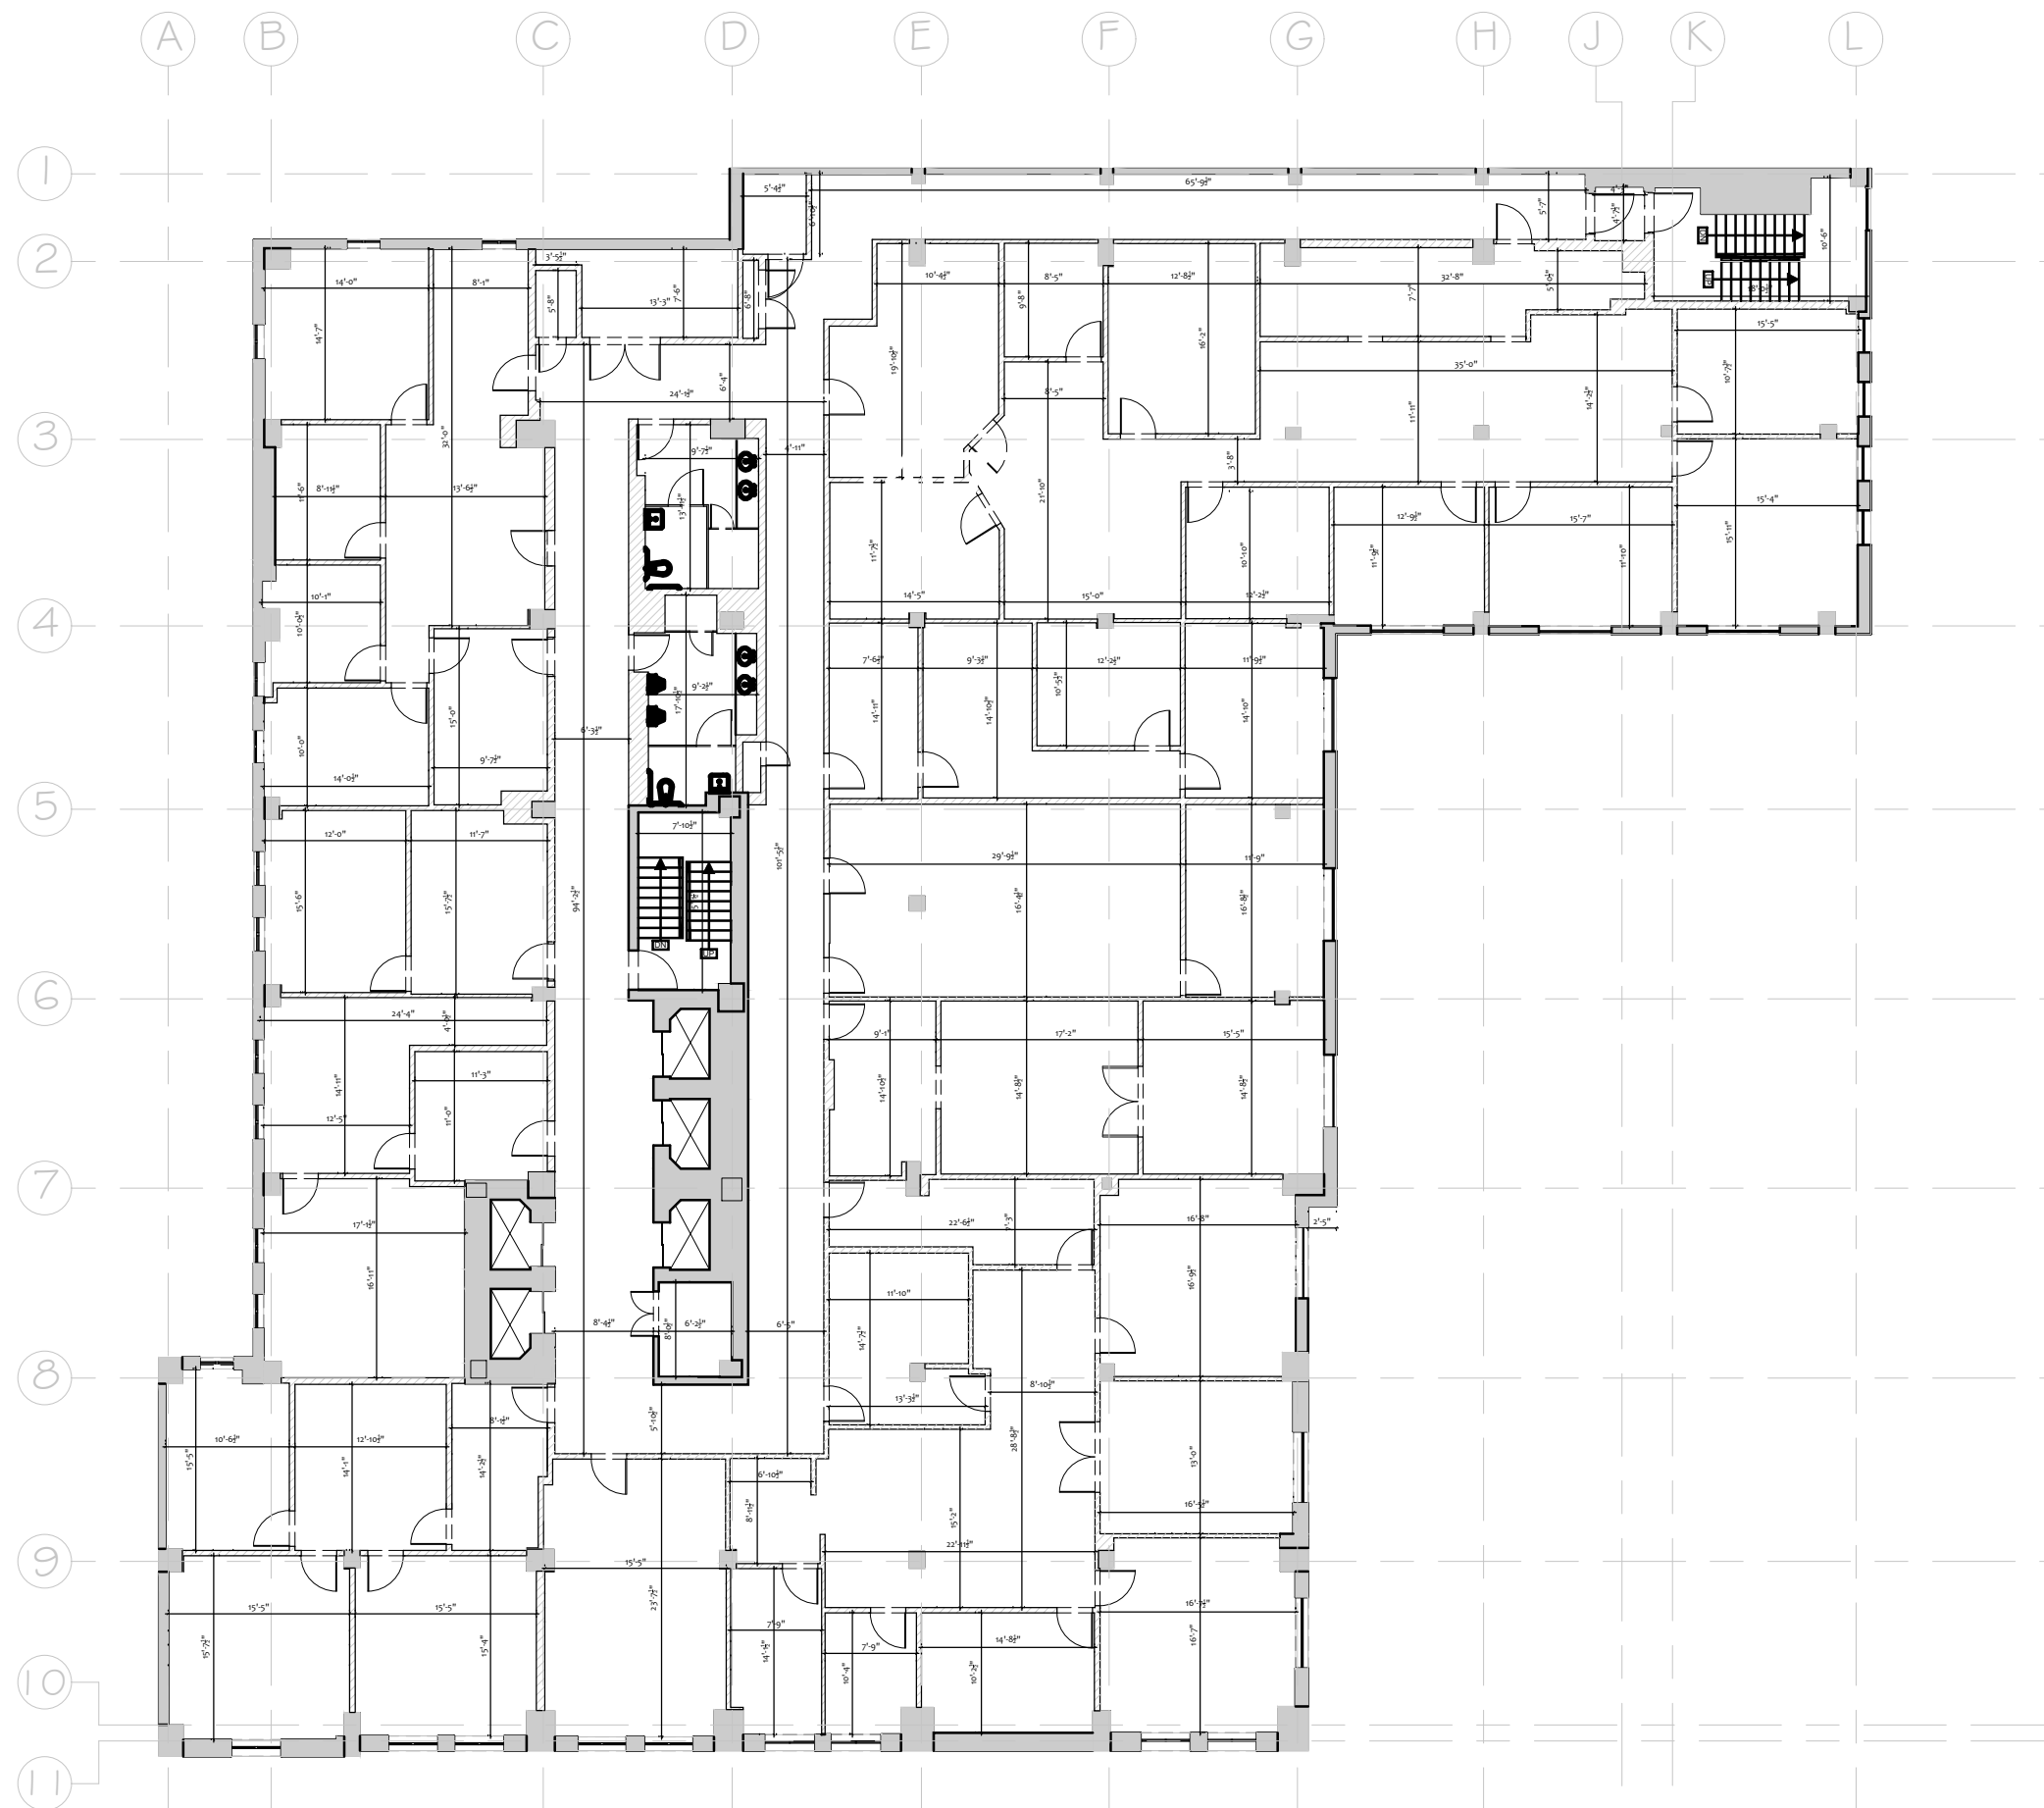

OWNER:

CLIENT:





Arktech Solutions LLC.  
10804 Inside Loop  
Orlando, FL 32825  
tel: (407) 205-7787  
[www.ArktechSolution.com](http://www.ArktechSolution.com)

|             |                         |
|-------------|-------------------------|
| FC NAME:    | ----                    |
| FCID:       | N/A                     |
| FC ADDRESS: | -----<br>-----<br>----- |

|                   |            |
|-------------------|------------|
| FIELD SURVEYOR:   | ----       |
| PROJECT DIRECTOR: | M.Vanegas  |
| CHECKED BY:       | -----      |
| DATE COMPLETED:   | 10/17/2022 |

|                 |        |
|-----------------|--------|
| PROJECT NUMBER: | 22916  |
| SHEET:          | A001.9 |
| DRAWING NUMBER: | 11     |
| OF:             | 36     |

|               |                |
|---------------|----------------|
| DRAWING NAME: | 7th Floor Plan |
|---------------|----------------|

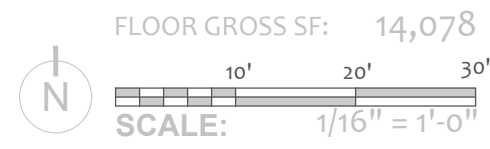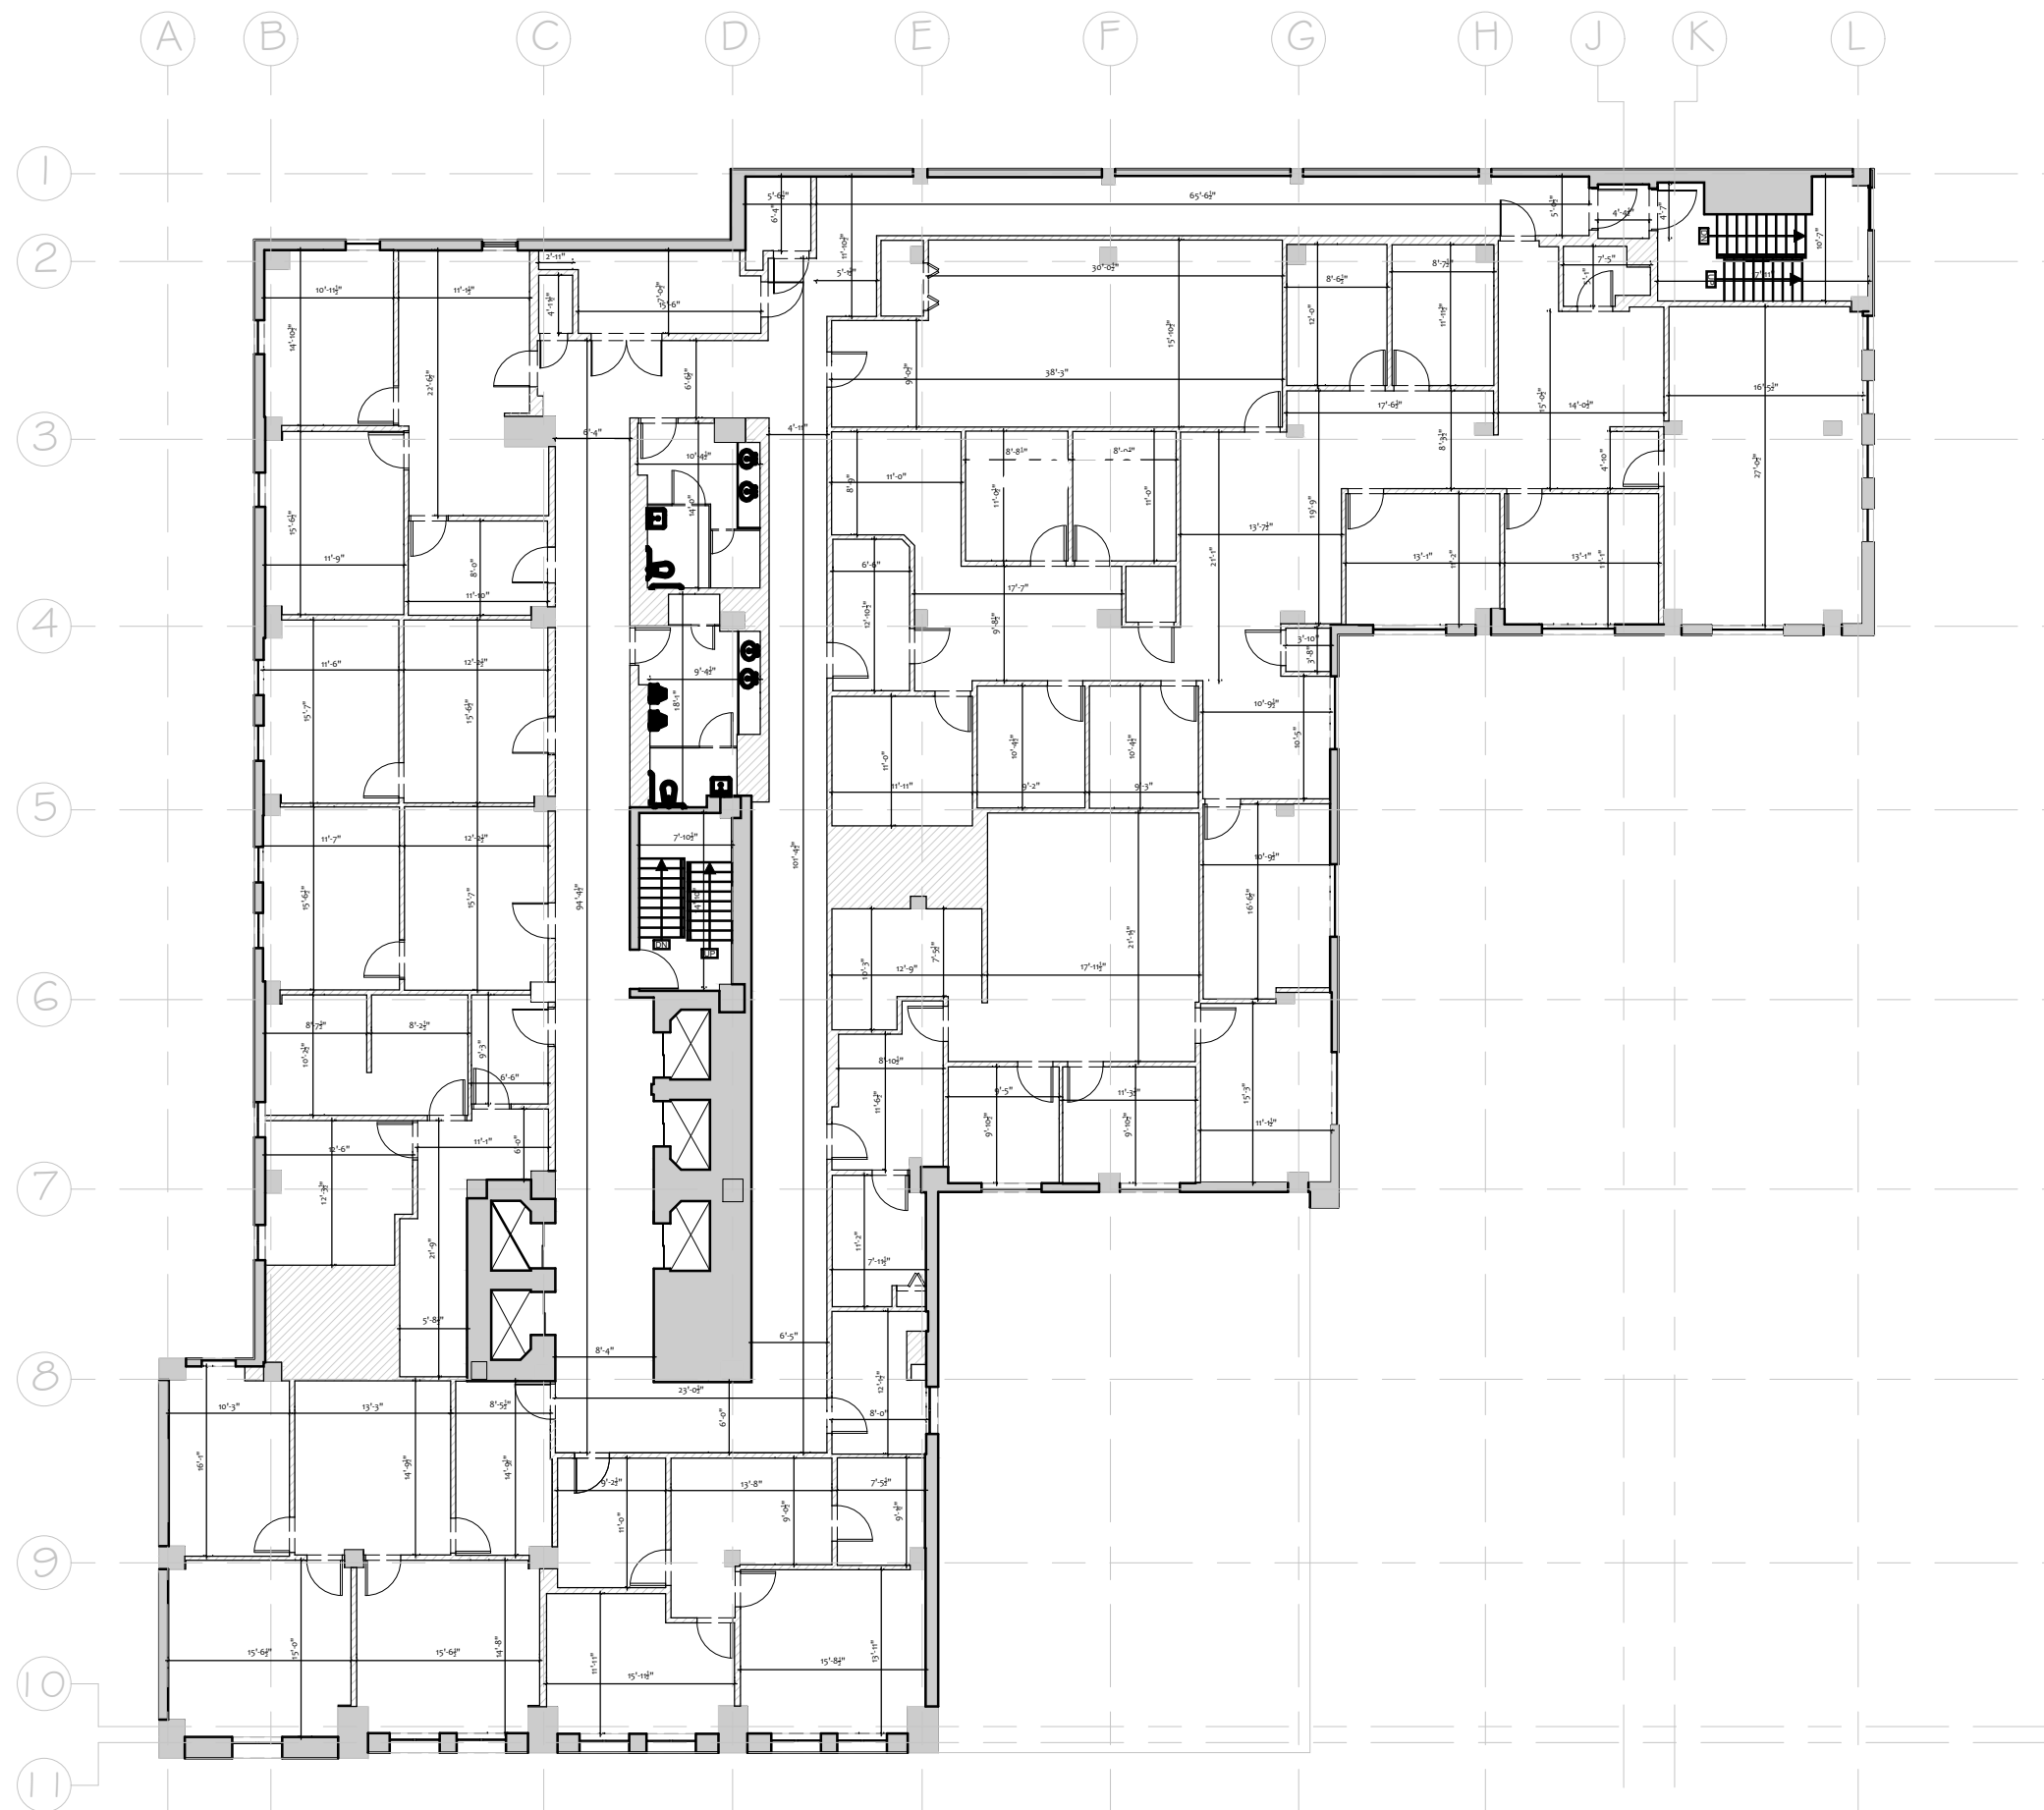

OWNER:

CLIENT:



Arktech Solutions LLC.  
10804 Inside Loop  
Orlando, FL 32825  
tel: (407) 205-7787  
[www.ArktechSolution.com](http://www.ArktechSolution.com)



|             |                         |
|-------------|-------------------------|
| FC NAME:    | ----                    |
| FCID:       | N/A                     |
| FC ADDRESS: | -----<br>-----<br>----- |

|                   |            |
|-------------------|------------|
| FIELD SURVEYOR:   | ----       |
| PROJECT DIRECTOR: | M.Vanegas  |
| CHECKED BY:       | -----      |
| DATE COMPLETED:   | 10/17/2022 |

|                 |         |
|-----------------|---------|
| PROJECT NUMBER: | 22916   |
| SHEET:          | A001.10 |
| DRAWING NUMBER: | 12      |
| OF:             | 36      |

|               |                |
|---------------|----------------|
| DRAWING NAME: | 8th Floor Plan |
|---------------|----------------|



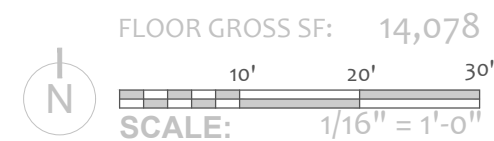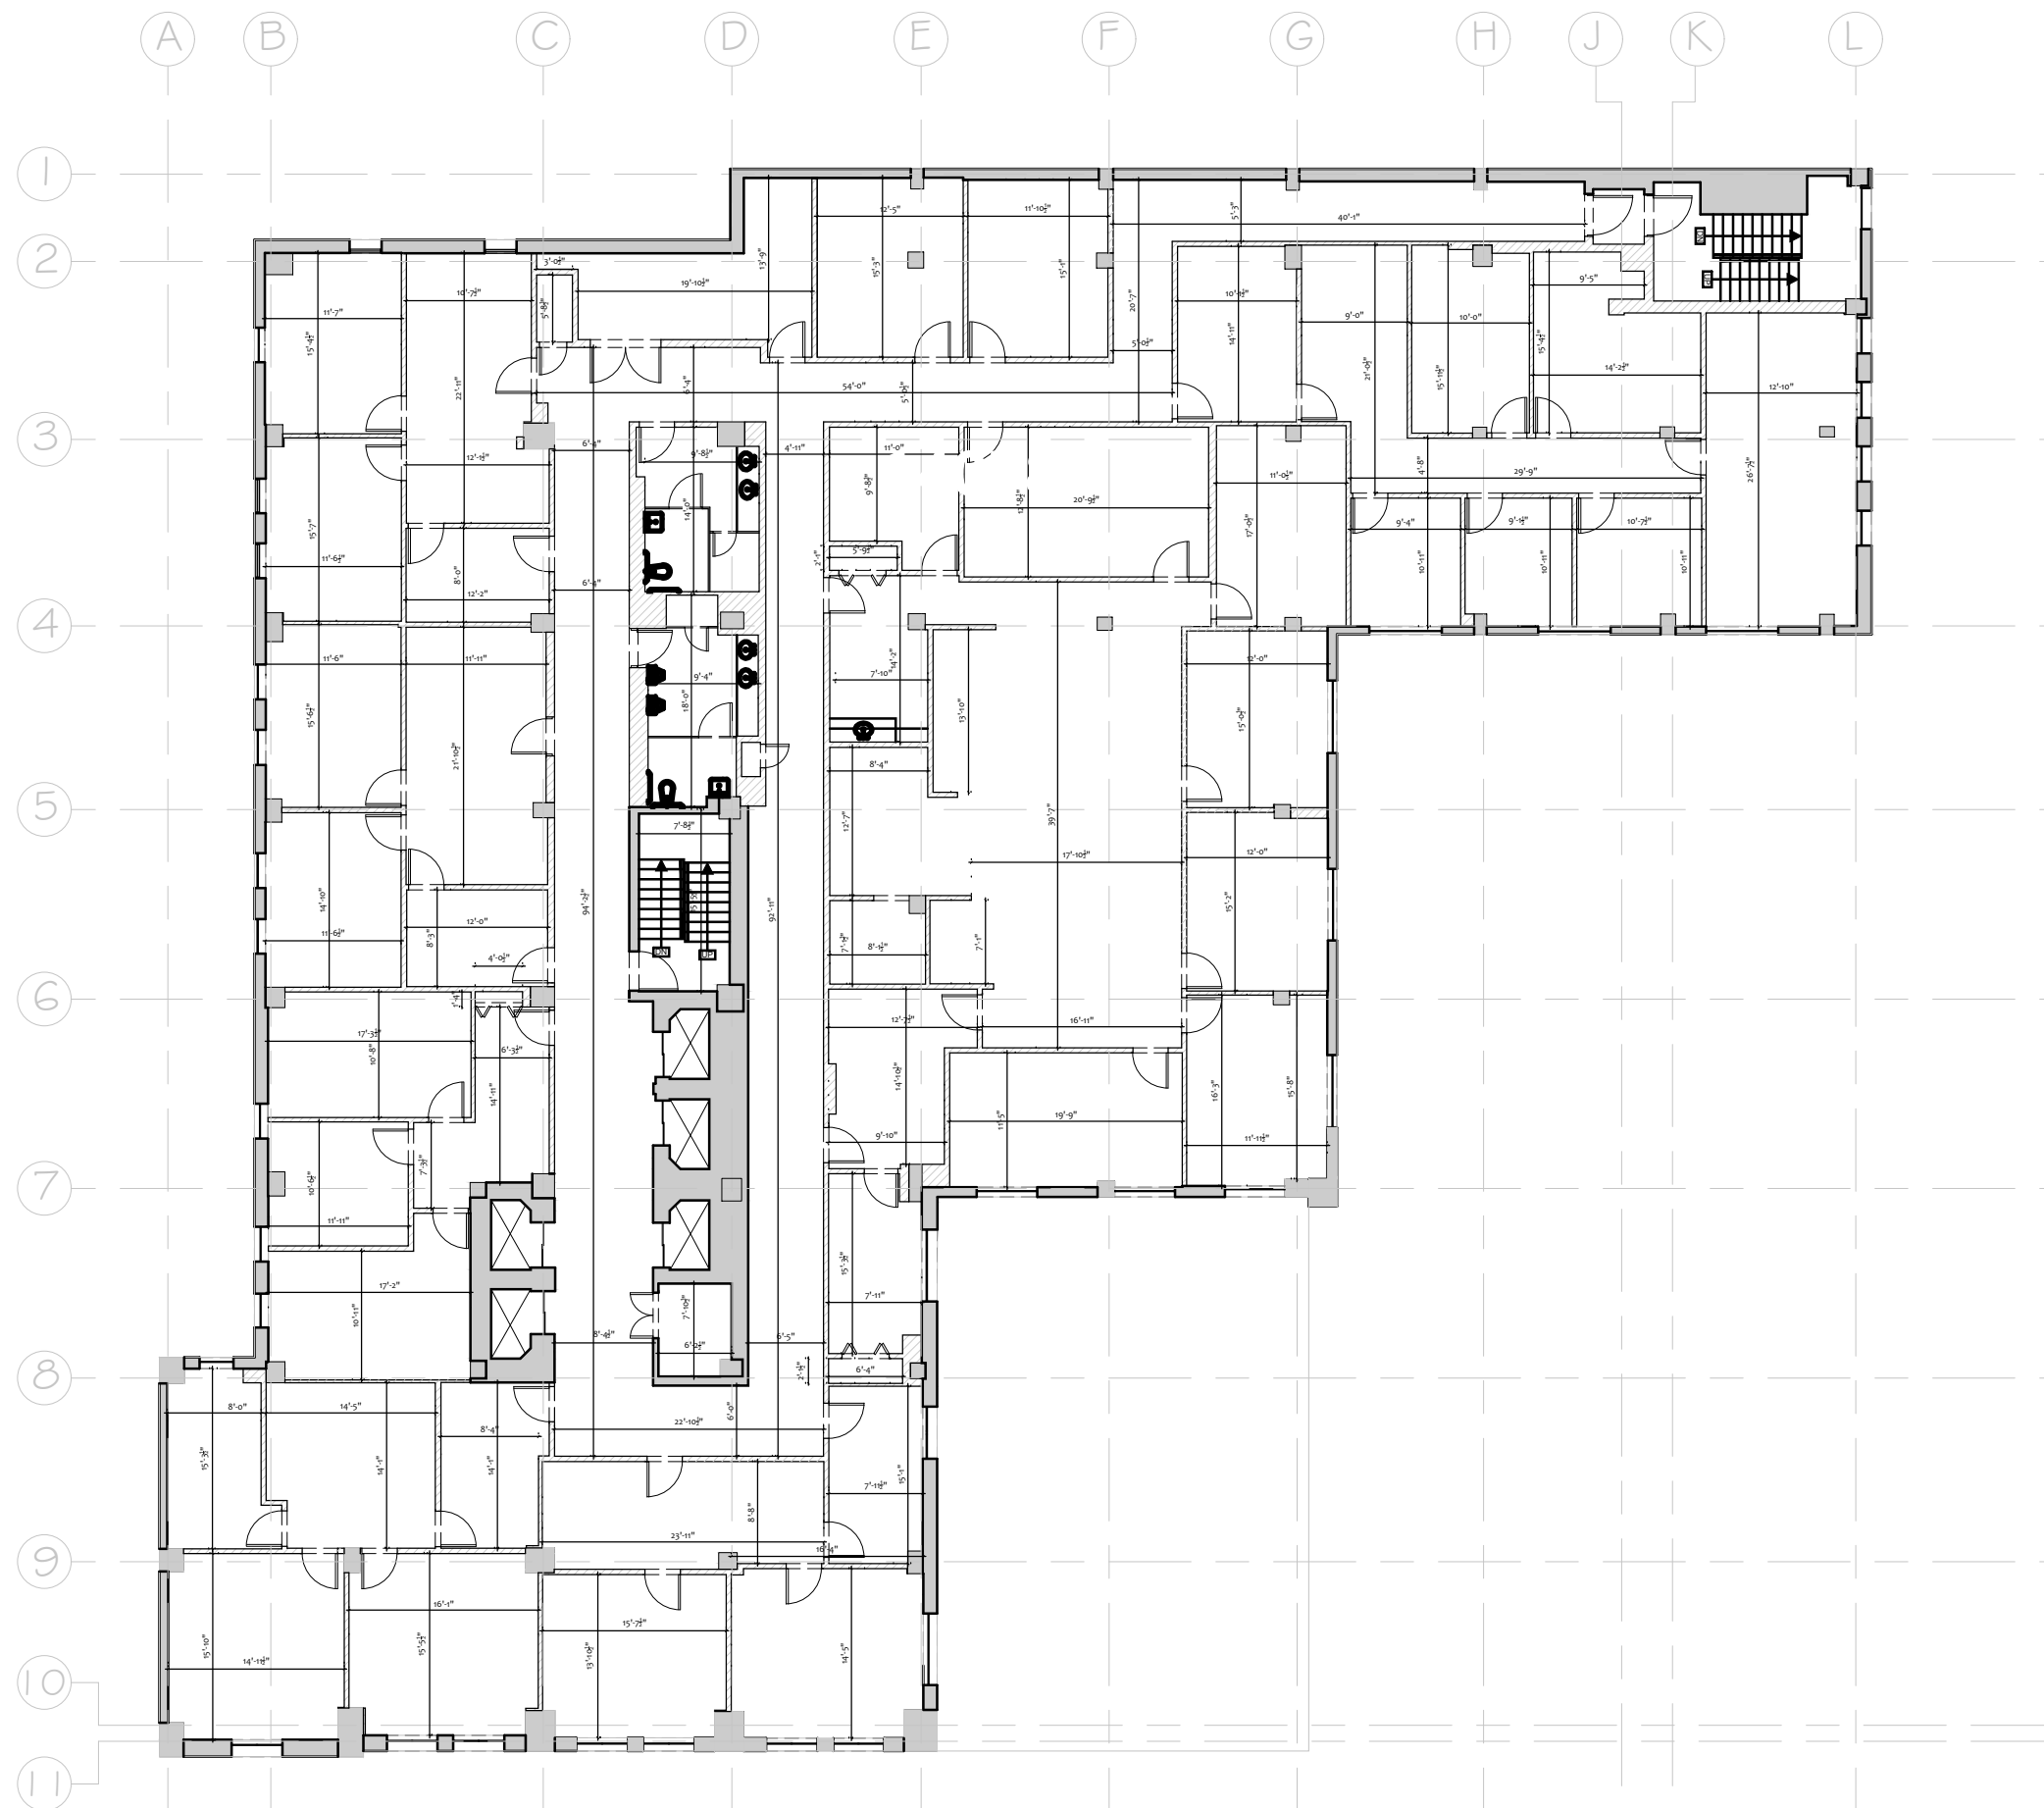

OWNER:

CLIENT:





Arktech Solutions LLC.  
10804 Inside Loop  
Orlando, FL 32825  
tel: (407) 205-7787  
[www.ArktechSolution.com](http://www.ArktechSolution.com)

|             |                         |
|-------------|-------------------------|
| FC NAME:    | ----                    |
| FCID:       | N/A                     |
| FC ADDRESS: | -----<br>-----<br>----- |

|                   |            |
|-------------------|------------|
| FIELD SURVEYOR:   | ----       |
| PROJECT DIRECTOR: | M.Vanegas  |
| CHECKED BY:       | -----      |
| DATE COMPLETED:   | 10/17/2022 |

|                 |         |
|-----------------|---------|
| PROJECT NUMBER: | 22916   |
| SHEET:          | A001.12 |
| DRAWING NUMBER: | 14      |
| OF:             | 36      |

|               |                 |
|---------------|-----------------|
| DRAWING NAME: | 10th Floor Plan |
|---------------|-----------------|

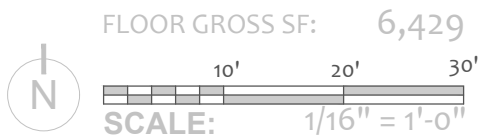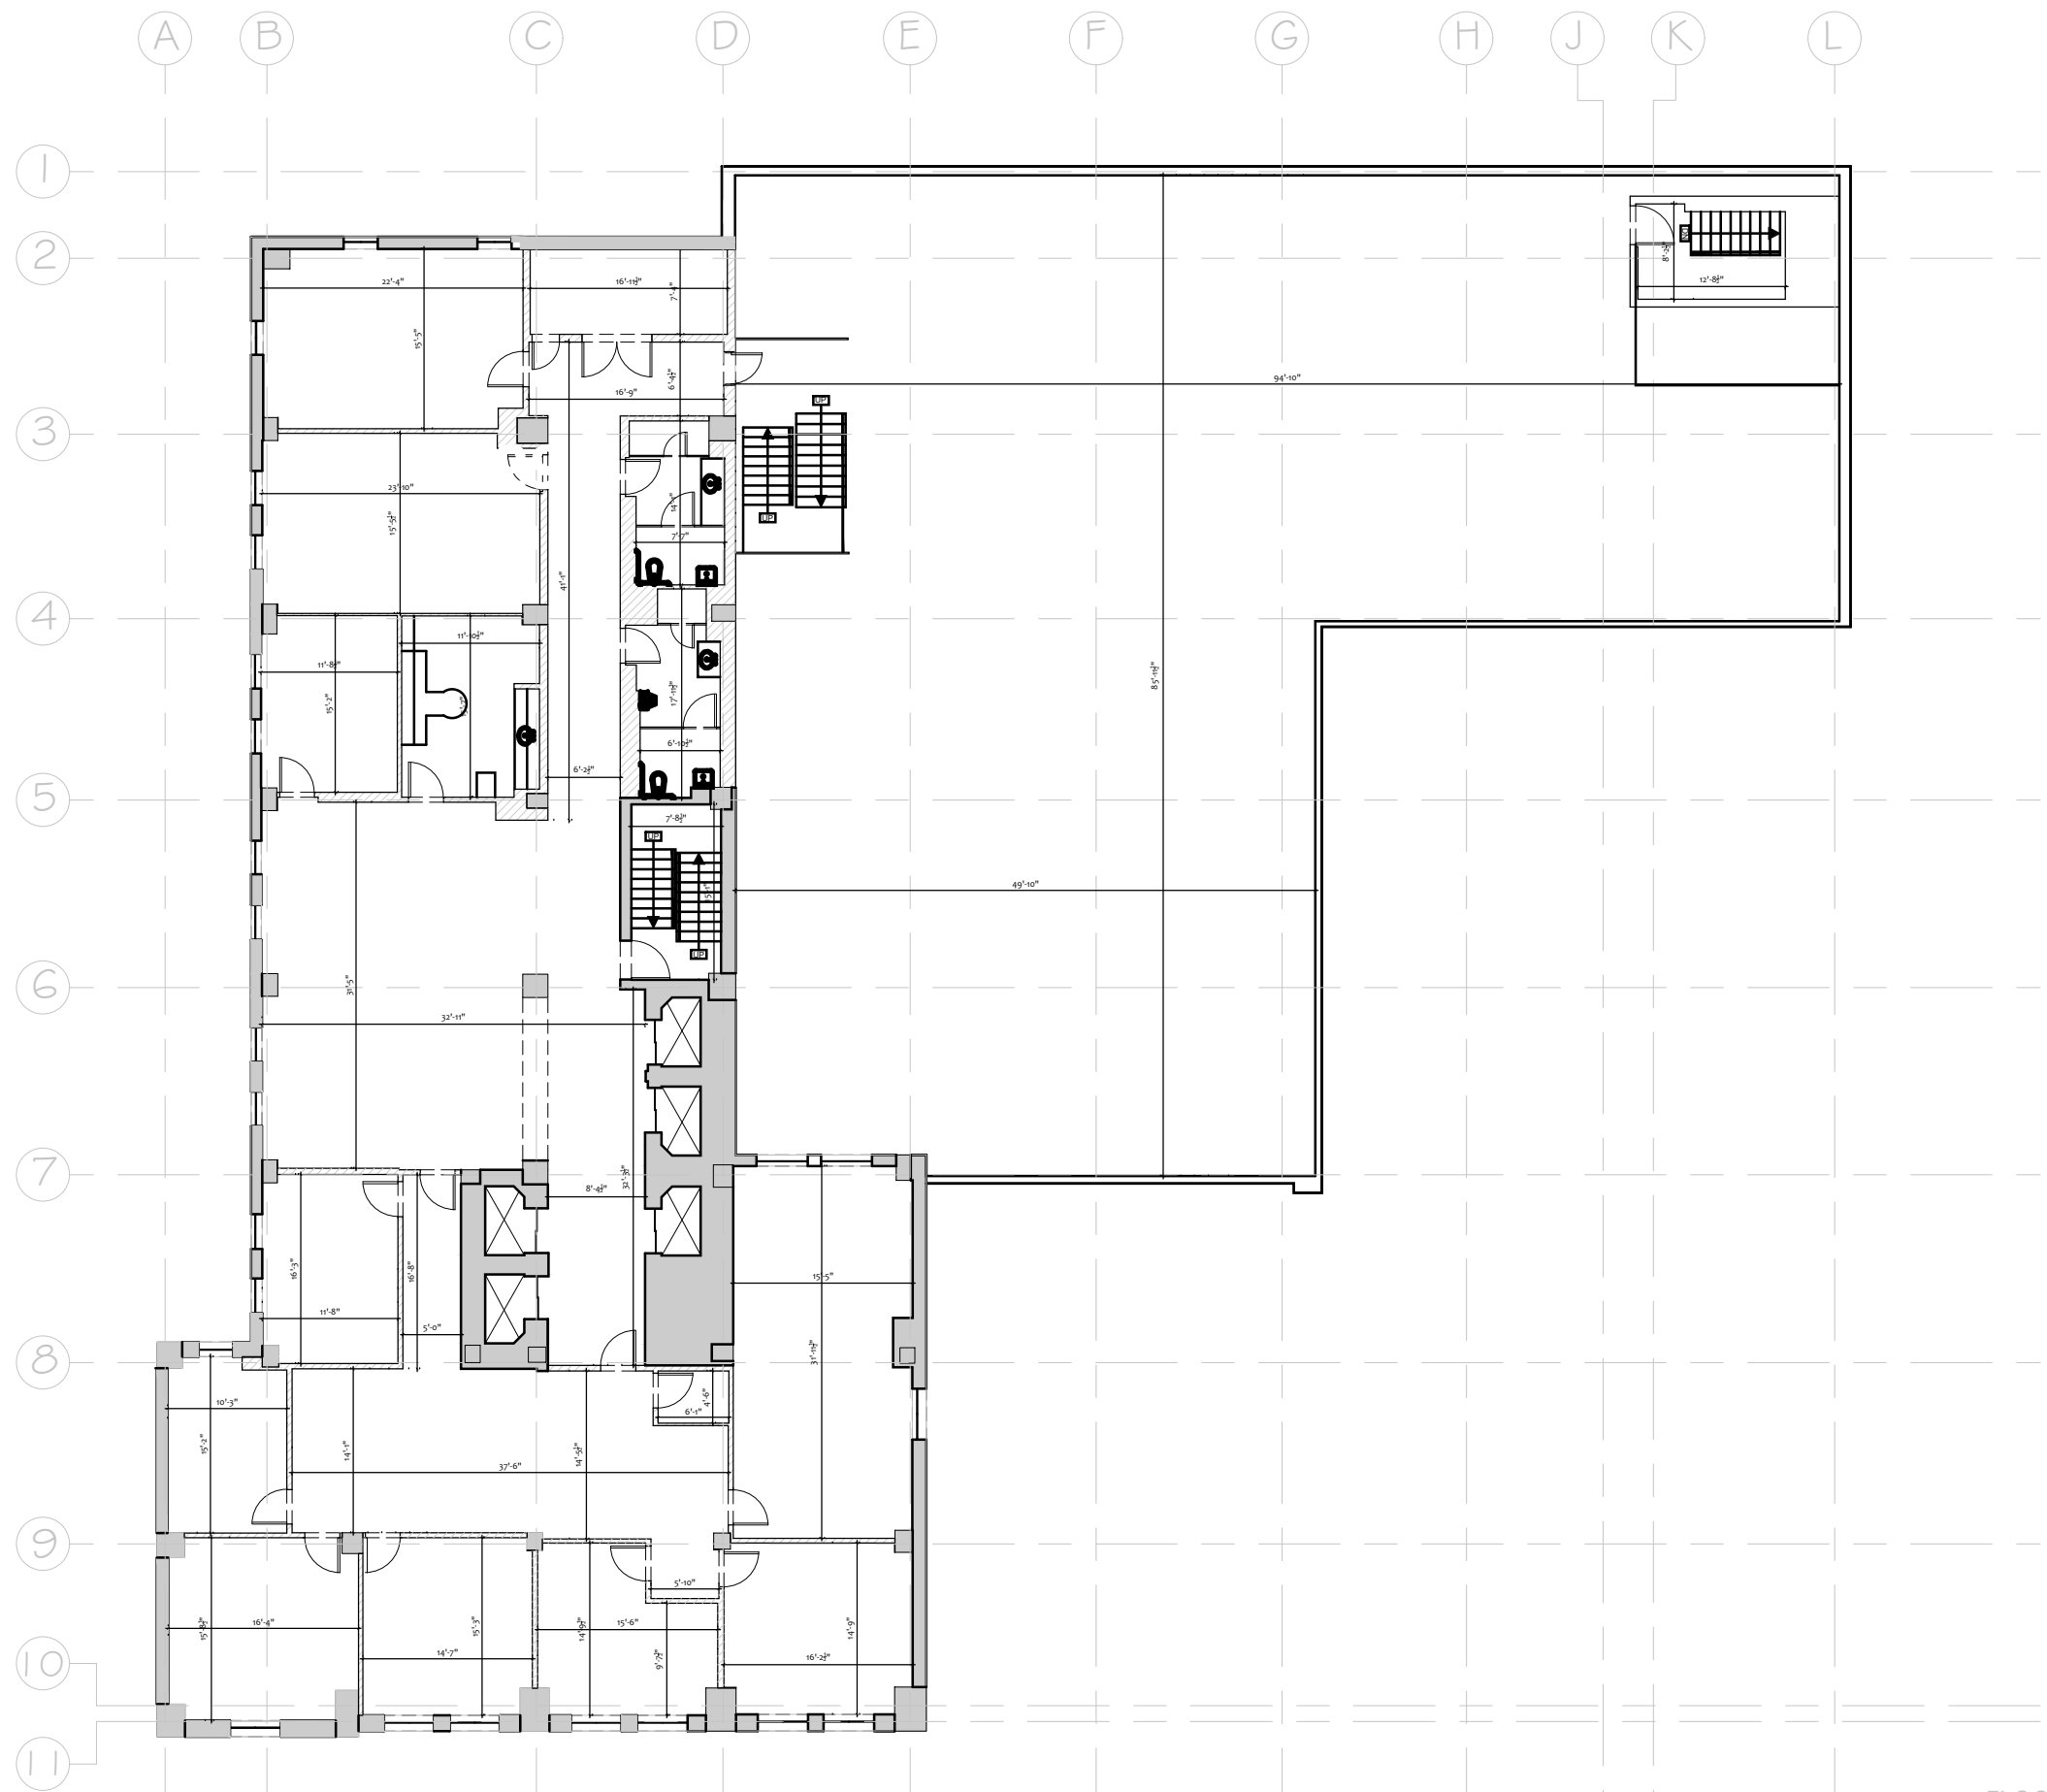

OWNER:

CLIENT:




Arktech Solutions LLC.  
10804 Inside Loop  
Orlando, FL 32825  
tel: (407) 205-7787  
[www.ArktechSolution.com](http://www.ArktechSolution.com)

|             |                         |
|-------------|-------------------------|
| FC NAME:    | ----                    |
| FCID:       | N/A                     |
| FC ADDRESS: | -----<br>-----<br>----- |

|                   |            |
|-------------------|------------|
| FIELD SURVEYOR:   | ----       |
| PROJECT DIRECTOR: | M.Vanegas  |
| CHECKED BY:       | ----       |
| DATE COMPLETED:   | 10/17/2022 |

|                 |         |
|-----------------|---------|
| PROJECT NUMBER: | 22916   |
| SHEET:          | A001.13 |
| DRAWING NUMBER: | 15      |
| OF:             | 36      |

|               |                 |
|---------------|-----------------|
| DRAWING NAME: | 11th Floor Plan |
|---------------|-----------------|

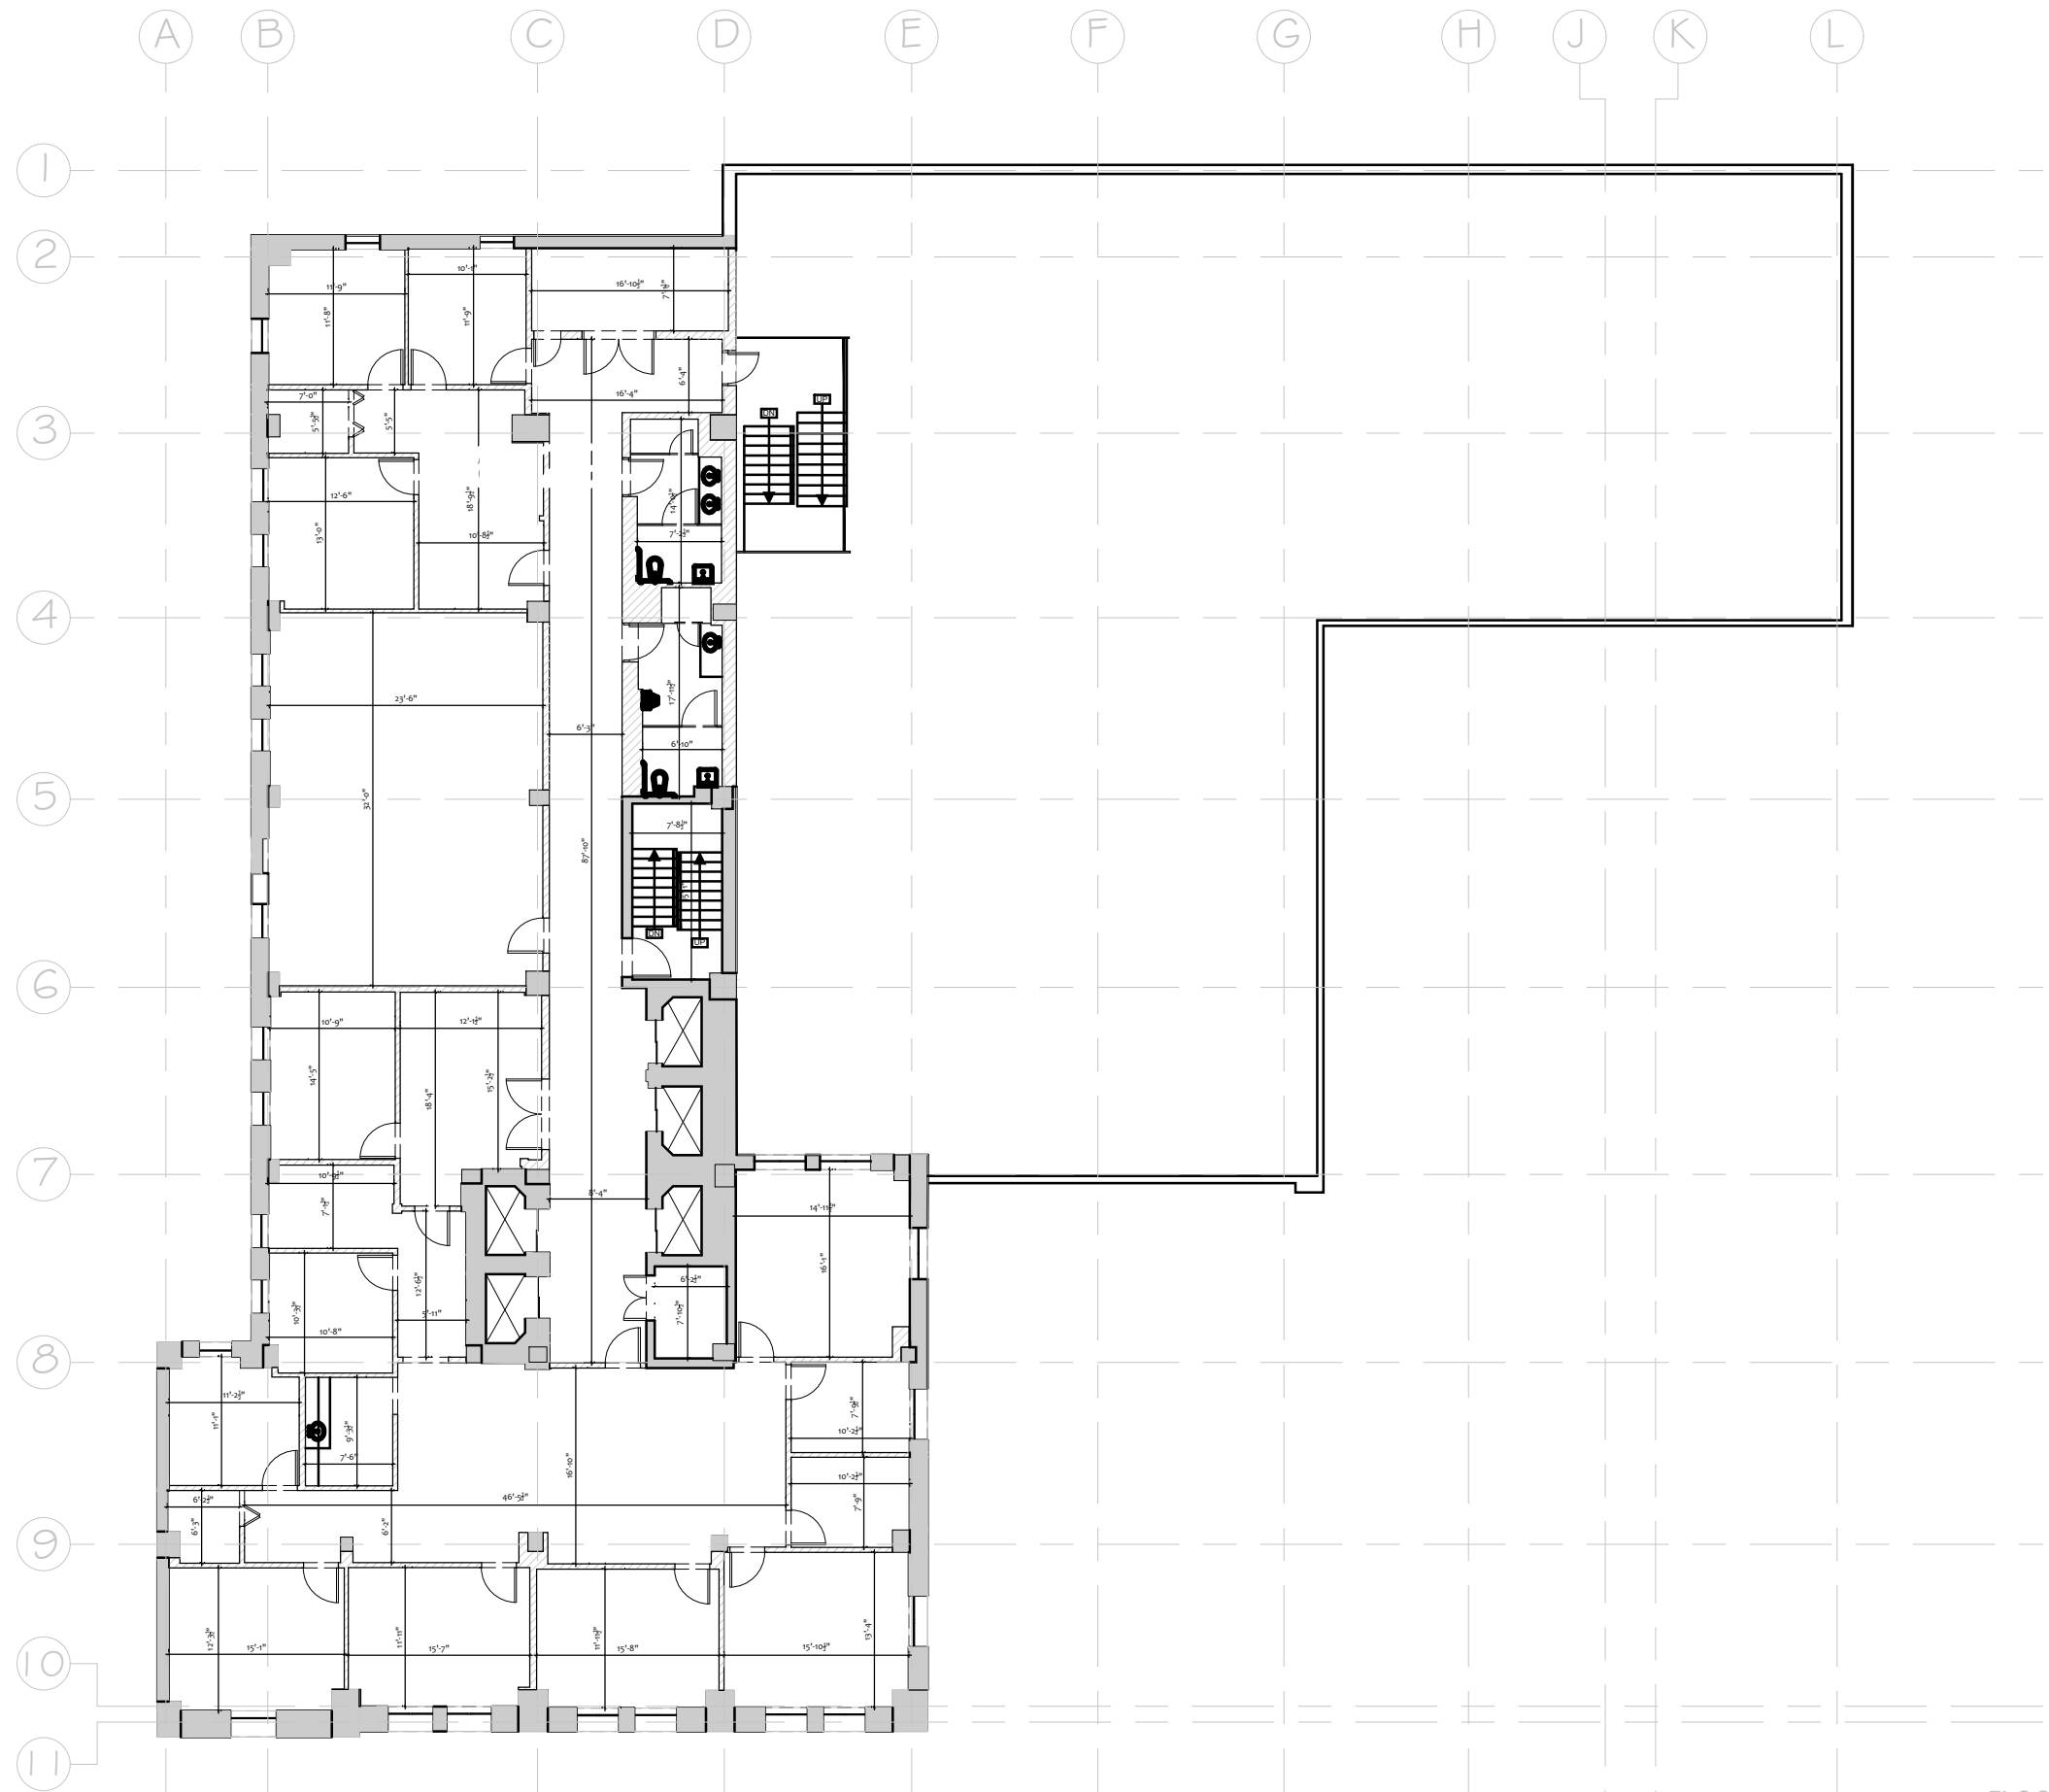

FLOOR GROSS SF: 6,429  
SCALE: 1/16" = 1'-0"

OWNER:

CLIENT:





Arktech Solutions LLC.  
10804 Inside Loop  
Orlando, FL 32825  
tel: (407) 205-7787  
[www.ArktechSolution.com](http://www.ArktechSolution.com)

|             |                         |
|-------------|-------------------------|
| FC NAME:    | ----                    |
| FCID:       | N/A                     |
| FC ADDRESS: | -----<br>-----<br>----- |

|                   |            |
|-------------------|------------|
| FIELD SURVEYOR:   | ----       |
| PROJECT DIRECTOR: | M.Vanegas  |
| CHECKED BY:       | ----       |
| DATE COMPLETED:   | 10/17/2022 |

|                 |         |
|-----------------|---------|
| PROJECT NUMBER: | 22916   |
| SHEET:          | A001.14 |
| DRAWING NUMBER: | 16      |
| OF:             | 36      |

|               |                 |
|---------------|-----------------|
| DRAWING NAME: | 12th Floor Plan |
|---------------|-----------------|

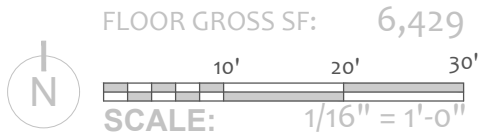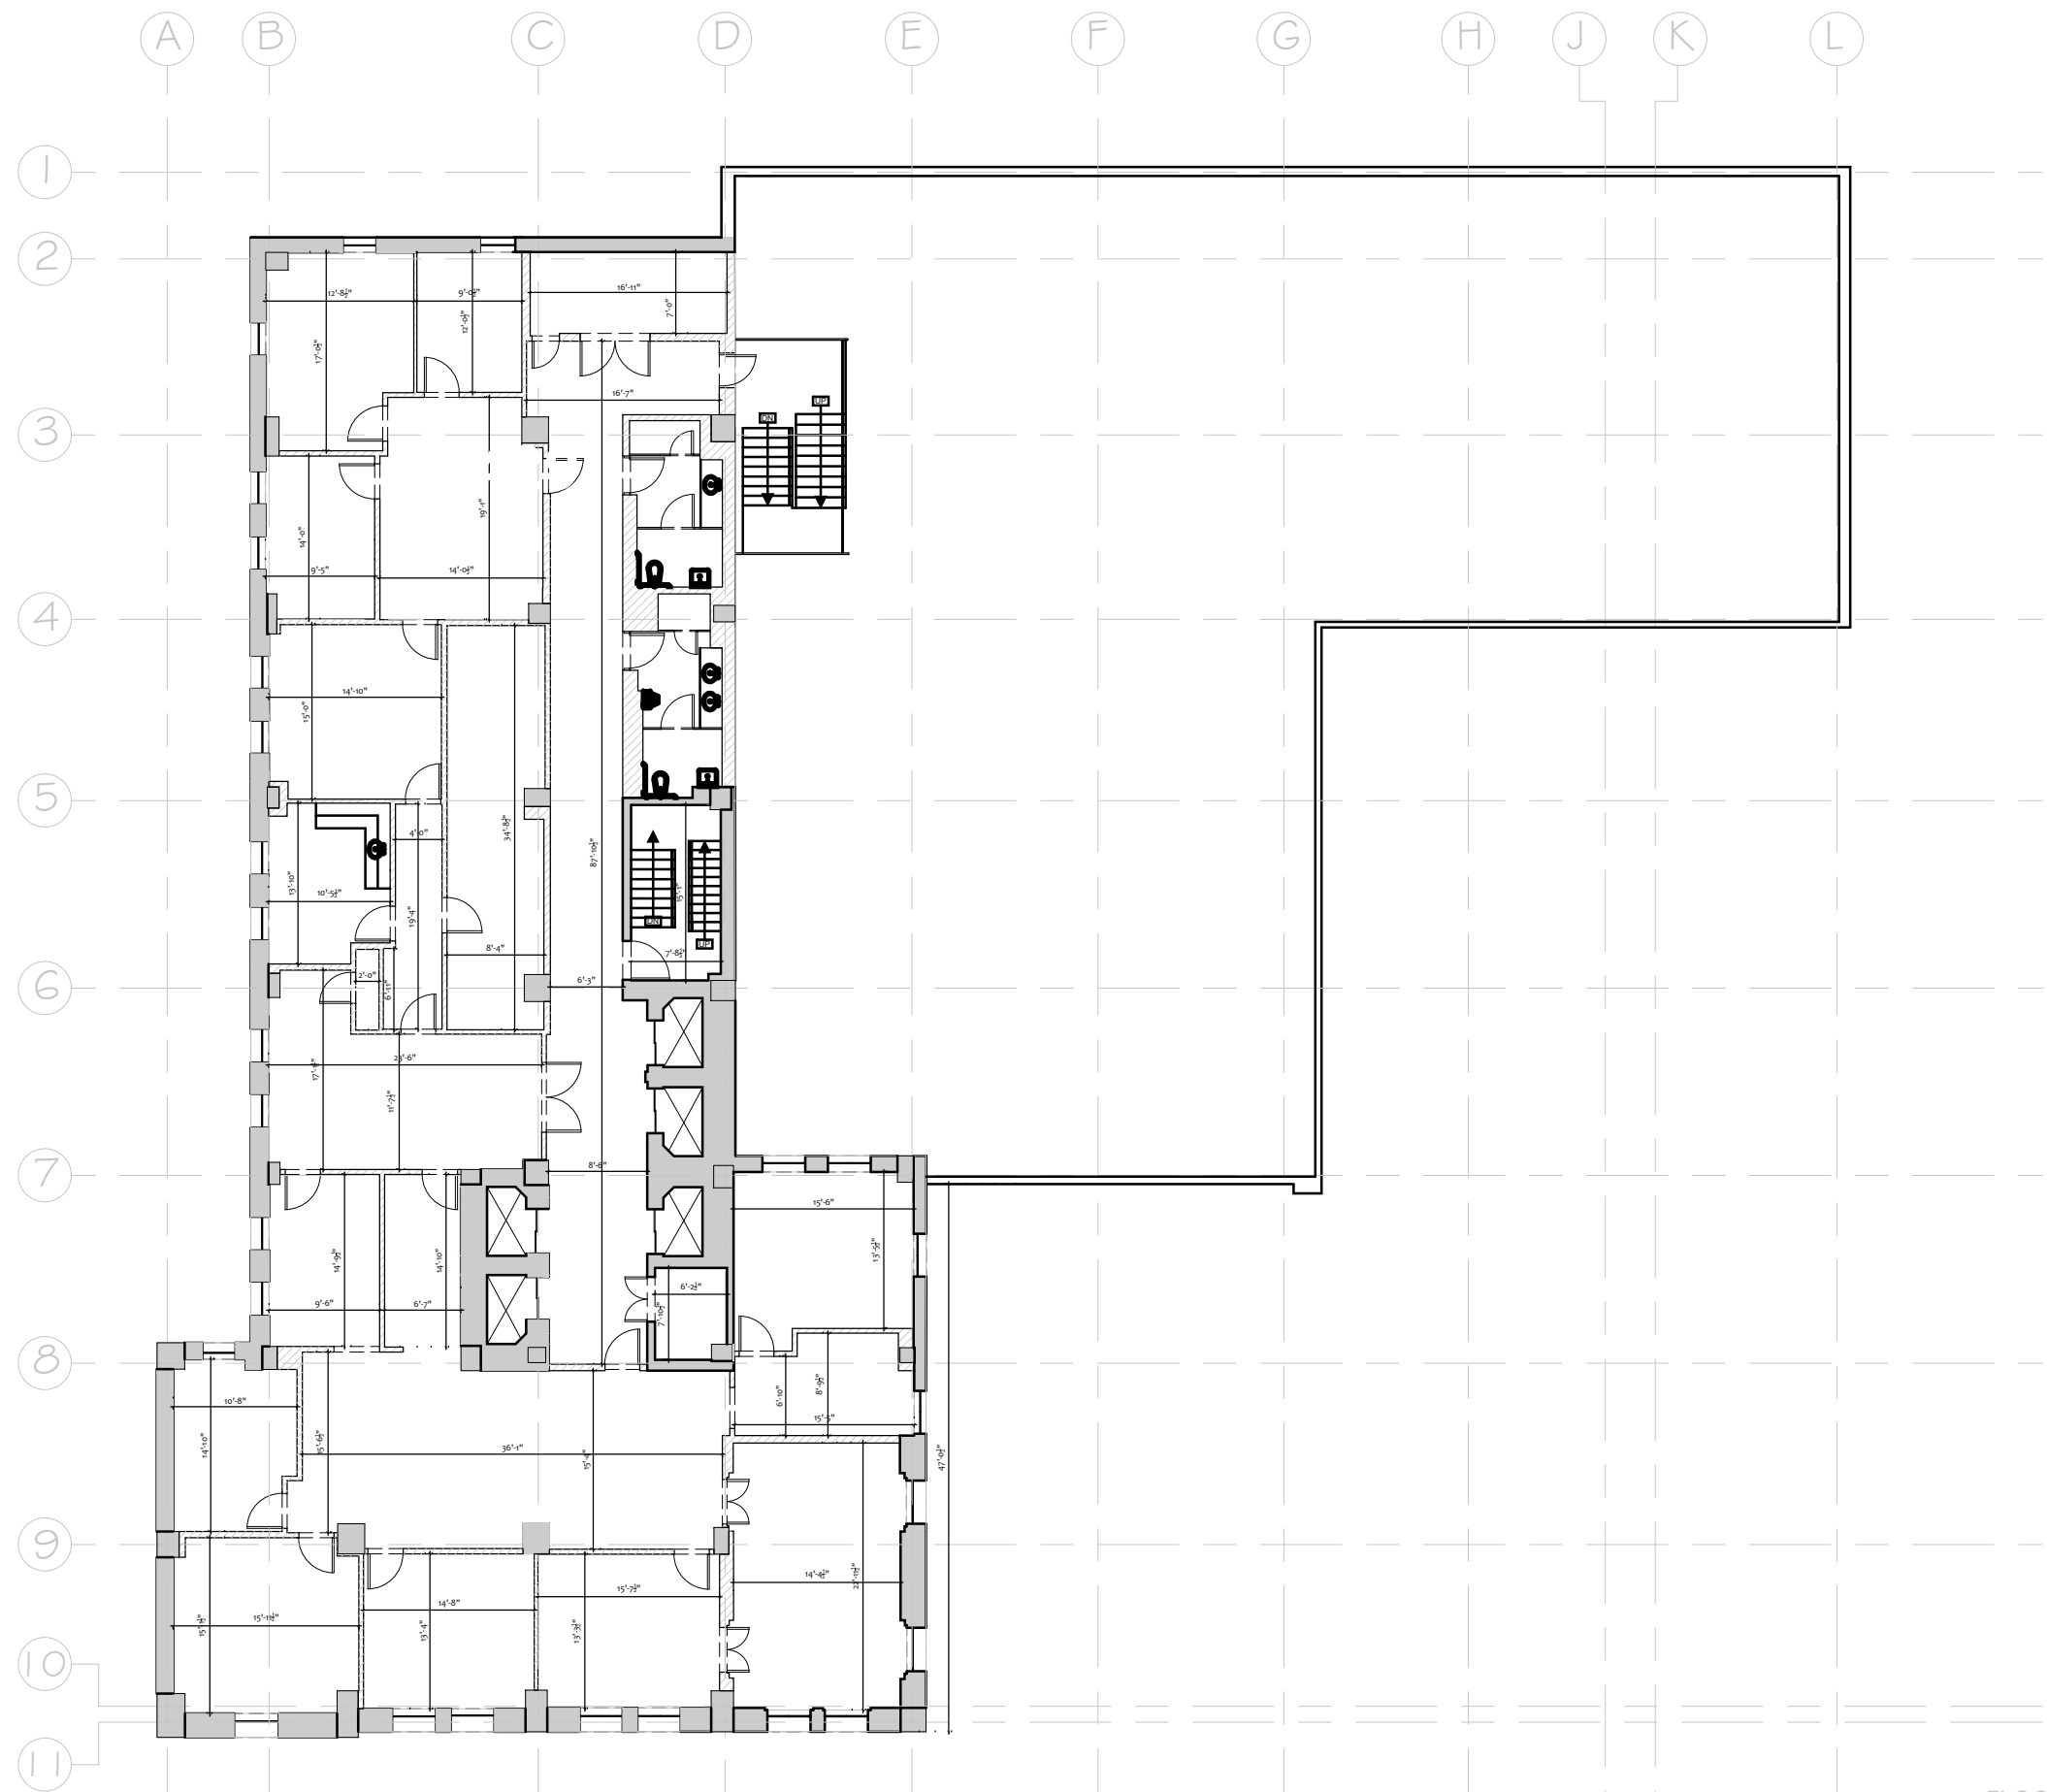

OWNER:

CLIENT:




Arktech Solutions LLC.  
10804 Inside Loop  
Orlando, FL 32825  
tel: (407) 205-7787  
[www.ArktechSolution.com](http://www.ArktechSolution.com)

|             |                         |
|-------------|-------------------------|
| FC NAME:    | ----                    |
| FCID:       | N/A                     |
| FC ADDRESS: | -----<br>-----<br>----- |

|                   |            |
|-------------------|------------|
| FIELD SURVEYOR:   | ----       |
| PROJECT DIRECTOR: | M.Vanegas  |
| CHECKED BY:       | ----       |
| DATE COMPLETED:   | 10/17/2022 |




|                 |         |
|-----------------|---------|
| PROJECT NUMBER: | 22916   |
| SHEET:          | A001.15 |
| DRAWING NUMBER: | 17      |
| OF:             | 36      |

|               |                 |
|---------------|-----------------|
| DRAWING NAME: | 14th Floor Plan |
|---------------|-----------------|

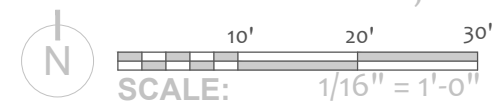

DRAWING NAME:

Roof Plan

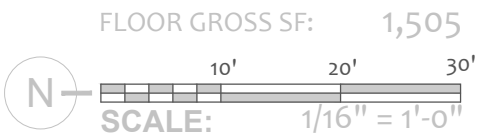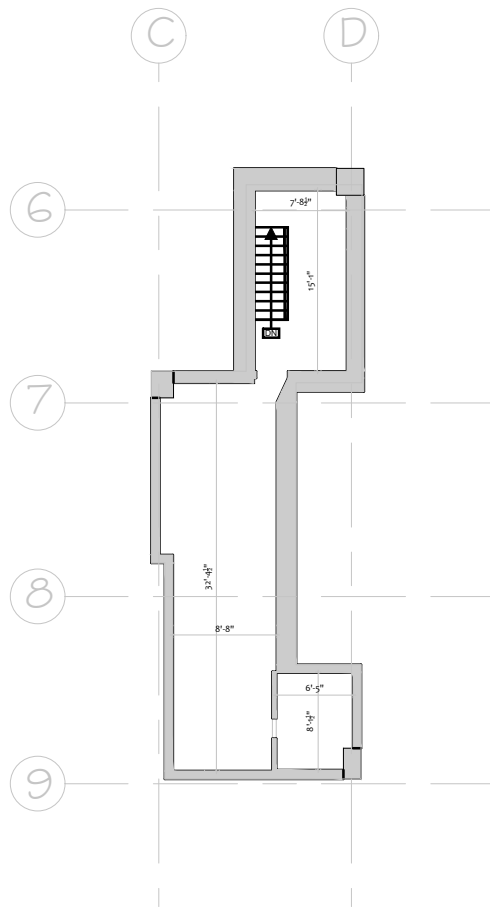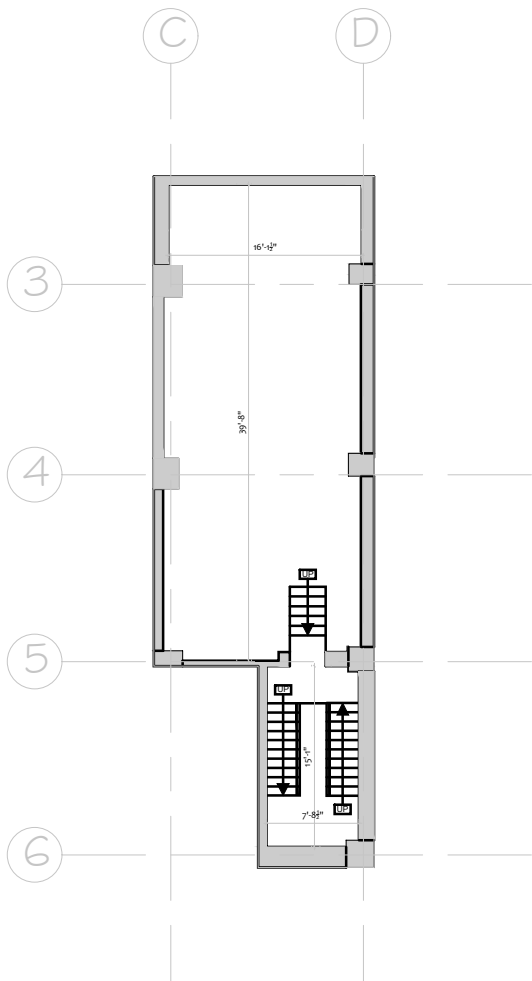

OWNER:

CLIENT:




Arktech Solutions LLC.  
10804 Inside Loop  
Orlando, FL 32825  
tel: (407) 205-7787  
[www.ArktechSolution.com](http://www.ArktechSolution.com)

|             |                         |
|-------------|-------------------------|
| FC NAME:    | ----                    |
| FCID:       | N/A                     |
| FC ADDRESS: | -----<br>-----<br>----- |


|                   |            |
|-------------------|------------|
| FIELD SURVEYOR:   | ----       |
| PROJECT DIRECTOR: | M.Vanegas  |
| CHECKED BY:       | -----      |
| DATE COMPLETED:   | 10/17/2022 |

|                 |        |
|-----------------|--------|
| PROJECT NUMBER: | 22916  |
| SHEET:          | A004.1 |
| DRAWING NUMBER: | 34     |
| OF:             | 36     |


|               |                          |
|---------------|--------------------------|
| DRAWING NAME: | Mechanical Fl. Core Plan |
|---------------|--------------------------|

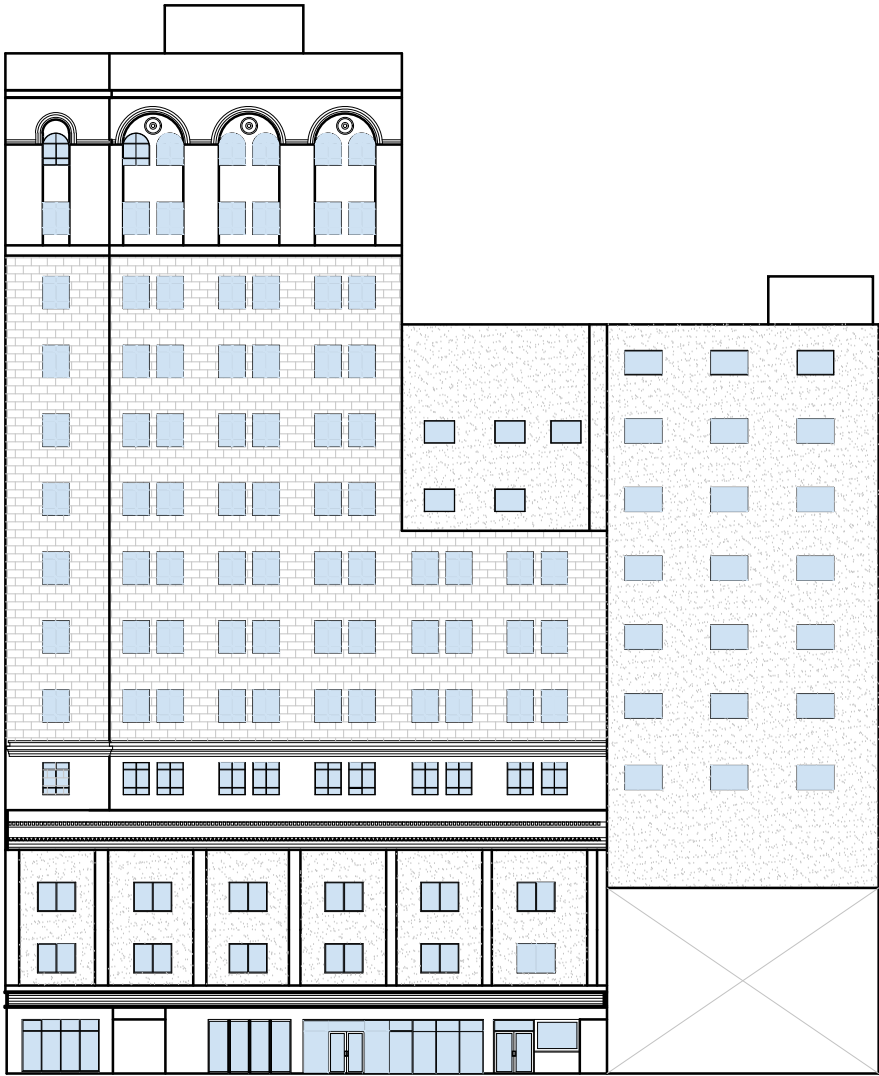

① SOUTH ELEVATION

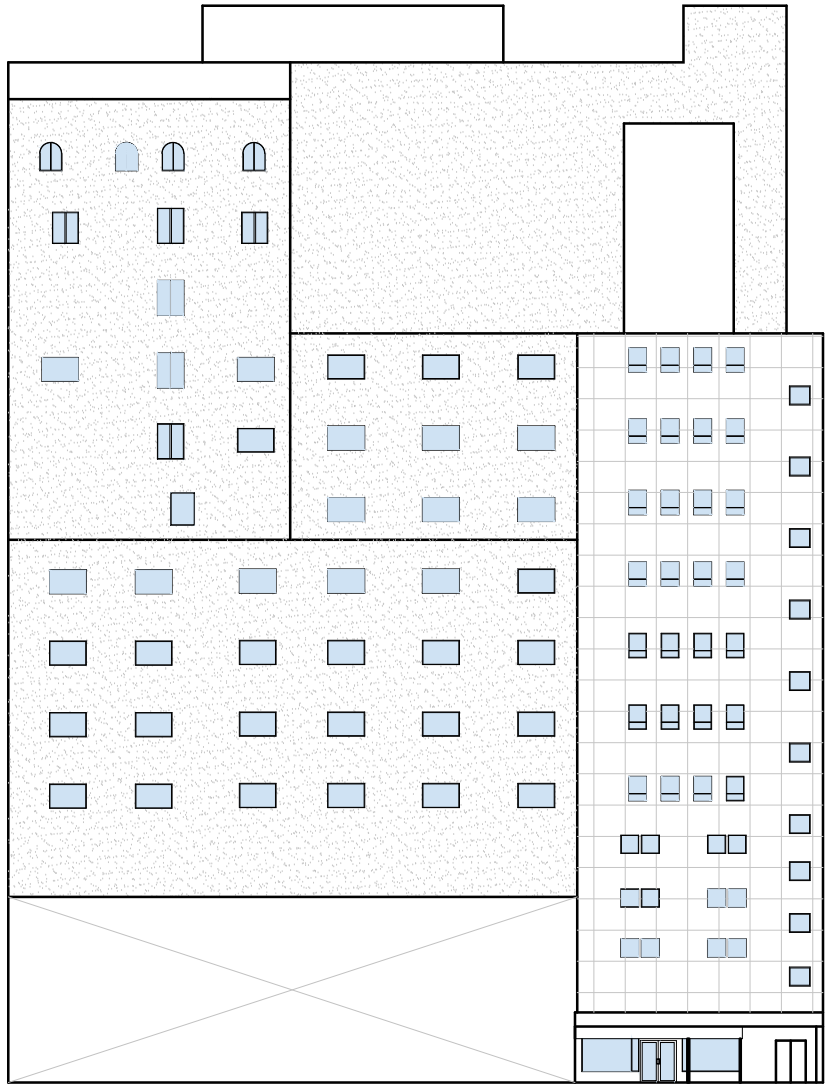

② WEST ELEVATION

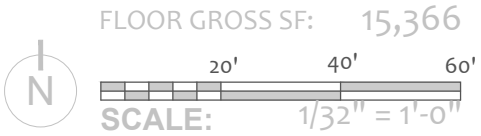

OWNER:

CLIENT:




Arktech Solutions LLC.  
10804 Inside Loop  
Orlando, FL 32825  
tel: (407) 205-7787  
[www.ArktechSolution.com](http://www.ArktechSolution.com)

|             |                         |
|-------------|-------------------------|
| FC NAME:    | ----                    |
| FCID:       | N/A                     |
| FC ADDRESS: | -----<br>-----<br>----- |


|                   |            |
|-------------------|------------|
| FIELD SURVEYOR:   | ----       |
| PROJECT DIRECTOR: | M.Vanegas  |
| CHECKED BY:       | ----       |
| DATE COMPLETED:   | 10/17/2022 |

|                 |         |
|-----------------|---------|
| PROJECT NUMBER: | 22916   |
| SHEET:          | AX001.1 |
| DRAWING NUMBER: | 35      |
| OF:             | 36      |


|               |                     |
|---------------|---------------------|
| DRAWING NAME: | Exterior Elevations |
|---------------|---------------------|

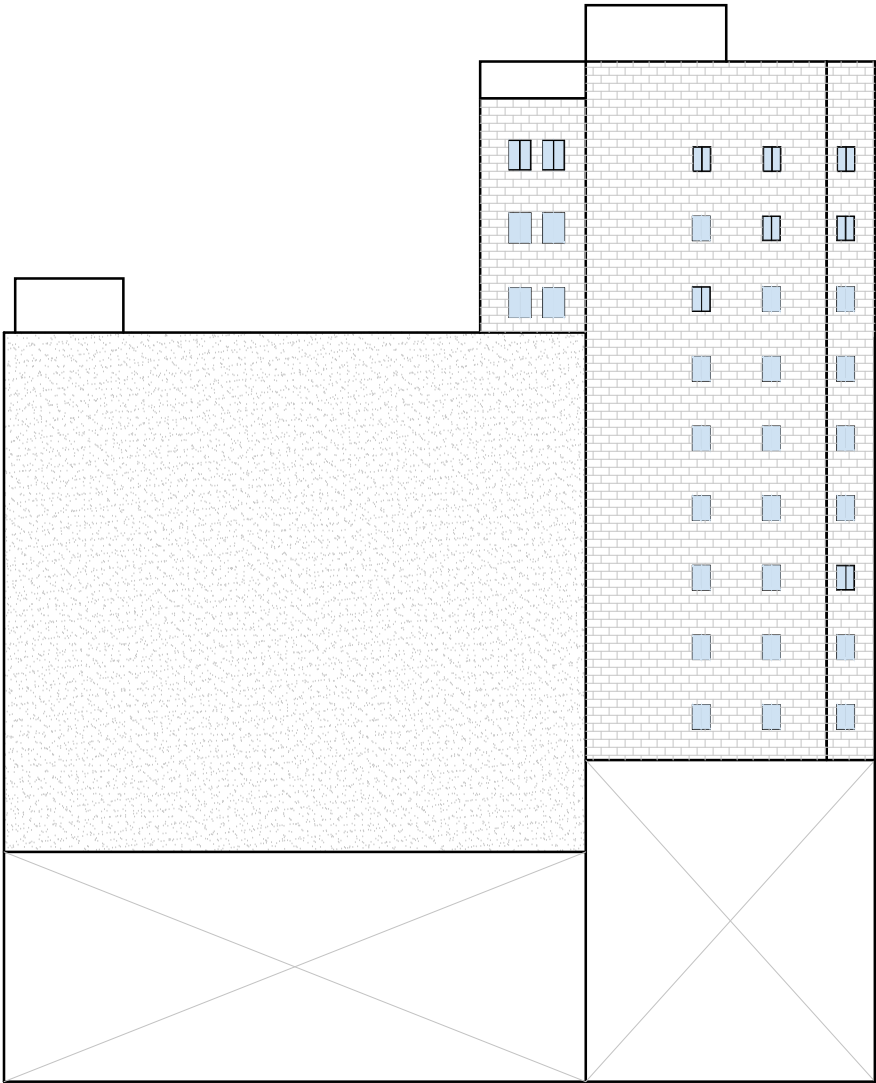

3 NORTH ELEVATION

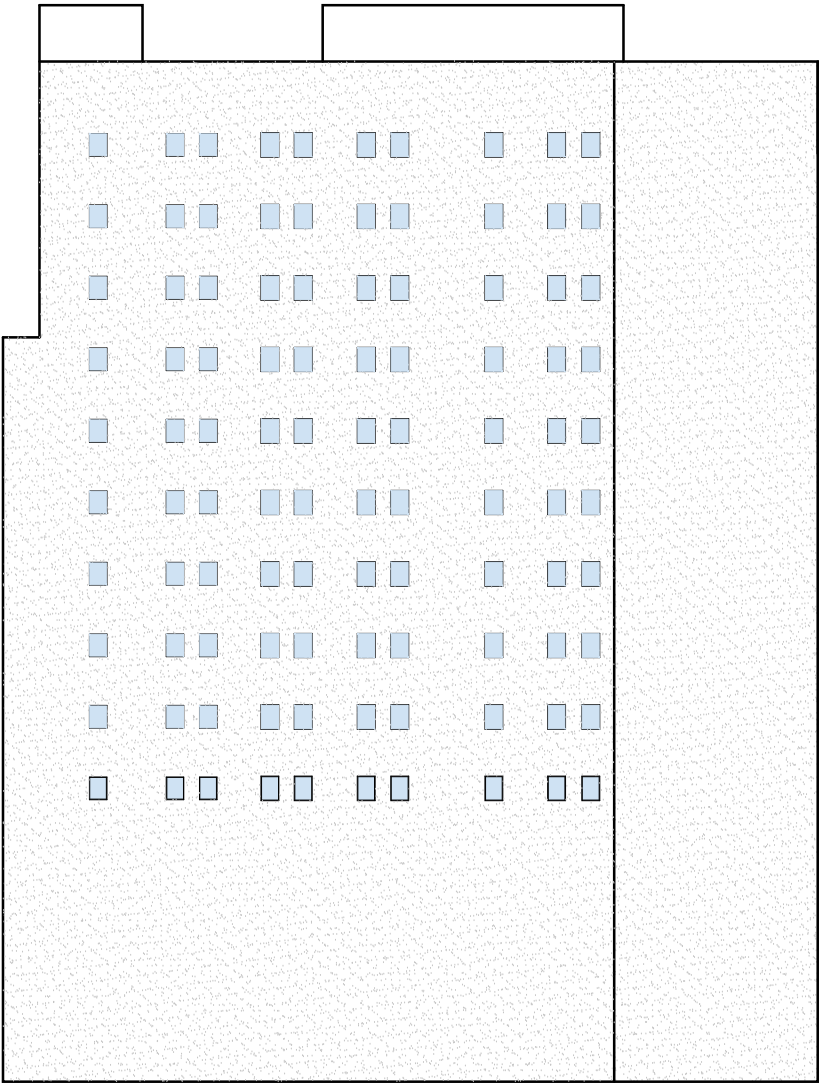

4 EAST ELEVATION

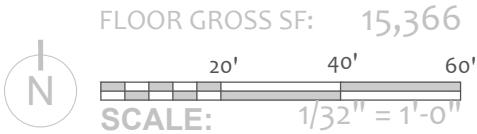

OWNER:

CLIENT:



Arktech Solutions LLC.  
10804 Inside Loop  
Orlando, FL 32825  
tel: (407) 205-7787  
[www.ArktechSolution.com](http://www.ArktechSolution.com)

|             |                         |
|-------------|-------------------------|
| FC NAME:    | ----                    |
| FCID:       | N/A                     |
| FC ADDRESS: | -----<br>-----<br>----- |

|                   |            |
|-------------------|------------|
| FIELD SURVEYOR:   | ----       |
| PROJECT DIRECTOR: | M.Vanegas  |
| CHECKED BY:       | -----      |
| DATE COMPLETED:   | 10/17/2022 |

|                 |         |
|-----------------|---------|
| PROJECT NUMBER: | 22916   |
| SHEET:          | AX001.2 |
| DRAWING NUMBER: | 36      |
| OF:             | 36      |

|               |                     |
|---------------|---------------------|
| DRAWING NAME: | Exterior Elevations |
|---------------|---------------------|