



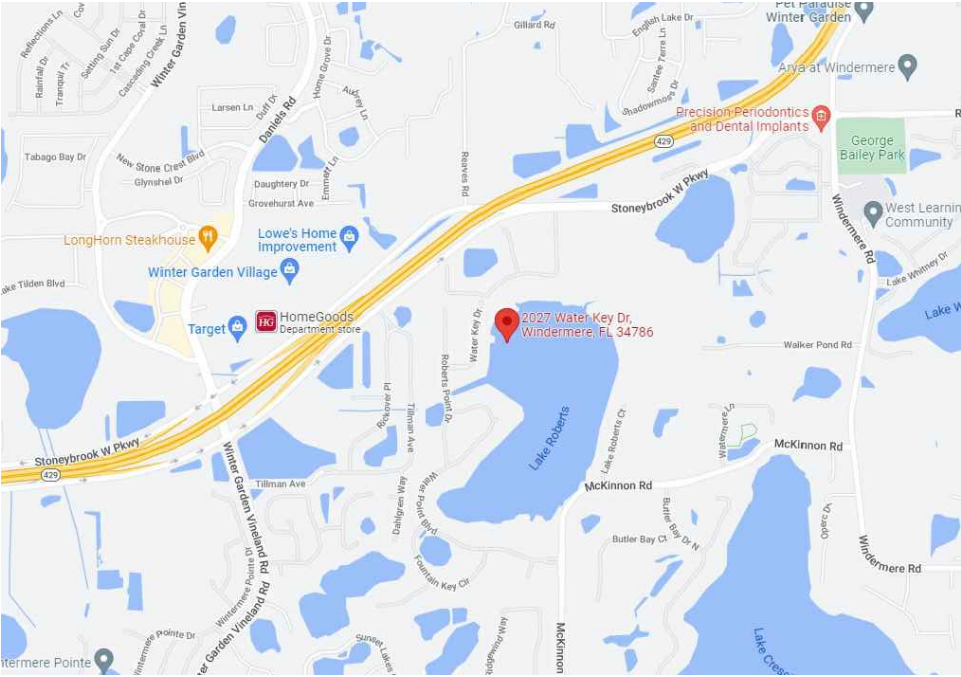

Area Map

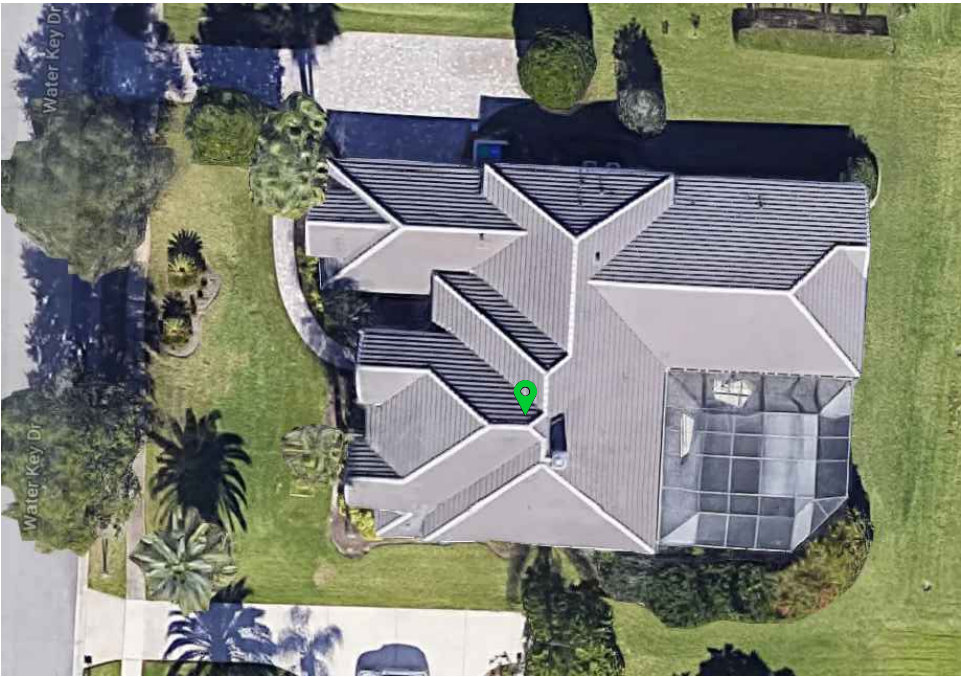

Aerial Photograph



Existing Site Photograph



360 Photo / As-Built Survey

Project Name

FCID

N/A


Address

Project Total S.F.

4,679



Arktech Solutions LLC
10804 Inside Loop
Orlando, FL 32825
P 214 606 5281
www.arktech.org

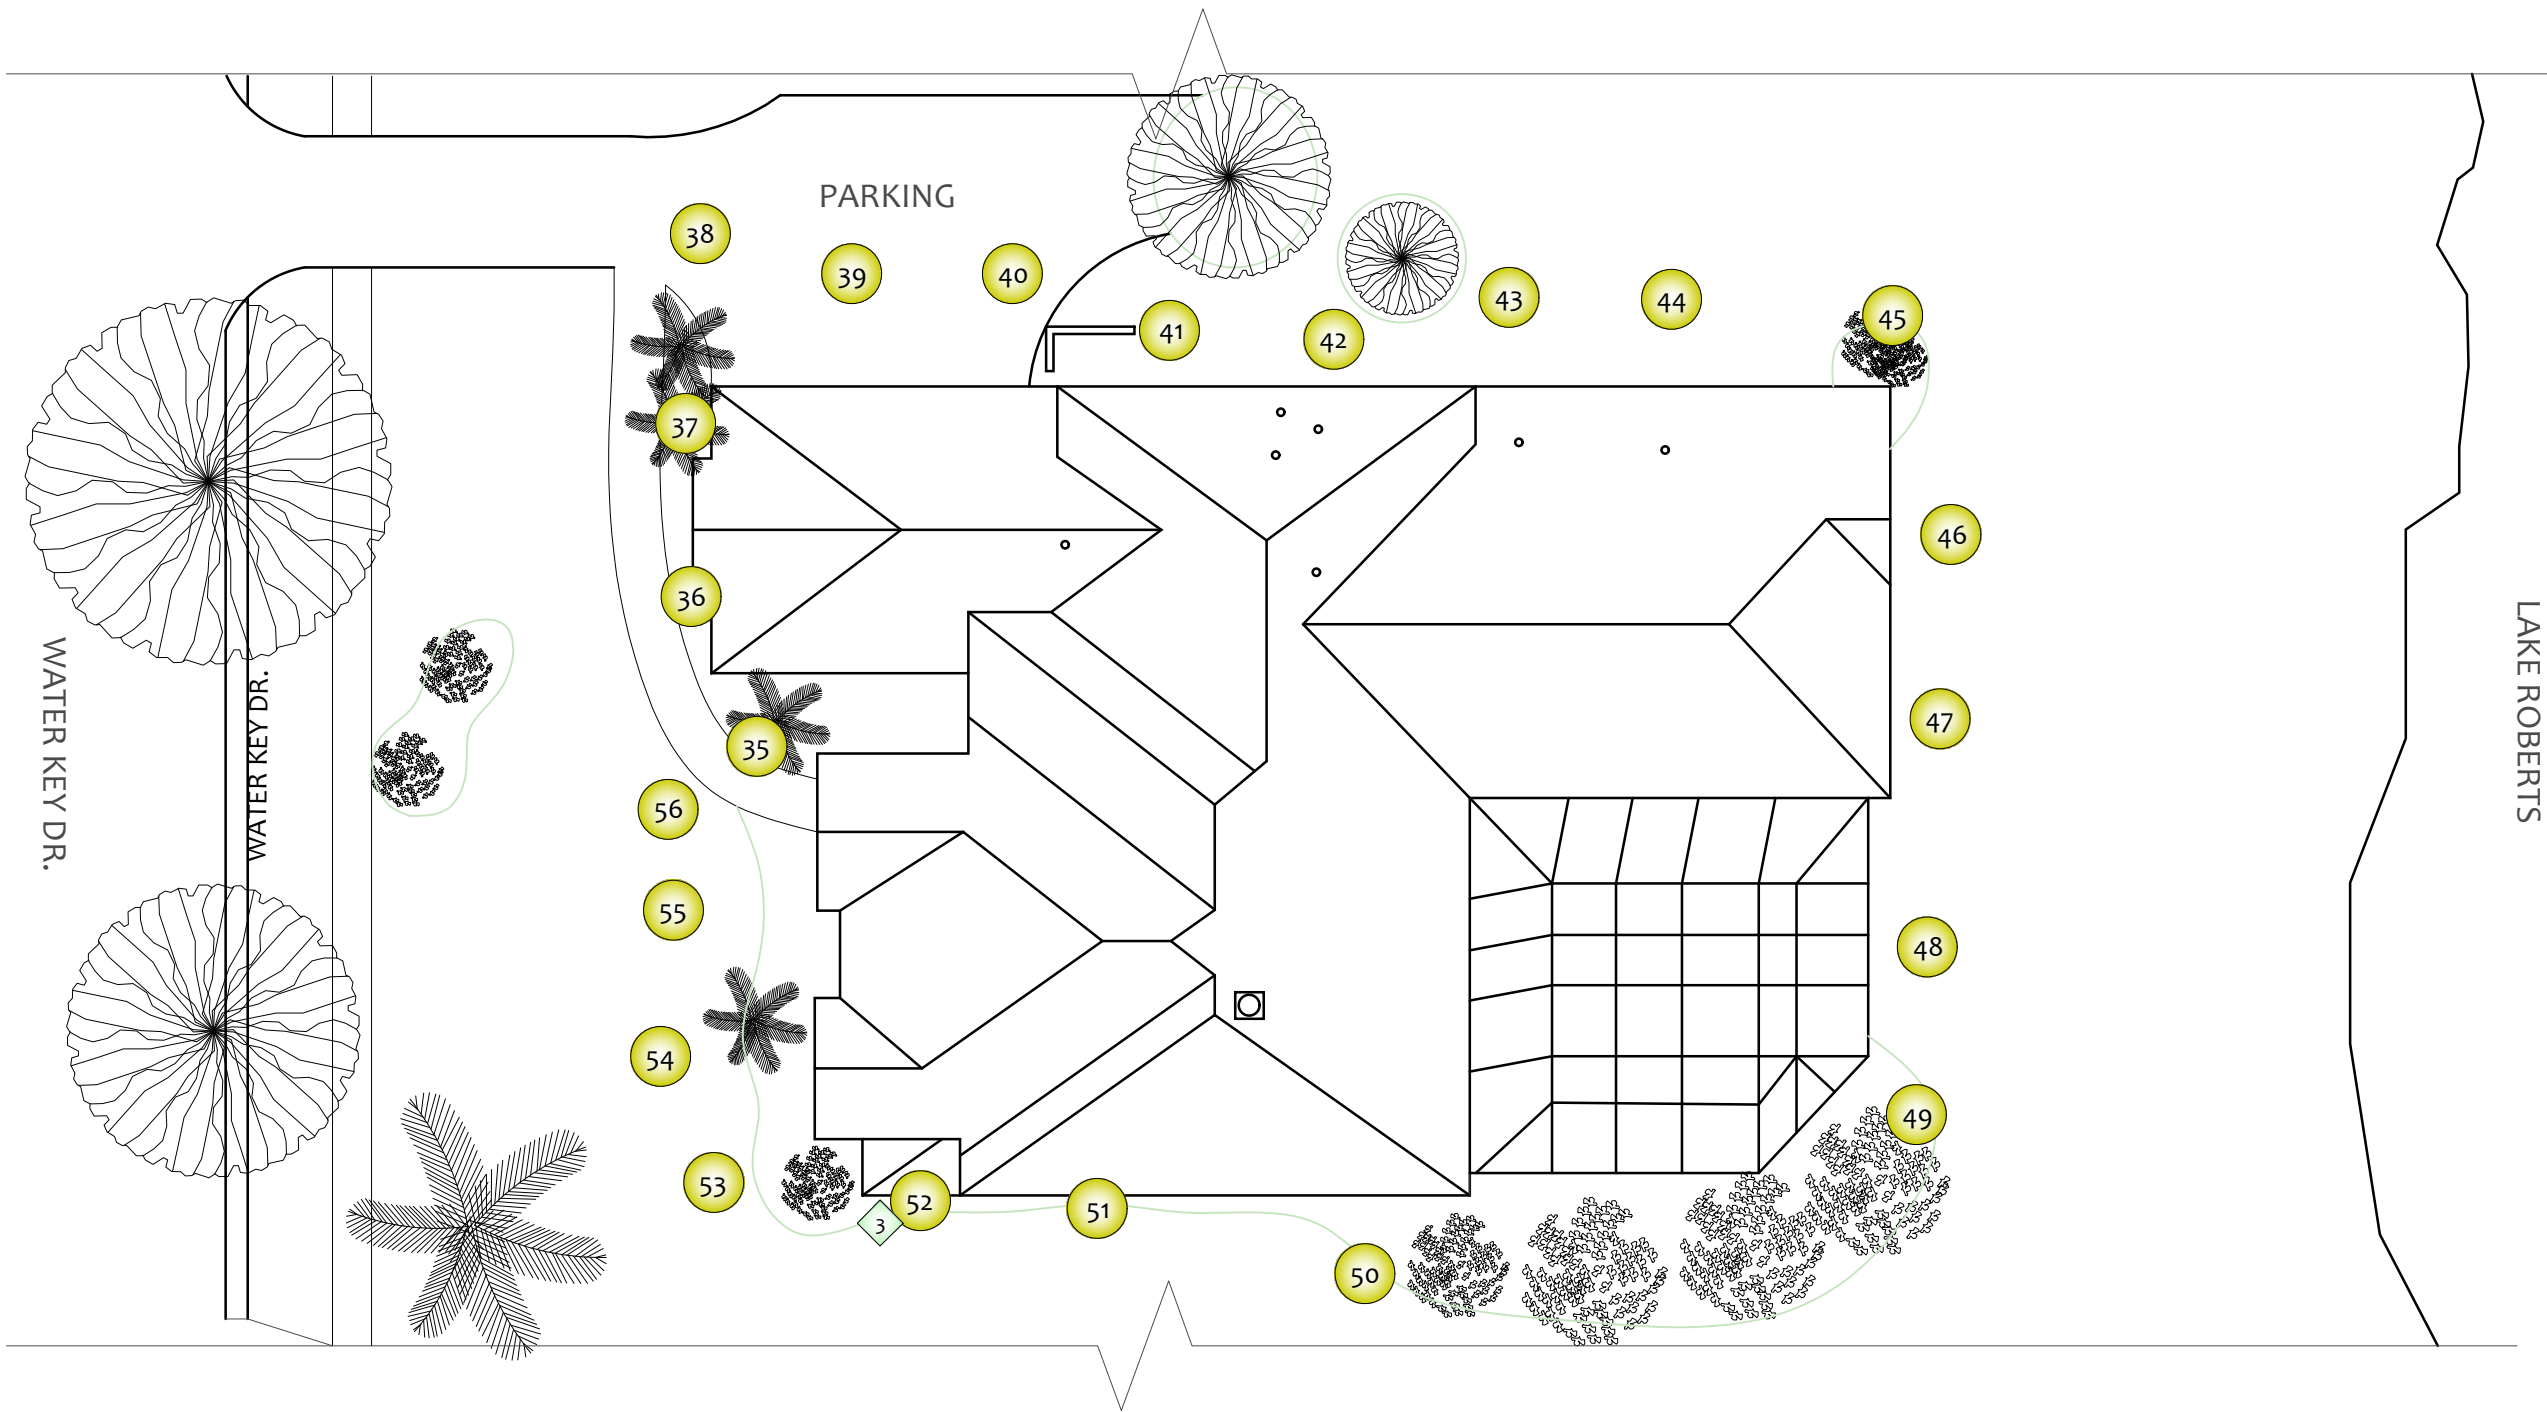

- 1 GAS MAIN & METER
- 2 WATER MAIN & METER
- 3 ELECTRIC MAIN & METER



ACCESSIBLE
PARKING STALL



ACCESSIBLE
PATH OF TRAVEL



SCALE: NTS



360 Vantage
Point



Still Photo



Red Flag
Notification

OWNER:

CLIENT:




Arktech Solutions LLC.
10804 Inside Loop
Orlando, FL 32825
tel: (214) 606-5281
www.Arktech.org

FC NAME:	----
FCID:	N/A
FC ADDRESS:	----- ----- -----

FIELD SURVEYOR:	----
PROJECT DIRECTOR:	----
CHECKED BY:	RA
DATE COMPLETED:	4-9-2022

PROJECT NUMBER:	
22906	
SHEET:	
SP01	
DRAWING NUMBER:	OF:
2	9

DRAWING NAME:	SITE PLAN
---------------	-----------

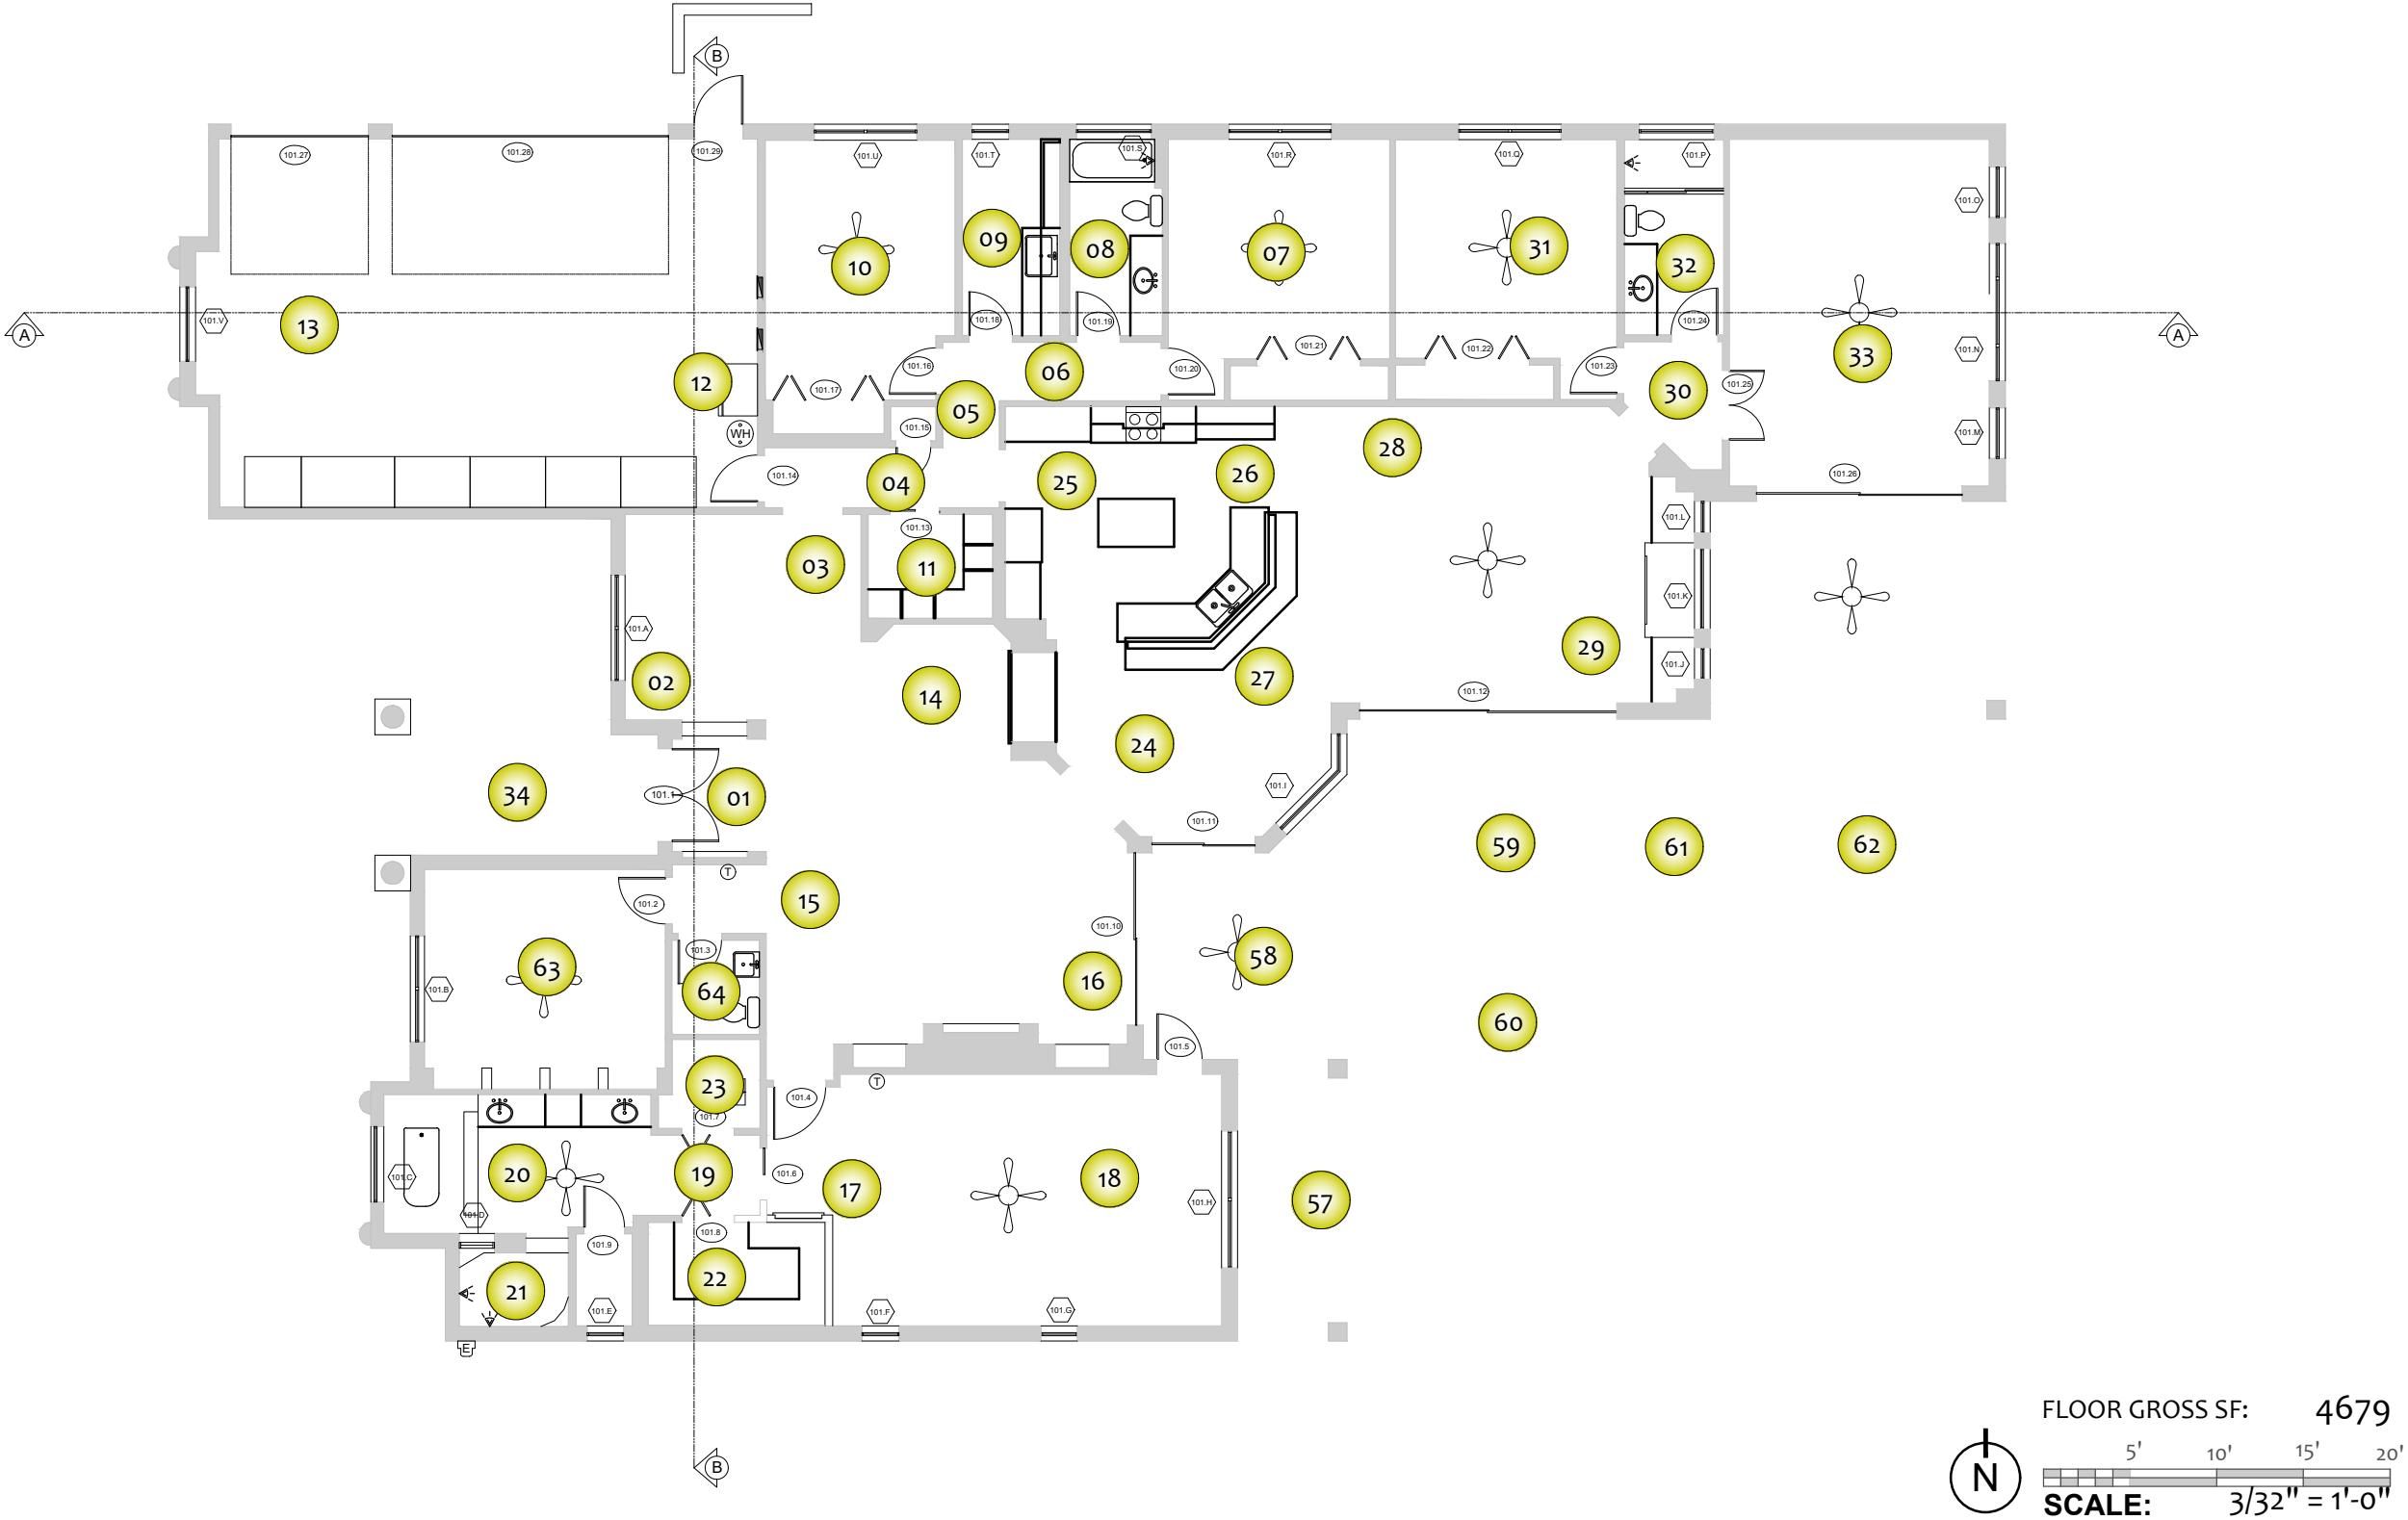

- 01 360 Vantage Point
- 01 Still Photo
- 01 Red Flag Notification

OWNER:

CLIENT:



Arktech Solutions LLC.
10804 Inside Loop
Orlando, FL 32825
tel: (214) 606-5281
www.Arktech.org


FC NAME:	

FCID:	
N/A	
FC ADDRESS:	

FIELD SURVEYOR:	

PROJECT DIRECTOR:	

CHECKED BY:	
RA	
DATE COMPLETED:	
4-9-2022	
PROJECT NUMBER:	
22906	
SHEET:	
A001	
DRAWING NUMBER:	OF:
03	9
DRAWING NAME:	
360 PHOTO PLAN 1ST FL.	

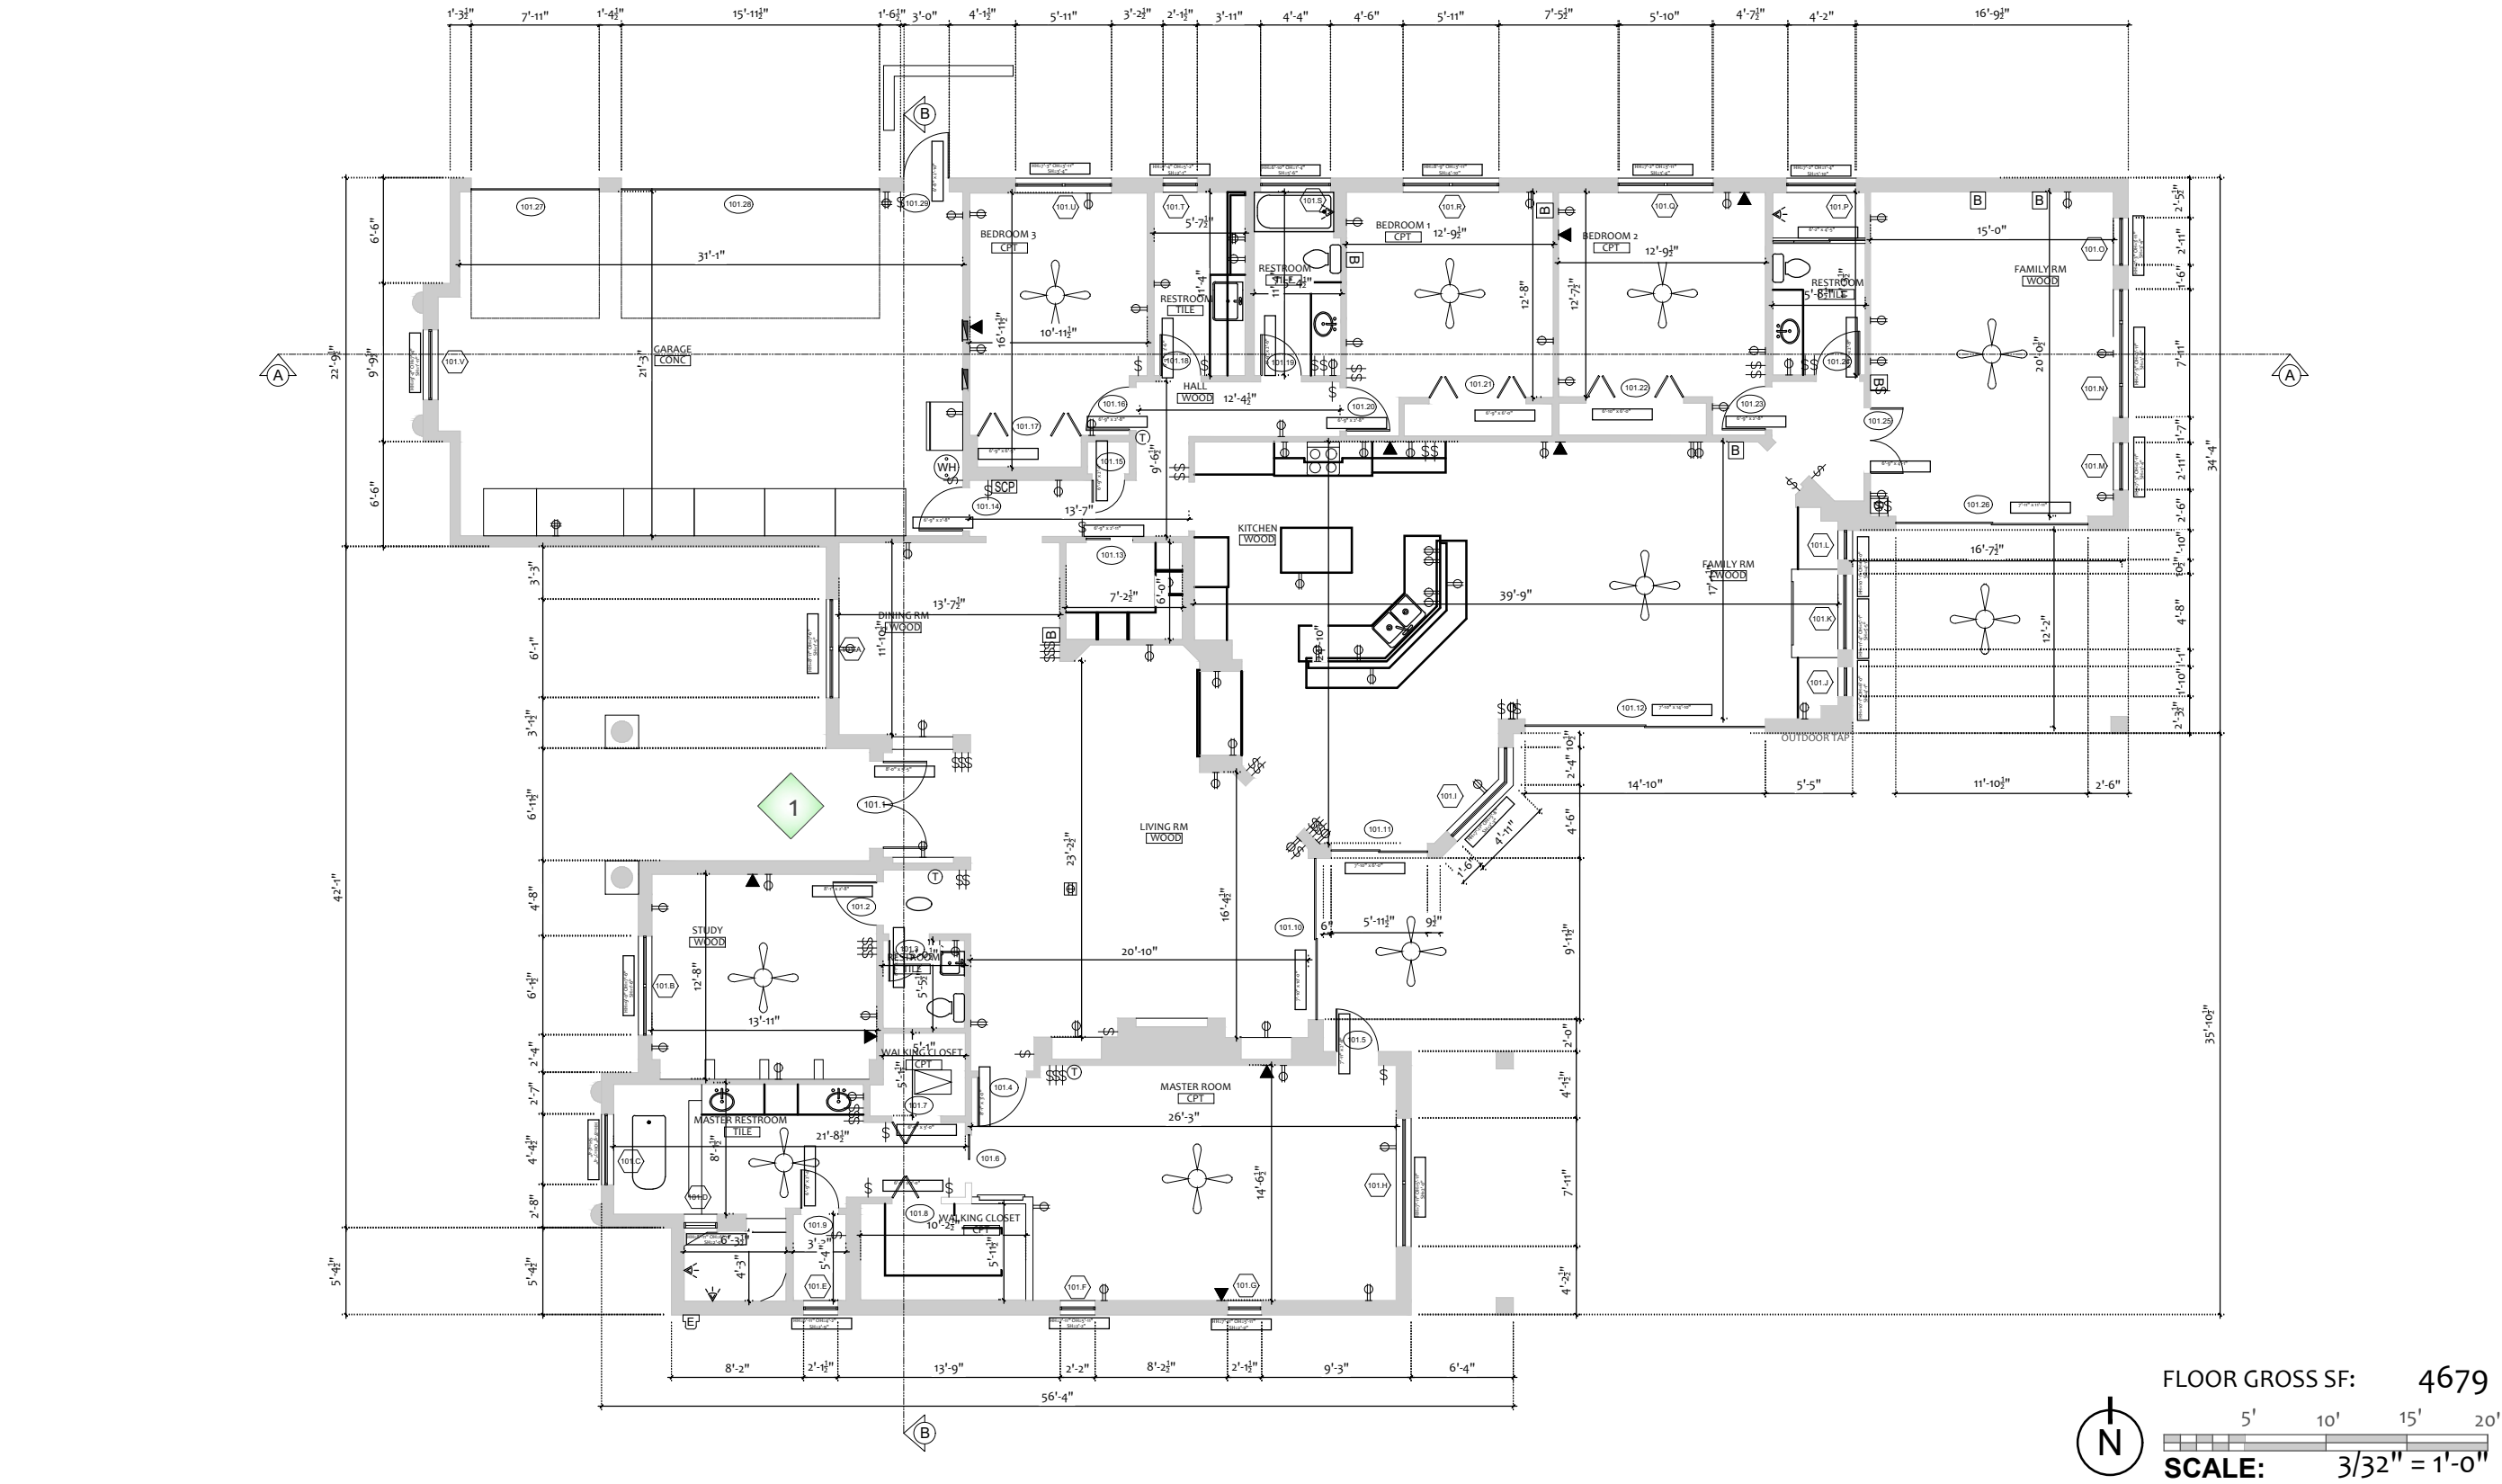

- 1 BUILDING ENTRANCE
- 2 EMERGENCY/ ALARMED EXIT DOOR

- CPT CARPET
- TILE TILE
- WOOD WOOD
- S-LIN LINOLEUM SHEET
- MAT FLOOR MAT
- VCT VINYL COMP. TILE
- CONC CONCRETE

- ⊕ DUPLEX OUTLET
- ⊕ QUAD PLEX OUTLET
- ▼ DATA OUTLET
- ▼ DATA/ TELEPHONE
- ⊕ TELEPHONE
- ⊕ DUPLEX - FLOOR
- ⊕ QUADPLEX - FLOOR
- ▼ DATA - FLOOR
- ▼ DATA / TELE - FLOOR
- ⊕ THERMOSTAT
- ⊕ FIRE EXTINGUISHER
- ⊕ FIRE HOSE
- ⊕ LIGHT SWITCH

- SCP SEC. CONT'L. PANEL
- MONITOR
- AV AV OUTLET
- ELEC PANEL - RECESSED
- ELEC PANEL - SURFACE
- ELEC GENERATOR

- C CARD READER
- K KEYPAD LOCK
- P PULL STATION
- V FIRE CUT-OFF VALVE
- DRINKING FOUNTAIN

- VAULT VCT
- COLUMN SIZE 6.5" X 6.5" @ 32'-0" O.C.

FLOOR GROSS SF: 4679
SCALE: 3/32" = 1'-0"

- ROOM NAME & FLOORING MATERIAL
- INTERIOR ELEVATIONS
- EXTERIOR ELEVATIONS

OWNER:

CLIENT:

Arktech Solutions LLC.
10804 Inside Loop
Orlando, FL 32825
tel: (214) 606-5281
www.Arktech.org

FC NAME: ---

FCID: N/A

FC ADDRESS: ---

FIELD SURVEYOR: ---

PROJECT DIRECTOR: ---

CHECKED BY: RA


DATE COMPLETED: 4-9-2022

PROJECT NUMBER: 22906

SHEET: A002

DRAWING NUMBER: 04 OF: 9

DRAWING NAME: 1st FLOOR PLAN

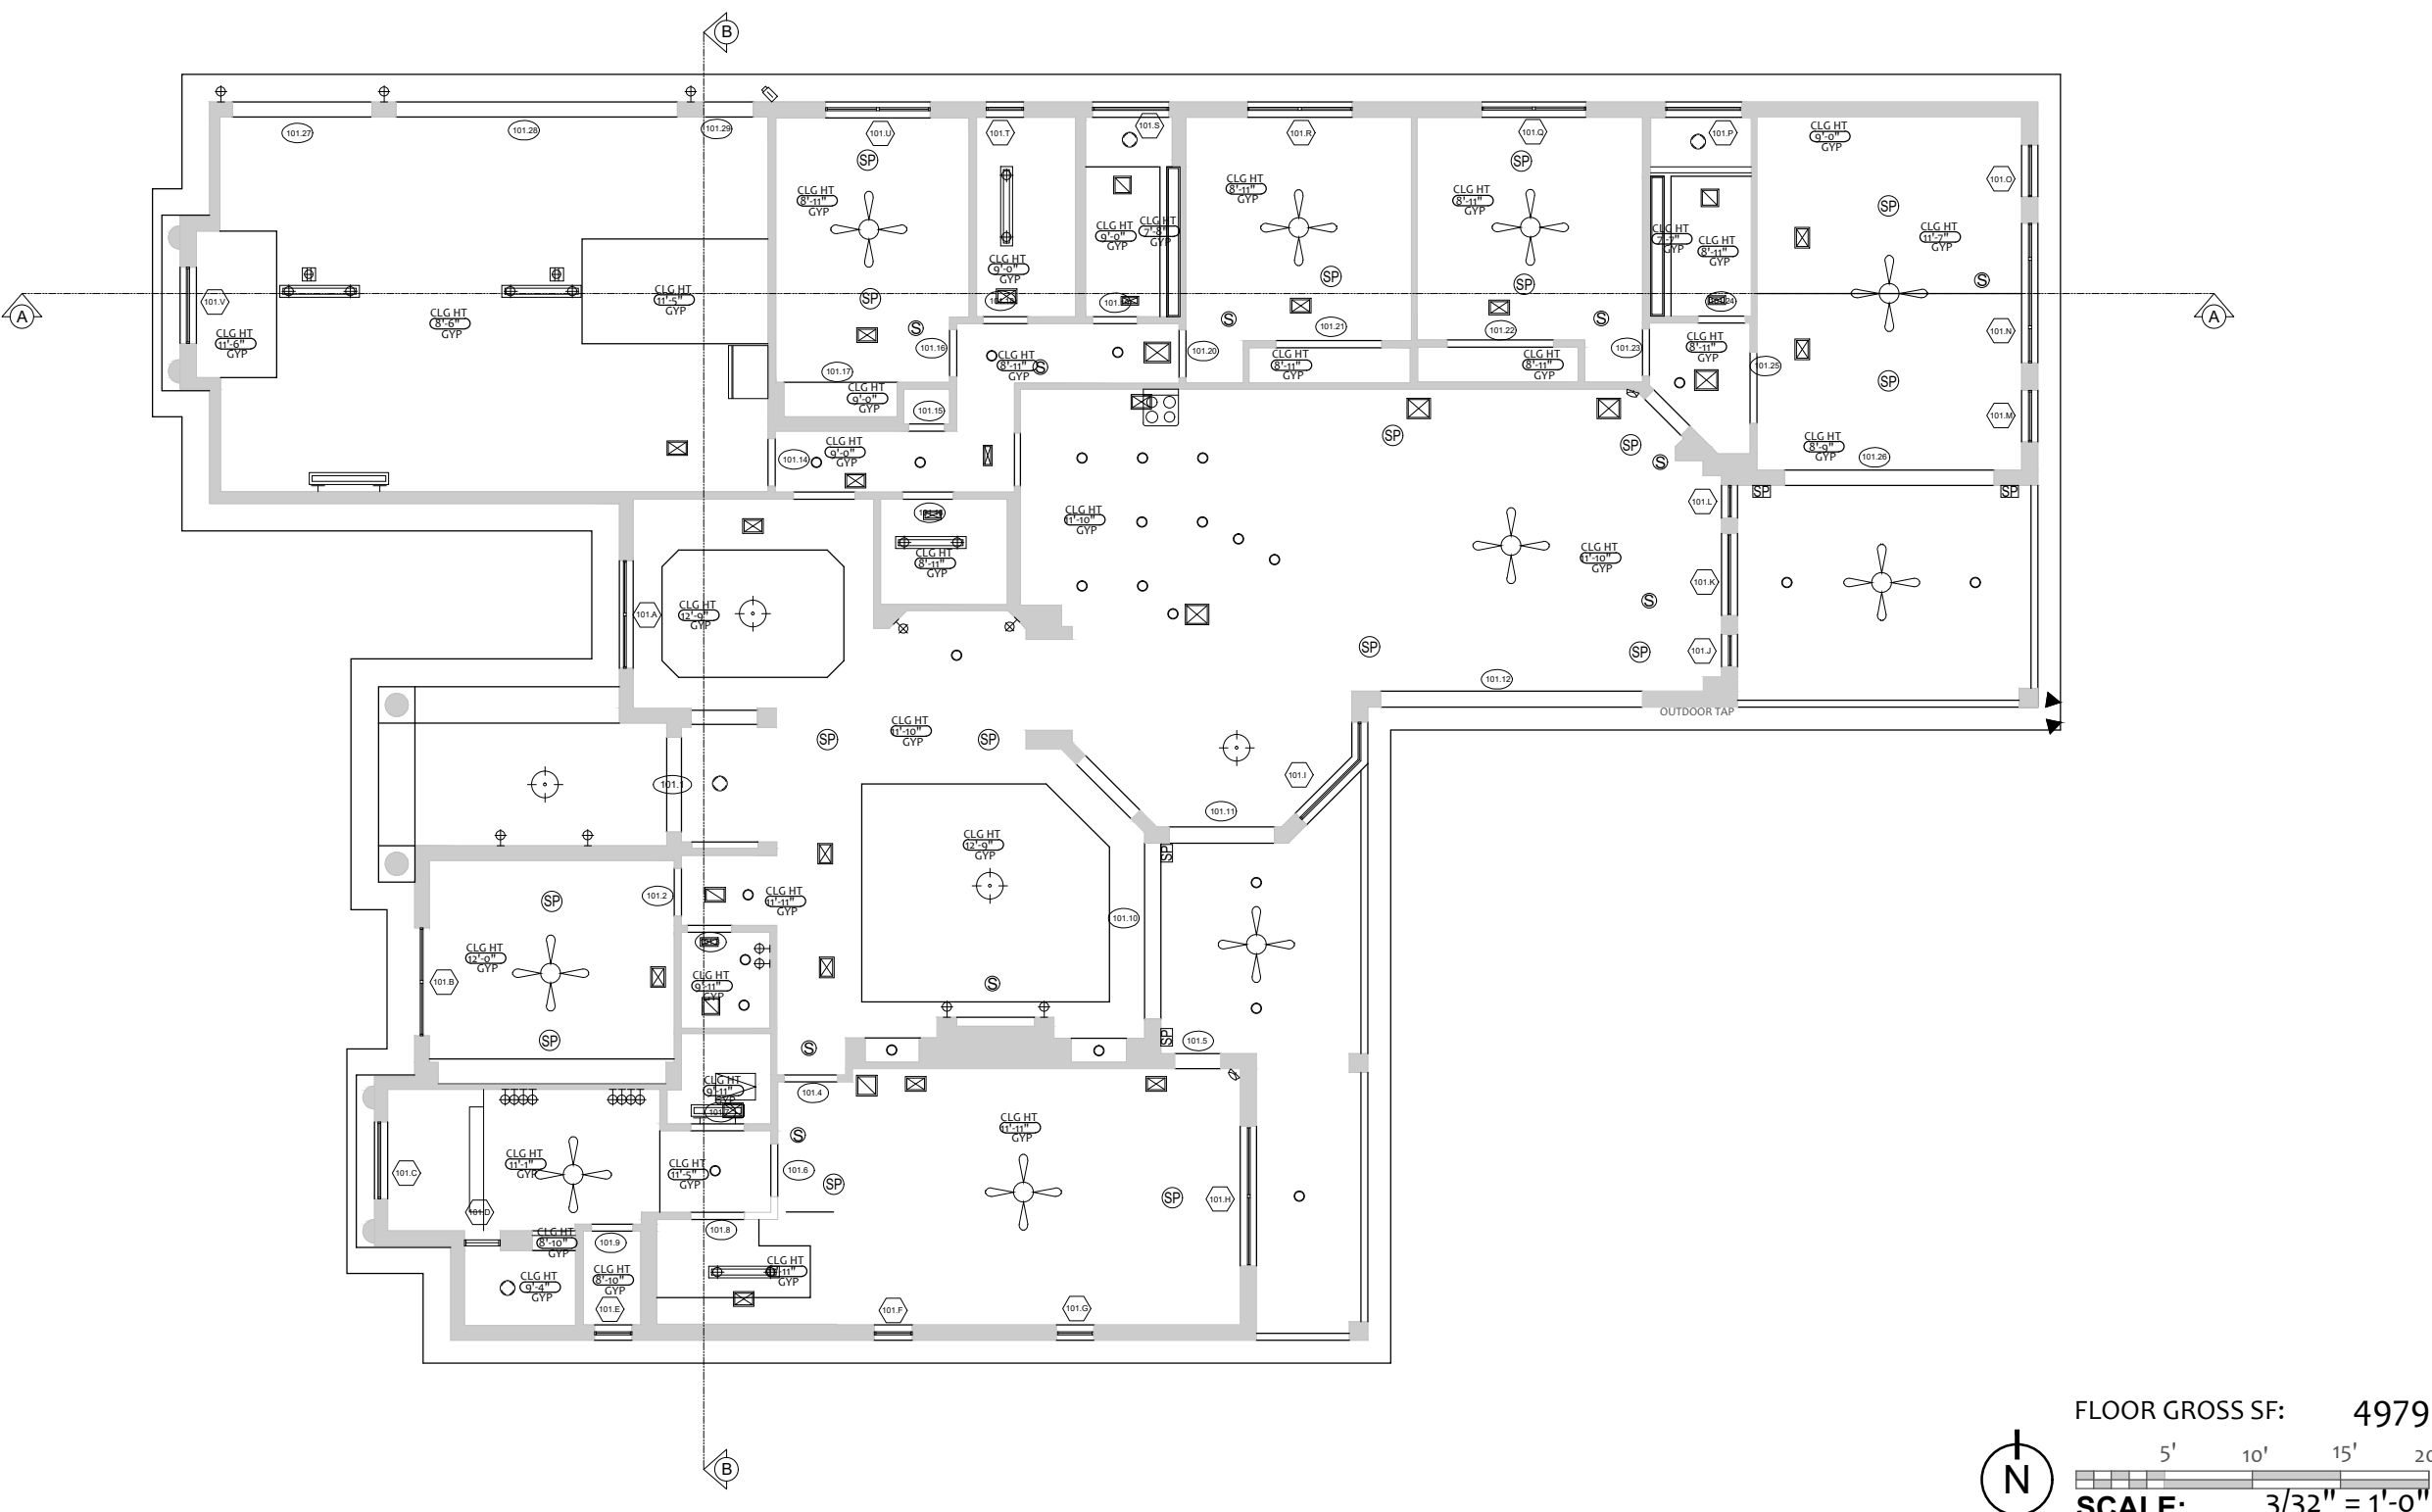

ACT
GYP BD
STRUCT
CONC
METAL
WOOD
ACT DIR
APP

CEILING TILE
GYPSUM BOARD
STRUCTURE
CONCRETE
METAL
WOOD
CEILING TILE,
DIRECT-APPLIED

DUPLEX - CEILING

QUADPLEX - CEILING

DATA - CEILING

DATA / TELE - CEILING

SPEAKER

SMOKE DETECTOR

FIRE SPRINKLER

EMERGENCY LIGHT

FIRE HORN/ALARM

MONITOR

EXIT SIGN

MOTION SENSOR - CEILING

MOTION SENSOR - WALL

FIRE STROBE

SURVEILLANCE CAMERA

CAMERA BUBBLE

2 x 4 FLUORESCENT FIXTURE

2 x 2 FLUORESCENT FIXTURE

FLUORESCENT FIXTURE

UTILITY FLUORESCENT FIXTURE

TRACK LIGHT FIXTURE

RECESSED CAN LIGHT

ADJUSTABLE CAN LIGHT

PENDANT LIGHT

WALL SCONCE

SURFACE MOUNTED LIGHT

SUPPLY AIR REGISTER

RETURN AIR REGISTER

SUPPLY REGISTERS

VENT

CEILING FAN

CLG HT
8'-0"
ACT

HEIGHT OF CEILING
FROM FLOOR &
CEILING MATERIAL

OWNER:

CLIENT:

Arktech Solutions LLC.
10804 Inside Loop
Orlando, FL 32825
tel: (214) 606-5281
www.Arktech.org

FC NAME:

FCID:
N/A

FC ADDRESS:

FIELD SURVEYOR:

PROJECT DIRECTOR:

CHECKED BY:
RA

DATE COMPLETED:
4-9-2022


PROJECT NUMBER:
22906

SHEET:
A003

DRAWING NUMBER:
05

OF:
9

DRAWING NAME:
REF. CLNG 1st FL PLAN

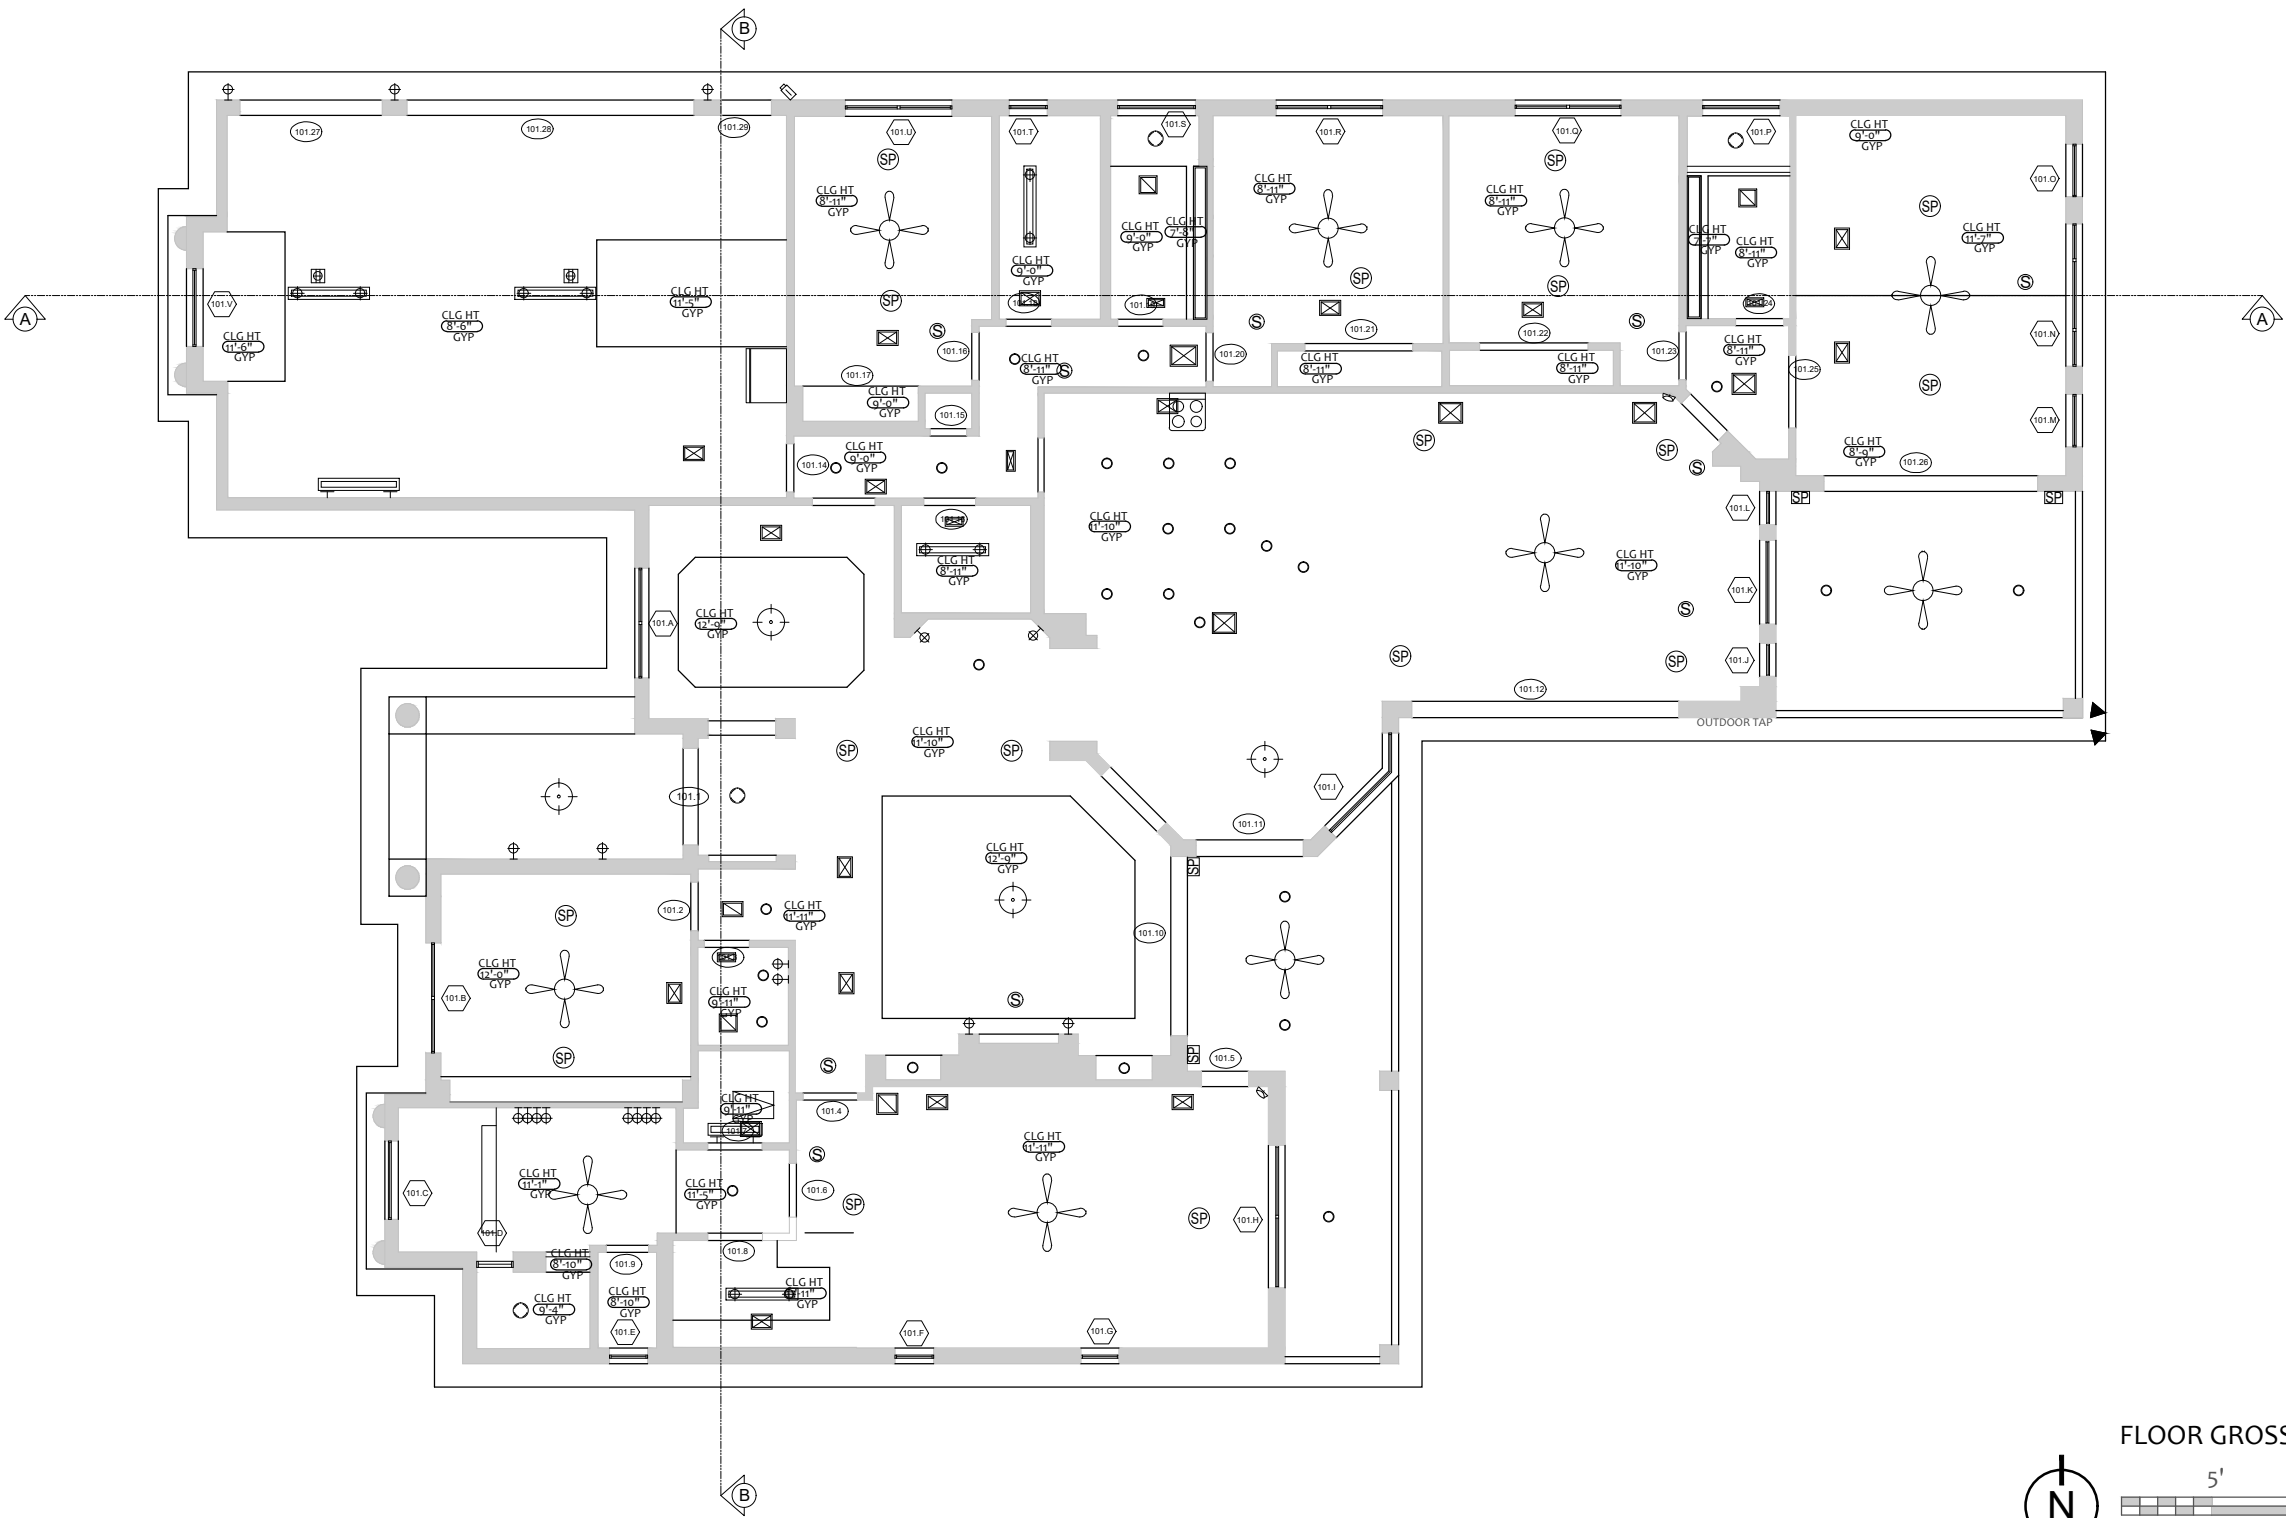

FLOOR GROSS SF: 4979

SCALE: 3/32" = 1'-0"

- | | | |
|-----------------------|--------------------------|---------------------|
| ⌚ DUPLEX OUTLET | ⌚ SWITCH - SINGLE POLE | ⌚ SMOKE DETECTOR |
| ⌚ QUAD PLEX OUTLET | - USE FOR REF. CLG. PLAN | ⌚ SPRINKLER HEAD |
| ⌚ LIGHT SWITCH | ⌚ EXIT LIGHT | ⌚ EMERGENCY LIGHT |
| ⌚ DATA OUTLET | ⌚ CARD SWIPE | ⌚ SECURITY CAMERA |
| ⌚ DATA/ TELEPHONE | ⌚ KEY PAD | ⌚ CAMERA BUBBLE |
| ⌚ DUPLEX - FLOOR | ⌚ F.D. PULL STATION | ⌚ MOTION SENSOR |
| ⌚ QUADPLEX - FLOOR | ⌚ FIRE EXTINGUISHER | ⌚ FIRE STROBE |
| ⌚ DATA - FLOOR | ⌚ SEC. CONT'L. PANEL | ⌚ FIRE HORN |
| ⌚ DATA / TELE - FLOOR | ⌚ FIRE HOSE | ⌚ STROBE/HORN COMBO |
| ⌚ THERMOSTAT | ⌚ MONITOR | ⌚ SPEAKER |
| | | ⌚ WIFI Antenna |

OWNER:

CLIENT:



Arktech Solutions LLC.
10804 Inside Loop
Orlando, FL 32825
tel: (214) 606-5281
www.Arktech.org

FC NAME:	----
FCID:	N/A
FC ADDRESS:	----- ----- -----
FIELD SURVEYOR:	----
PROJECT DIRECTOR:	----
CHECKED BY:	RA
DATE COMPLETED:	4-9-2022
PROJECT NUMBER:	22906
SHEET:	A004
DRAWING NUMBER:	06
OF:	9
DRAWING NAME:	ELECTRICAL FL PLAN


DOOR SCHEDULE															
DOOR NO.	TYPE	CLEAR OPNG WIDTH	FINISH	SIZE (WIDTH X HEIGHT)	DOOR			FRAME		HARDWARE DETAILS				THK.	REMARKS
					TYPE	MAT'L	COND.	TYPE	MAT'L	HEAD	JAMB	SILL	TYPE		
101.1	1	5'-5" PAIR	PAINT	5'-5" X 8'-0"	EXTERIOR	GLAZING	GOOD	WOOD	WOOD	-	-		-	1 1/2"	MAIN ENTRY DOOR
101.2	2	2'-8"	PAINT	2'-8" X 8'-1"	INTERIOR	GLAZING	GOOD	WOOD	WOOD	-	-		-	1 1/2"	STUDY DOOR
101.3	3	2'-6"	PAINT	2'-6" X 8'-1"	INTERIOR	WOOD	GOOD	WOOD	WOOD	-	-		-	1 1/2"	RESTROOM DOOR
101.4	3	3'-0"	PAINT	3'-0" X 8'-1"	INTERIOR	WOOD	GOOD	WOOD	WOOD	-	-		-	1 1/2"	MASTER ROOM DOOR
101.5	4	2'-8"	PAINT	2'-8" X 7'-11"	EXTERIOR	GLAZING	GOOD	WOOD	WOOD	-	-		-	1 1/2"	-
101.6	3	3'-0"	PAINT	3'-0" X 8'-0"	INTERIOR	WOOD	GOOD	WOOD	WOOD	-	-		-	1 1/2"	SLIDING DOOR
101.7	4	3'-0"	PAINT	3'-0" X 8'-9"	INTERIOR	WOOD	GOOD	WOOD	WOOD	-	-		-	1 1/2"	BI-FOLD DOOR
101.8	4	3'-0"	PAINT	3'-0" X 8'-9"	INTERIOR	WOOD	GOOD	WOOD	WOOD	-	-		-	1 1/2"	BI-FOLD DOOR
101.9	3	2'-4"	PAINT	2'-4" X 6'-9"	INTERIOR	WOOD	GOOD	WOOD	WOOD	-	-		-	1 1/2"	-
101.10	5	10'-0"	GLAZING	10'-0" X 7'-10"	EXTERIOR	ALUM	GOOD	ALUM	ALUM	-	-		-	1 1/2"	PATIO DOORS
101.11	5	6'-0"	GLAZING	6'-0" X 7'-10"	EXTERIOR	ALUM	GOOD	ALUM	ALUM	-	-		-	1 1/2"	PATIO DOORS
101.12	5	14'-10"	GLAZING	14'-10" X 7'-10"	EXTERIOR	ALUM	GOOD	ALUM	ALUM	-	-		-	1 1/2"	PATIO DOORS
101.13	3	2'-11"	PAINT	2'-11" X 6'-9"	INTERIOR	WOOD	GOOD	WOOD	WOOD	-	-		-	1 1/2"	SLIDING DOOR
101.14	3	2'-8"	PAINT	2'-8" X 6'-9"	INTERIOR	WOOD	GOOD	WOOD	WOOD	-	-		-	1 1/2"	GARAGE DOOR
101.15	3	2'-0"	PAINT	2'-0" X 6'-9"	INTERIOR	WOOD	GOOD	WOOD	WOOD	-	-		-	1 1/2"	-
101.16	3	2'-8"	PAINT	2'-8" X 6'-9"	INTERIOR	WOOD	GOOD	WOOD	WOOD	-	-		-	1 1/2"	BEDROOM 3 DOOR
101.17	6	6'-5 PAIR*	PAINT	6'-5" X 6'-9"	INTERIOR	WOOD	GOOD	WOOD	WOOD	-	-		-	1 1/2"	BI-FOLD DOOR
101.18	3	2'-6"	PAINT	2'-6" X 6'-9"	INTERIOR	WOOD	GOOD	WOOD	WOOD	-	-		-	1 1/2"	RESTROOM DOOR
101.19	3	2'-6"	PAINT	2'-6" X 6'-9"	INTERIOR	WOOD	GOOD	WOOD	WOOD	-	-		-	1 1/2"	RESTROOM DOOR
101.20	3	2'-8"	PAINT	2'-8" X 6'-9"	INTERIOR	WOOD	GOOD	WOOD	WOOD	-	-		-	1 1/2"	BEDROOM 1 DOOR
101.21	4	6'-0 PAIR*	PAINT	6'-0" X 6'-9"	INTERIOR	WOOD	GOOD	WOOD	WOOD	-	-		-	1 1/2"	BI-FOLD DOOR
101.22	4	6'-0 PAIR*	PAINT	6'-0" X 6'-10"	INTERIOR	WOOD	GOOD	WOOD	WOOD	-	-		-	1 1/2"	BI-FOLD DOOR
101.23	3	2'-8"	PAINT	2'-8" X 6'-9"	INTERIOR	WOOD	GOOD	WOOD	WOOD	-	-		-	1 1/2"	BEDROOM 2 DOOR
101.24	3	2'-8"	PAINT	2'-8" X 6'-10"	INTERIOR	WOOD	GOOD	WOOD	WOOD	-	-		-	1 1/2"	RESTROOM DOOR
101.25	3	4'-1" PAIR	PAINT	4'-1" X 6'-9"	INTERIOR	WOOD	GOOD	WOOD	WOOD	-	-		-	1 1/2"	FAMILY ROOM DOOR
101.26	5	11'-11"	GLAZING	7'-11" X 11'-11"	EXTERIOR	ALUM	GOOD	ALUM	ALUM	-	-		-	1 1/2"	PATIO DOORS
101.27	6	7'-11"	METAL	7'-11" X 6'-8"	EXTERIOR	METAL	GOOD	METAL	METAL	-	-		-	1"	GARAGE DOORS
101.28	6	15'-11"	METAL	15'-11" X 6'-8"	EXTERIOR	METAL	GOOD	METAL	METAL	-	-		-	1"	GARAGE DOORS

DOOR & WINDOW SCHEDULES | SCALE: NTS

WINDOW SCHEDULE									
WINDOW NO.	HARD-WARE	TYPE	WINDOW SIZE	SILL HEIGHT (A.F.F.)		FRAME		GLAZING	REMARKS
					FINISH	MAT'L	SIZE		
101.A	-	A	7'-6" X 6'-1"	1'-5"	PAINT	WOOD	1"x2" TYP.	NOT INSULATED	
101.B	-	A	7'-6" X 6'-1"	1'-6"	PAINT	WOOD	1"x2" TYP.	NOT INSULATED	
101.C	-	A	7'-4" X 7'-4"	4'-4"	PAINT	WOOD	1"x2" TYP.	NOT INSULATED	
101.D	-	G	7'-11" X 2'-0"	2'-0"	-	GLAZING	-	NOT INSULATED	
101.E	-	B	4'-2" X 2'-1"	2'-9"	PAINT	WOOD	-	NOT INSULATED	
101.F	-	F	5'-11" X 2'-2"	2'-2"	PAINT	WOOD	-	NOT INSULATED	
101.G	-	F	5'-11" X 2'-2"	2'-2"	PAINT	WOOD	-	NOT INSULATED	
101.H	-	B	5'-11" X 7'-11"	2'-0"	PAINT	WOOD	-	NOT INSULATED	
101.I	-	E	5'-8" X 4'-9"	2'-3"	PAINT	WOOD	-	NOT INSULATED	
101.J	-	E	6'-0" X 1'-10"	4'-1"	PAINT	WOOD	-	NOT INSULATED	
101.K	-	E	5'-1" X 4'-8"	5'-5"	PAINT	WOOD	-	NOT INSULATED	
101.L	-	E	6'-0" X 1'-10"	4'-1"	PAINT	WOOD	-	NOT INSULATED	
101.M	-	B	3'-11" X 2'-11"	3'-4"	PAINT	WOOD	-	NOT INSULATED	
101.N	-	D	3'-11" X 7'-11"	3'-4"	PAINT	WOOD	-	NOT INSULATED	
101.O	-	B	3'-11" X 2'-11"	3'-4"	PAINT	WOOD	-	NOT INSULATED	
101.P	-	C	1'-4" X 4'-4"	5'-10"	PAINT	WOOD	-	NOT INSULATED	
101.Q	-	B	3'-11" X 5'-11"	3'-4"	PAINT	WOOD	-	NOT INSULATED	
101.R	-	B	3'-11" X 5'-11"	3'-4"	PAINT	WOOD	-	NOT INSULATED	
101.S	-	C	1'-4" X 4'-4"	5'-6"	PAINT	WOOD	-	NOT INSULATED	
101.T	-	B	5'-2" X 2'-1"	2'-1"	PAINT	WOOD	-	NOT INSULATED	
101.U	-	B	3'-11" X 5'-11"	3'-4"	PAINT	WOOD	-	NOT INSULATED	
101.V	-	A	7'-4" X 4'-4"	1'-11"	PAINT	WOOD	-	NOT INSULATED	


DOOR & WINDOW SCHEDULES | SCALE: NTS

WINDOW ELEVATION

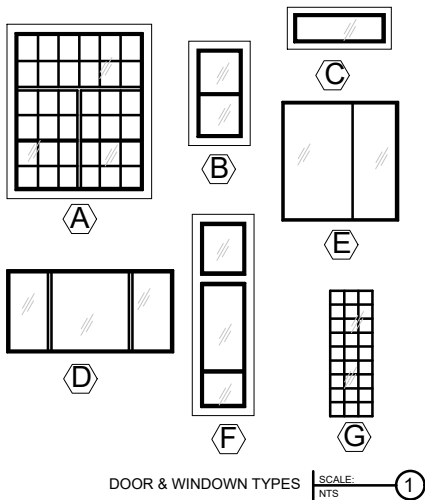

DOOR & WINDOW TYPES | SCALE: NTS

DOOR ELEVATION

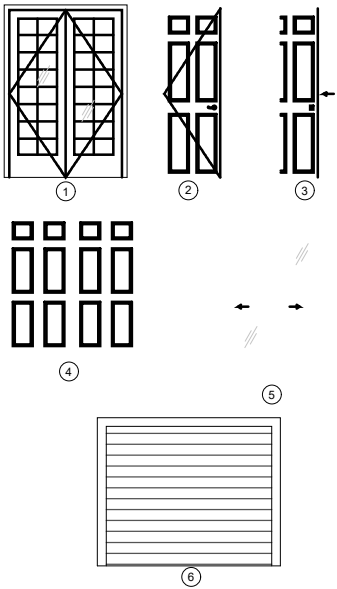

OWNER:

CLIENT:



Arktech Solutions LLC.
10804 Inside Loop
Orlando, FL 32825
tel: (214) 606-5281
www.Arktech.org

FC NAME:	----
FCID:	N/A
FC ADDRESS:	----- ----- -----

FIELD SURVEYOR:	----
PROJECT DIRECTOR:	----
CHECKED BY:	RA
DATE COMPLETED:	4-9-2022

PROJECT NUMBER:	22906
SHEET:	A005
DRAWING NUMBER:	07
OF:	9


DRAWING NAME:
DOOR&WINDOW SCHDL



WEST EXTERIOR ELEVATION

SCALE:
3/32"=1'-0"

1

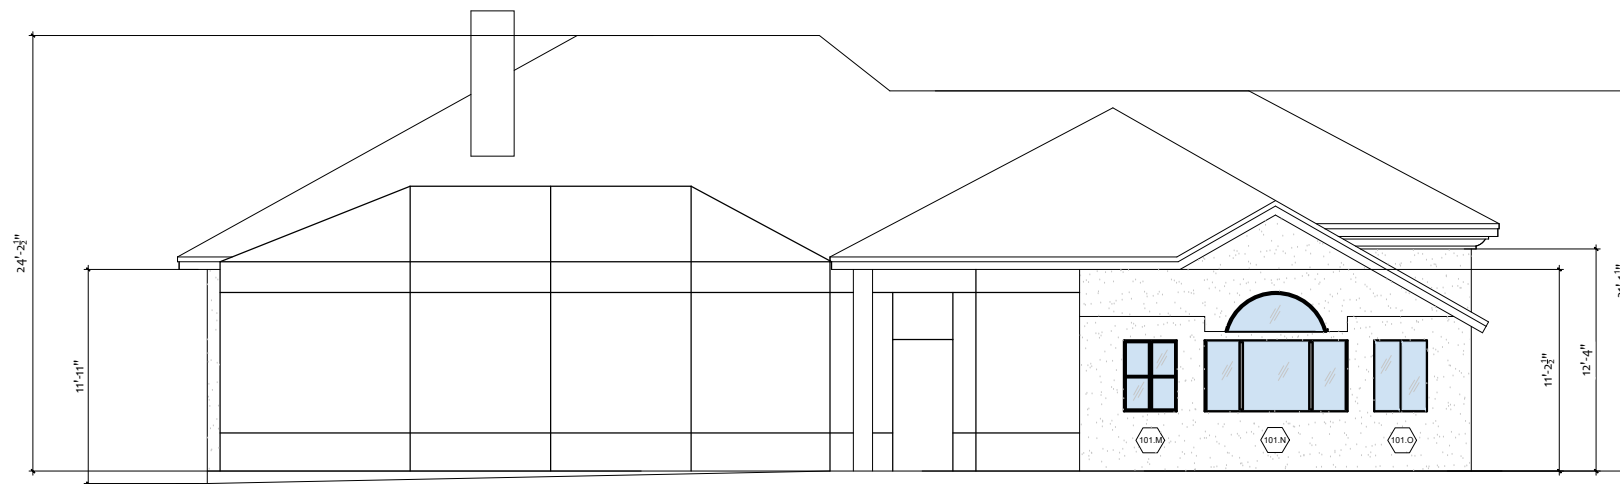

EAST EXTERIOR ELEVATION

SCALE:
3/32"=1'-0"

2

OWNER:

CLIENT:



Arktech Solutions LLC.
10804 Inside Loop
Orlando, FL 32825
tel: (214) 606-5281
www.Arktech.org

FC NAME:

FCID:

N/A

FC ADDRESS:

FIELD SURVEYOR:

PROJECT DIRECTOR:

CHECKED BY:

RA

DATE COMPLETED:

4-9-2022

PROJECT NUMBER:

22906

SHEET:

AX001

DRAWING NUMBER:


08

OF:

9

DRAWING NAME:


EXTERIOR ELEVATIONS

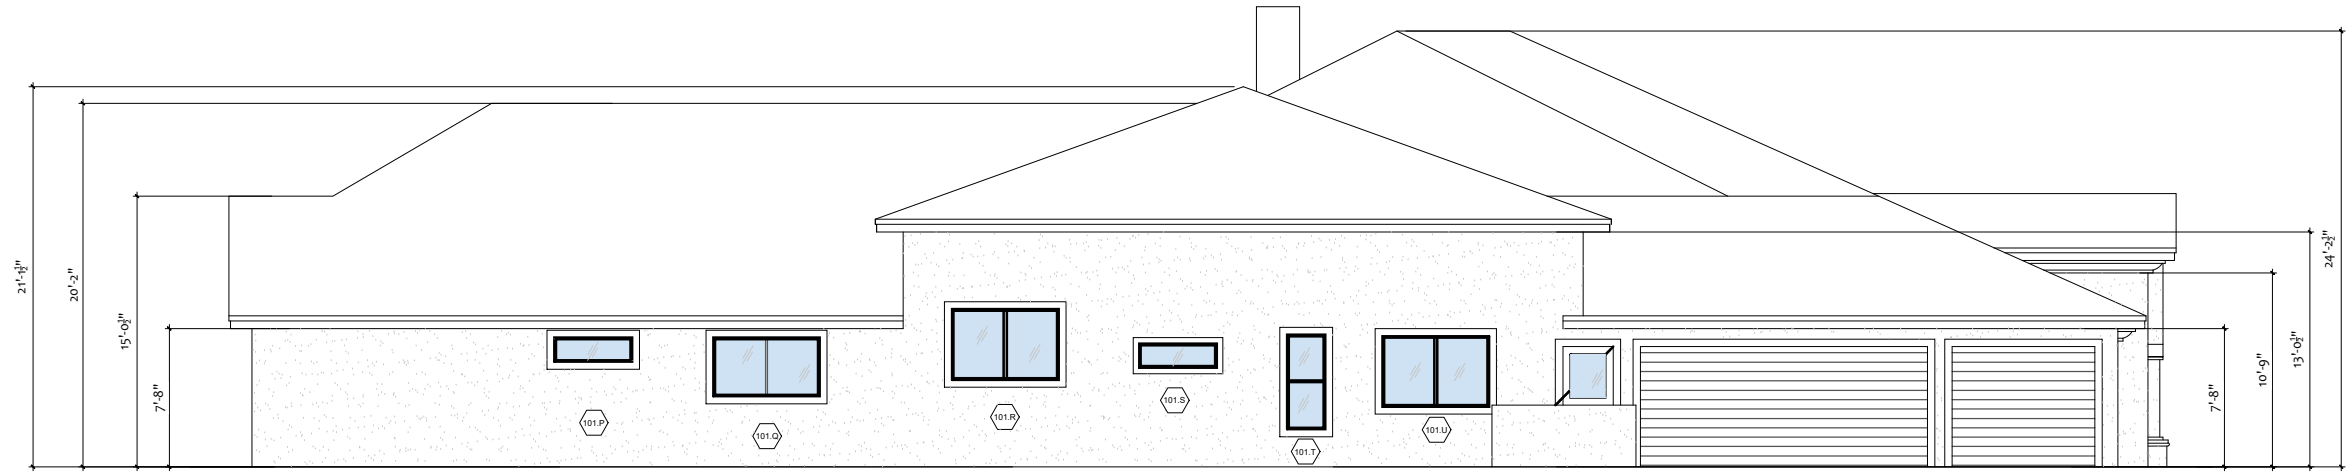

NORTH EXTERIOR ELEVATION

SCALE:
3/32"=1'-0"

3

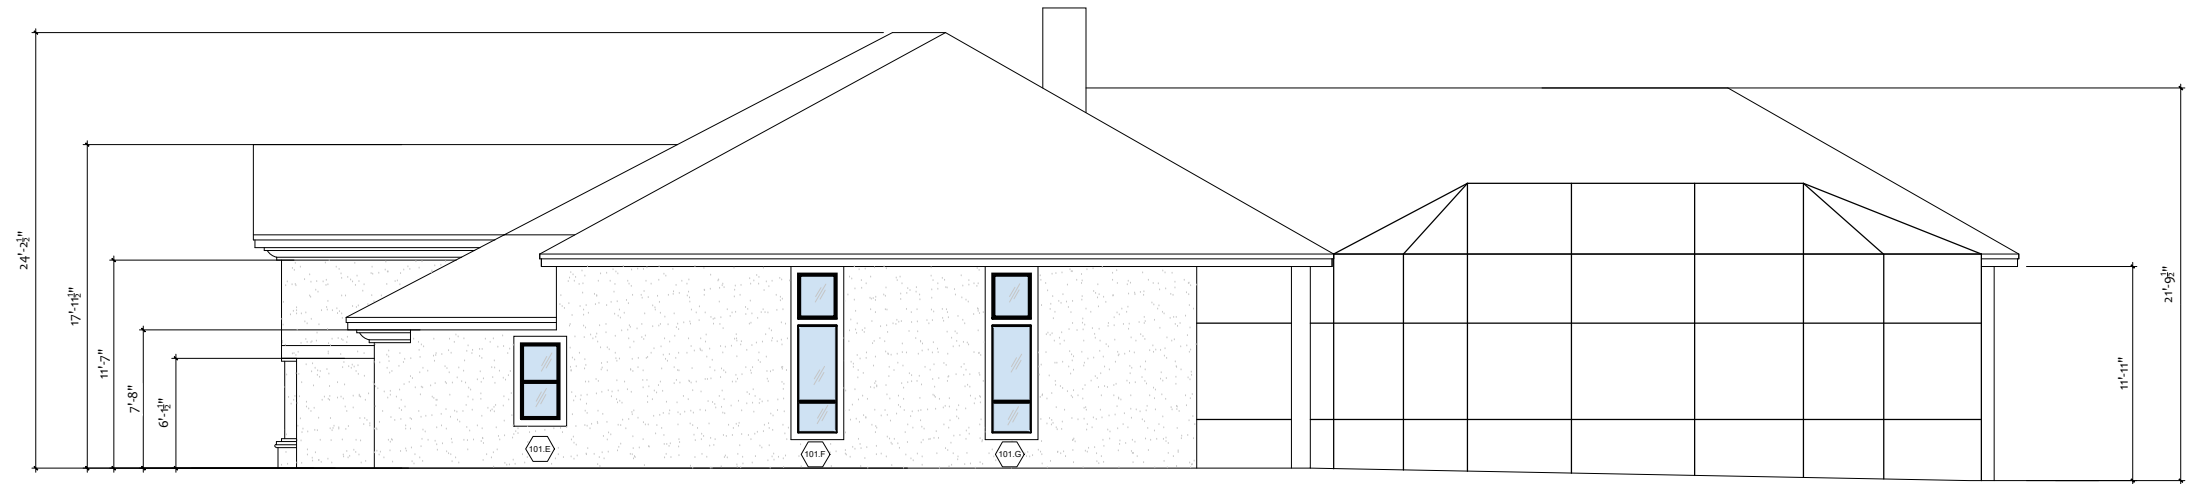

SOUTH EXTERIOR ELEVATION

SCALE:
3/32"=1'-0"

4

OWNER:

CLIENT:




Arktech Solutions LLC.
10804 Inside Loop
Orlando, FL 32825
tel: (214) 606-5281
www.Arktech.org

FC NAME:	----
FCID:	N/A
FC ADDRESS:	----- ----- -----

FIELD SURVEYOR:	----
PROJECT DIRECTOR:	----
CHECKED BY:	RA
DATE COMPLETED:	4-9-2022

PROJECT NUMBER:	22906
SHEET:	AX002
DRAWING NUMBER:	09
OF:	9


DRAWING NAME:
EXTERIOR ELEVATIONS

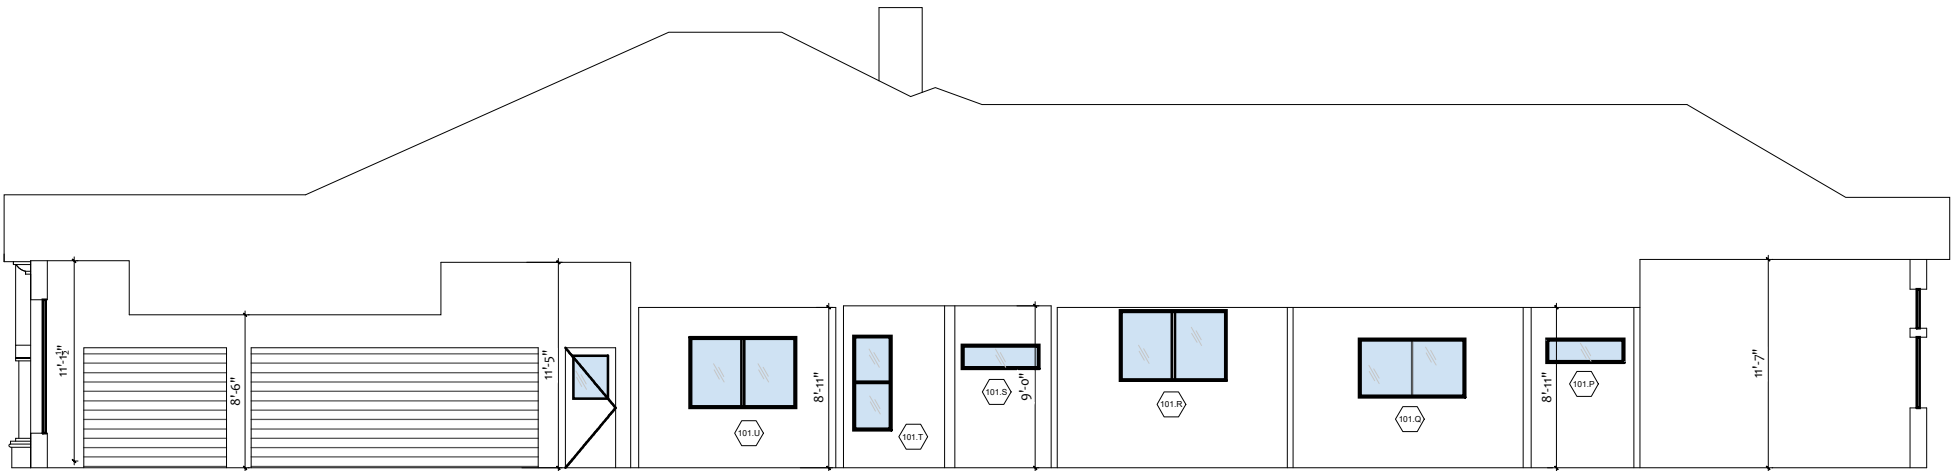

SECTION A

SCALE:
3/32"=1'-0"

1

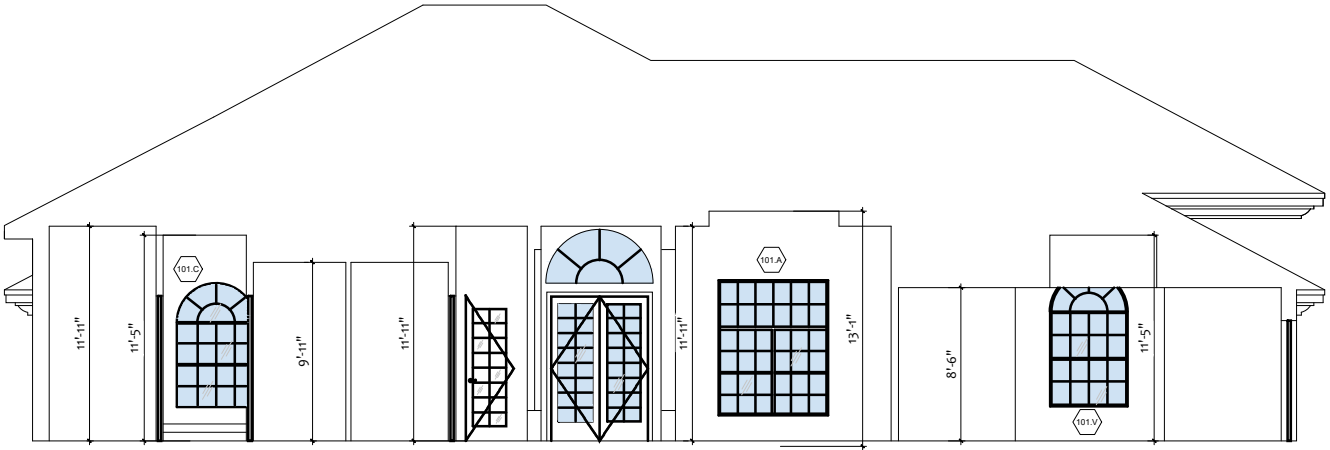

SECTION B

SCALE:
3/32"=1'-0"

2

OWNER:

CLIENT:



Arktech Solutions LLC.
10804 Inside Loop
Orlando, FL 32825
tel: (214) 606-5281
www.Arktech.org

FC NAME:	----
FCID:	N/A
FC ADDRESS:	----- ----- -----

FIELD SURVEYOR:	----
PROJECT DIRECTOR:	----
CHECKED BY:	RA
DATE COMPLETED:	4-9-2022

PROJECT NUMBER:	
22906	
SHEET:	
AX003	
DRAWING NUMBER:	OF:
09	9

DRAWING NAME:
SECTIONS